NOTES:
1. FOR GENERAL NOTES, REFERENCE DRAWINGS AND SYMBOLS SEE DRAWING 5TW2732-ED-1.

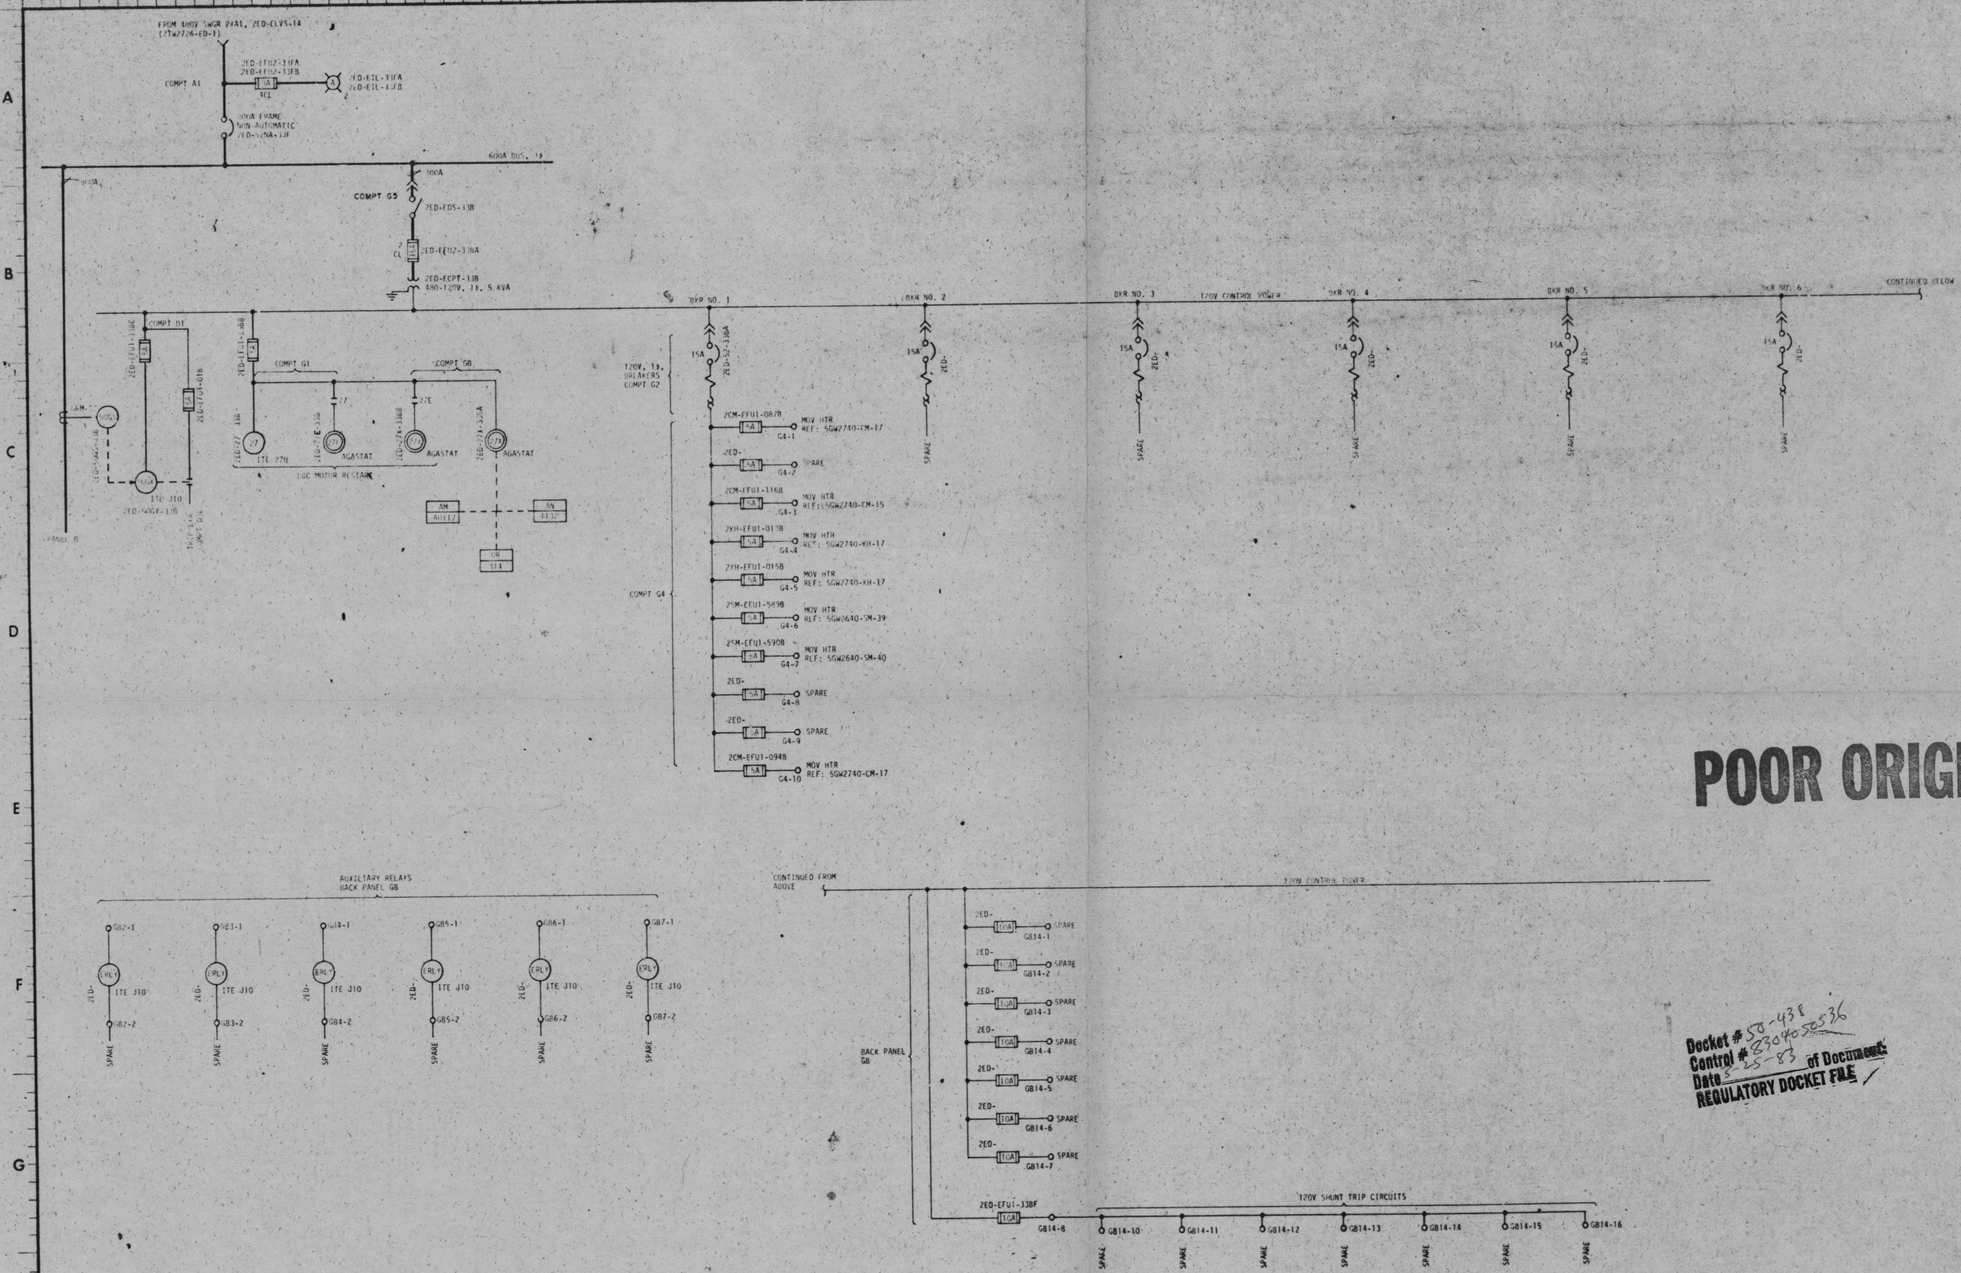

POOR ORIGINAL

PRC APERTURE CARD

Docket # 50-438
Control # 8304050536
Date 3-25-83 of Document
REGULATORY DOCKET FILE

REV NO	ECN NO	DATE	DSGN	DRWN	CHKD	SUPV	ENGR	INSP	SUBM	RECM	APPD

DSGN R.B. Thomas
DRWN J.R. Jackson
CHKD R.L. Pierce
SUPV W.A. Patton
INSP
ENGINEER R.M. Hodges

SCALE: NTS EXCEPT AS NOTED

TURBINE BUILDING
UNIT 2

SINGLE LINE
480V MCC 2A1
2ED-EMCC-33

BELLEFONTE NUCLEAR PLANT
TENNESSEE VALLEY AUTHORITY
DIVISION OF ENGINEERING DESIGN

N

SUBMITTED R.L. Pierce
RECOMMENDED
APPROVED R.M. Hodges

KNOXVILLE 7-3-82 88 E 5TW2732-ED-03 R0

RECORD DRAWING AS CONSTRUCTED

INSPECTED AND APPROVED FOR ISSUE

PRINT H V
SIZE F I