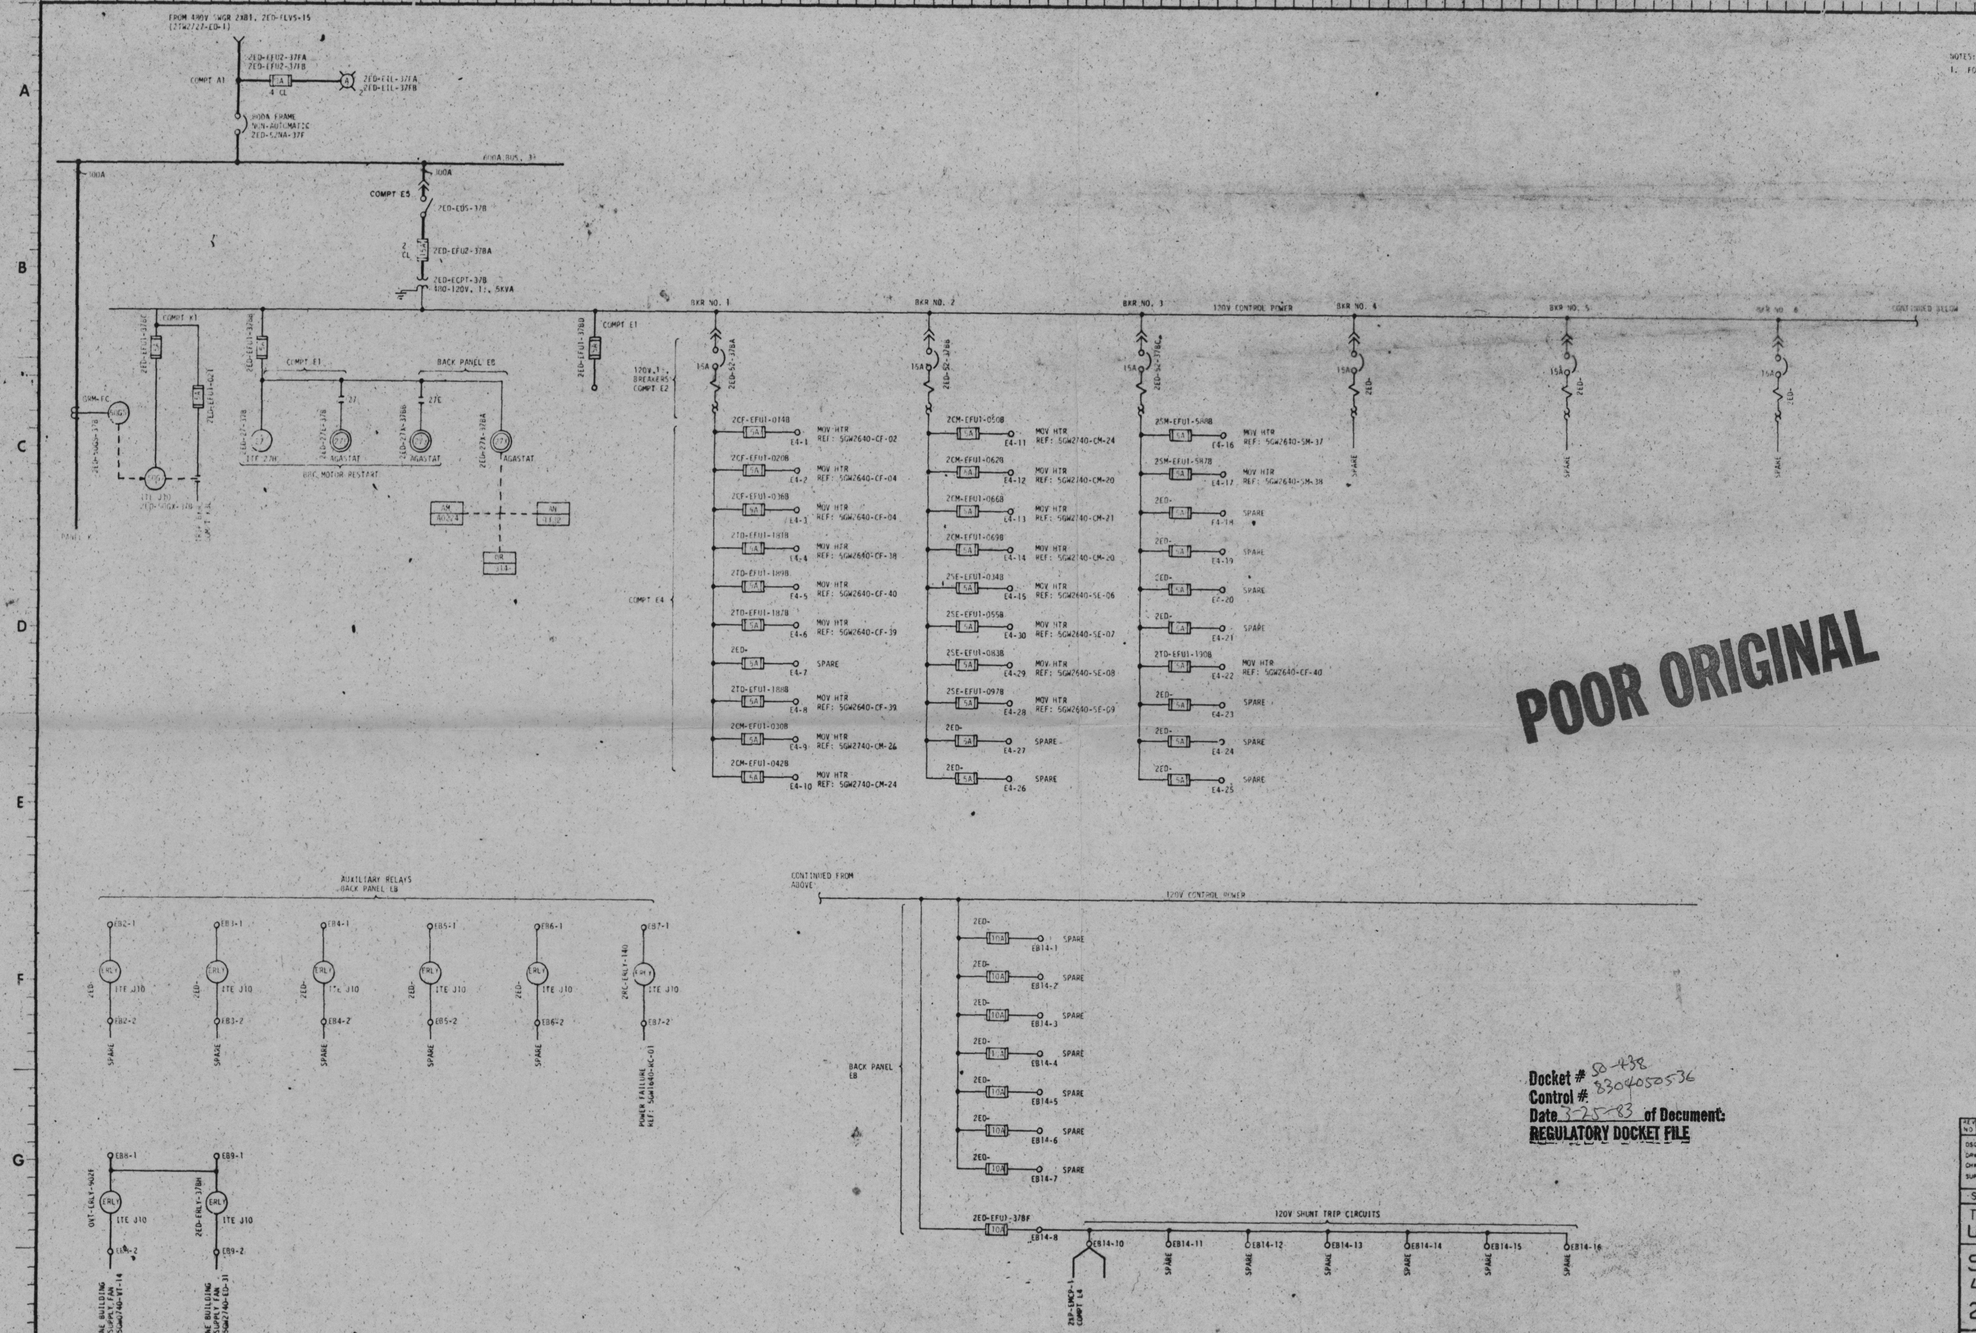


POOR ORIGINAL

Docket # 50-438
Control # 8304050536
Date 3-25-83 of Document:
REGULATORY DOCKET FILE

PRC APERTURE CARD

| REV NO | ECN NO | DATE | DSGN | DRWN | CHKD | SUPV | ENGR | INSP | S/MN | MECH | APPD |
|---|---|---|---|---|---|---|---|---|---|---|---|

DSGN R.E. Morgan
DRWN R.E. Morgan
CHKD T.E. Stevens
SUPV W.B. Jackson
INSP
ENGINEER

SCALE: NTS EXCEPT AS NOTED

TURBINE BUILDING
UNIT 2

SINGLE LINE
480V MCC 2B2
2ED-EMCC-37

BELLEFONTE NUCLEAR PLANT
TENNESSEE VALLEY AUTHORITY
DIVISION OF ENGINEERING DESIGN

N

SUBMITTED | RECOMMENDED | APPROVED

INSPECTED AND APPROVED FOR ISSUE

KNOXVILLE 9-3-82 | 88 | E | 5TW2735-ED-03 | R0

RECORD DRAWING AS CONSTRUCTED