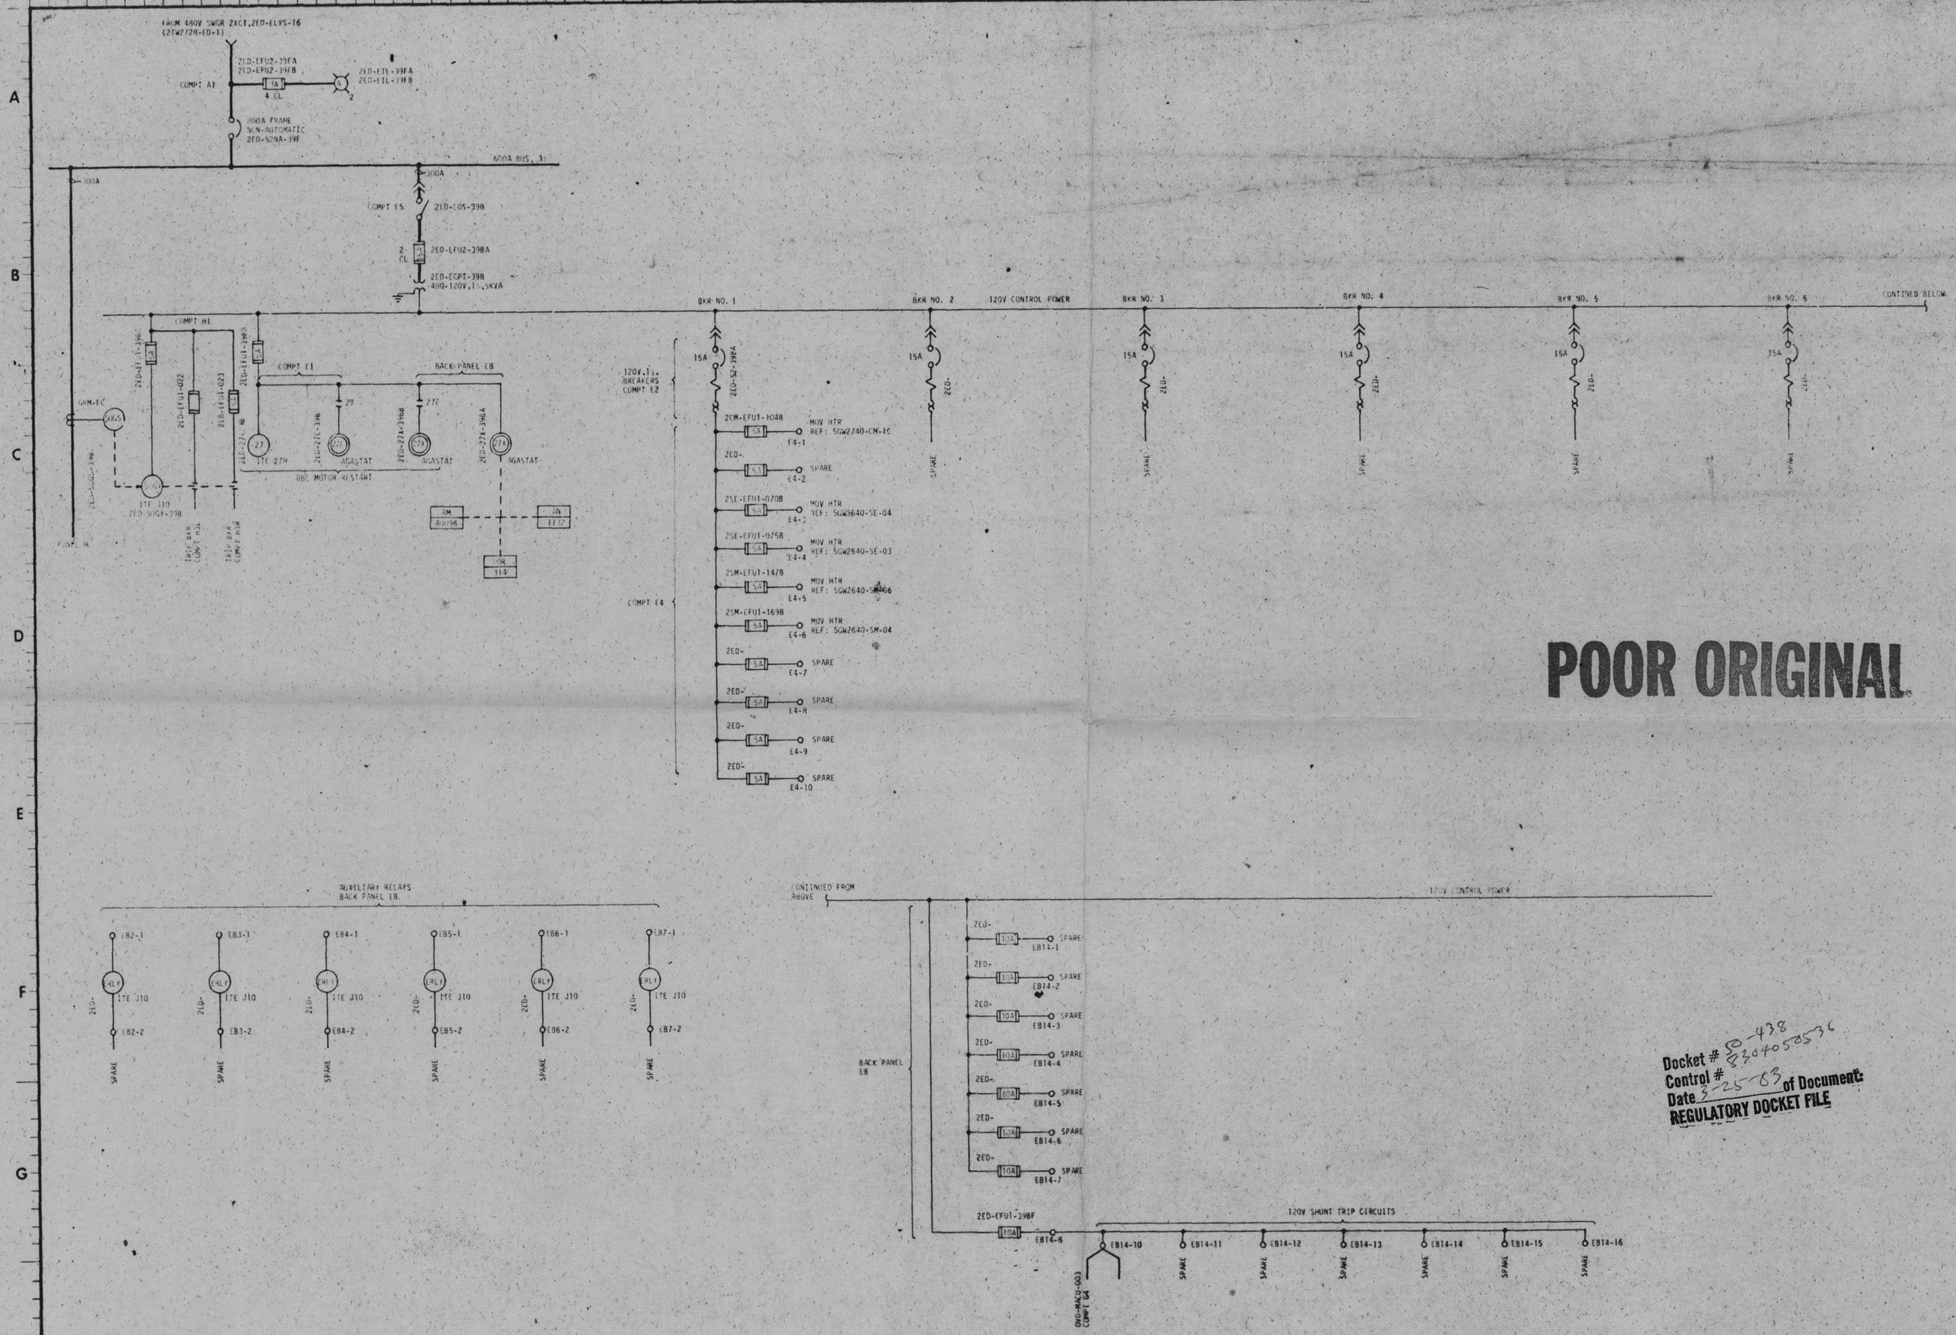

NOTES:
1. FOR GENERAL NOTES, REFERENCE DRAWINGS AND SYMBOLS SEE DWG. 5TW2736-ED-1.

POOR ORIGINAL

Docket # 50-438
Control # 8304050536
Date 3-25-83 of Document:
REGULATORY DOCKET FILE

PRC
APERTURE
CA

REV NO	ECN NO	DATE	DSGN	DRWN	CHKD	SUPV	ENGR	INSP	SUBM	RECM	APPD

DSGN B.E. Milligan
DRWN J.E. Jackson
CHKD T.A. Hayes
SUPV W.R. Dalton
INSP
ENGINEER

SCALE: NTS EXCEPT AS NOTED

TURBINE BUILDING
UNIT 2

SINGLE LINE
480V MCC 2C1
2ED-EMCC-39

BELLEFONTE NUCLEAR PLANT
TENNESSEE VALLEY AUTHORITY
DIVISION OF ENGINEERING DESIGN

N

SUBMITTED	RECOMMENDED	APPROVED

KNOXVILLE 9-3-82 | 00 | E | 5TW2736-ED-03 | R0

RECORD DRAWING AS CONSTRUCTED

INSPECTED AND APPROVED FOR ISSUE

PRINT H 3
SIZE F 9