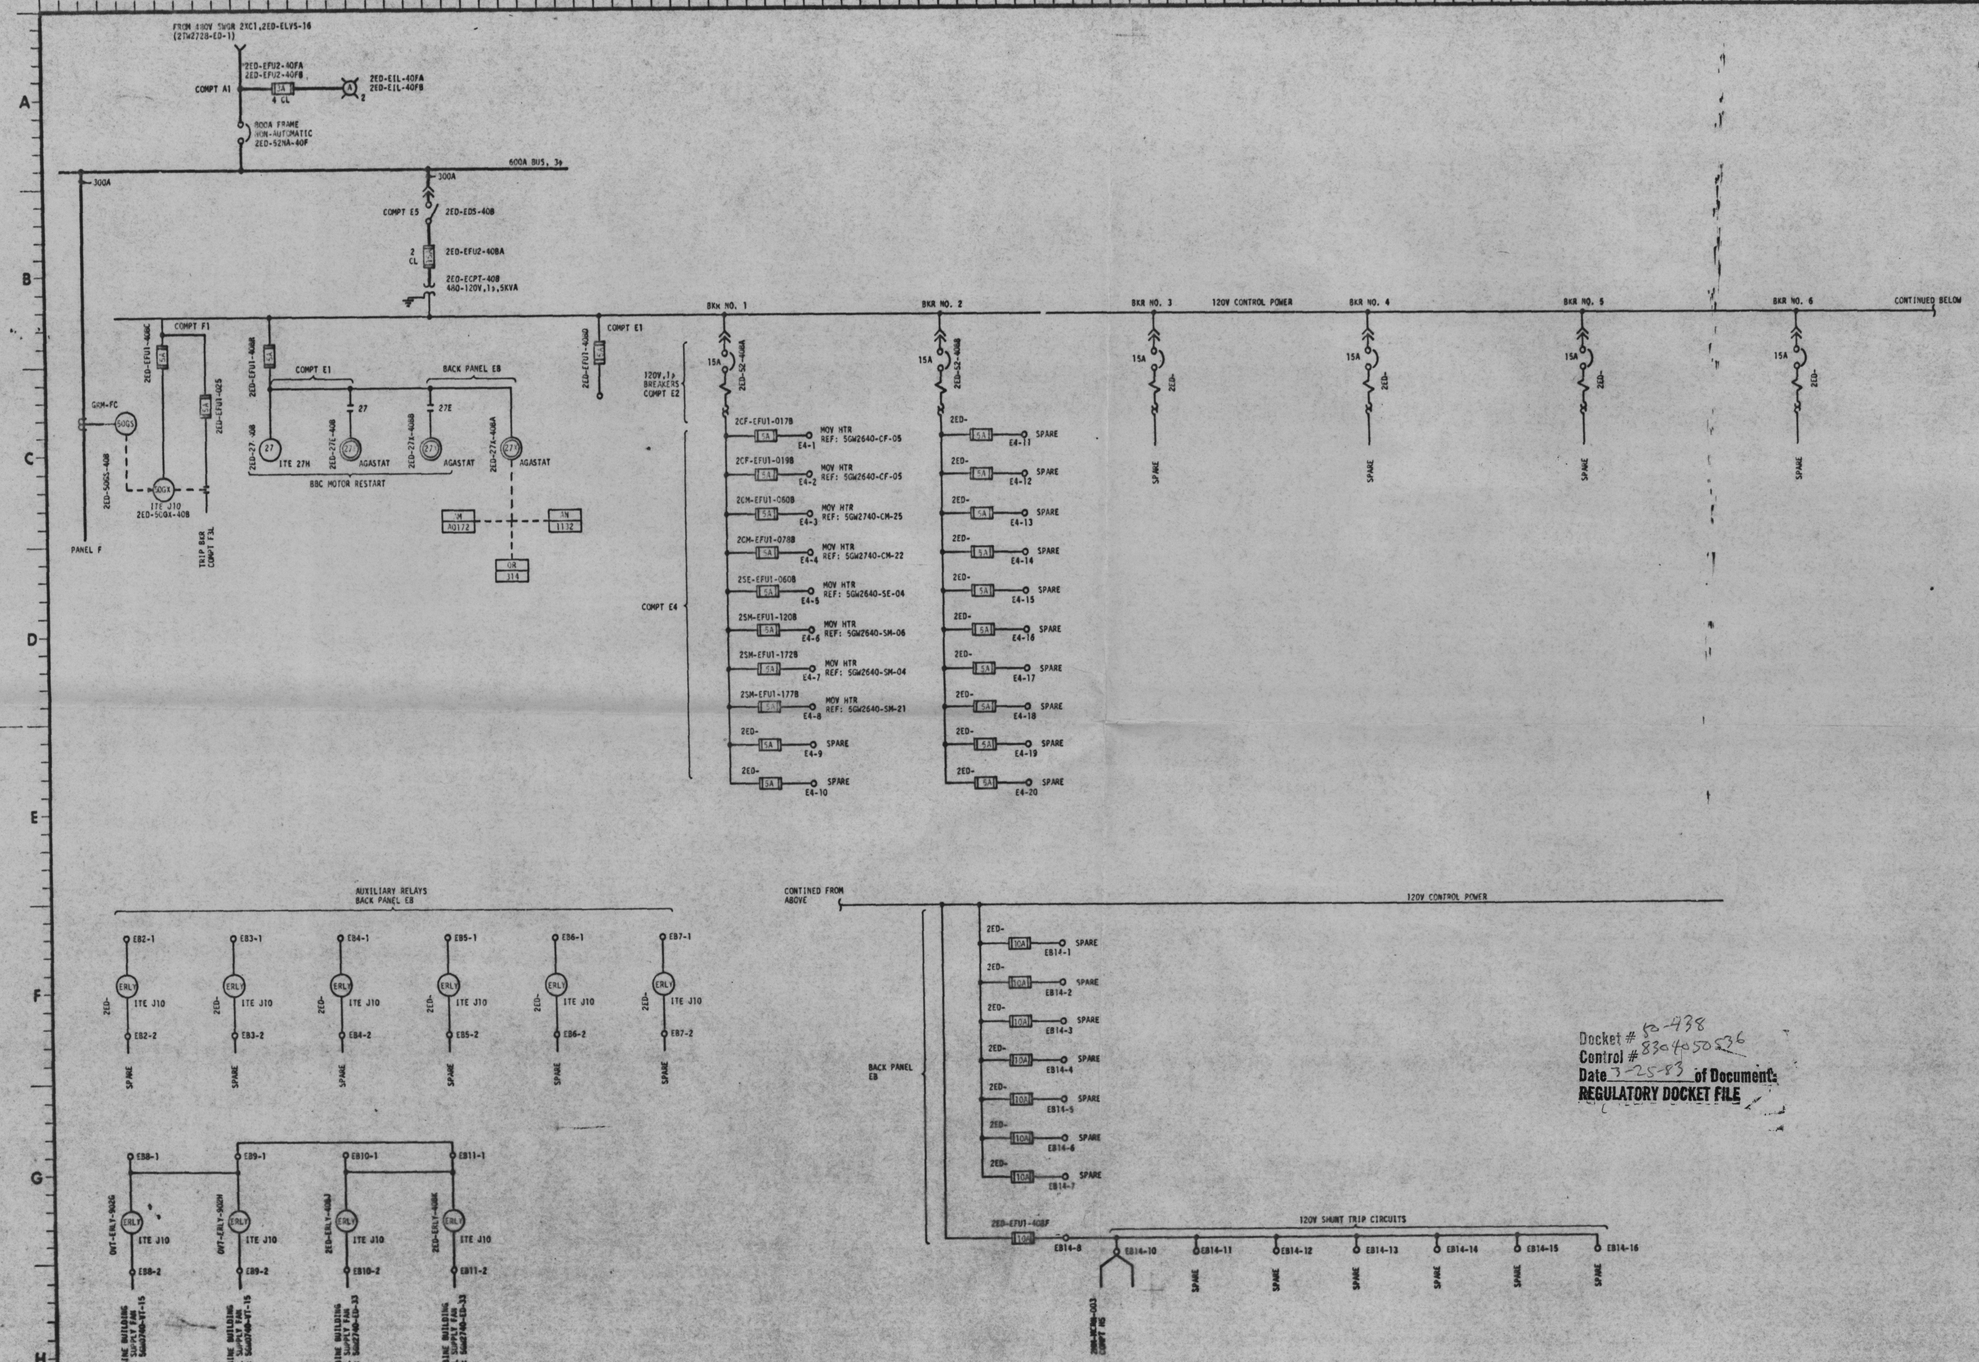

NOTES:
1. FOR GENERAL NOTES, REFERENCE DRAWINGS AND SYMBOLS SEE DWG 5TW2737-ED-1.

Docket # 50-438
Control # 8304050536
Date 3-25-83 of Document:
REGULATORY DOCKET FILE

PRC APERTURE CARD

REV NO.	ECN NO.	DATE	DSGN	DRWN	CHKD	SUPV	ENGR	INSP	SUBM	RECM	APPD

DSGN Bey E. McMorgan
DRWN [illegible]
CHKD [illegible]
SUPV [illegible]
INSP
ENGINEER [illegible]

SCALE: NTS EXCEPT AS NOTED

TURBINE BUILDING
UNIT 2

SINGLE LINE
480V MCC 2C2
2ED-EMCC-40

BELLEFONTE NUCLEAR PLANT
TENNESSEE VALLEY AUTHORITY
DIVISION OF ENGINEERING DESIGN

N

SUBMITTED [illegible] RECOMMENDED [illegible] APPROVED R.M. Holmes

KNOXVILLE 9-3-83 80 E 5TW2737-ED-03 R0

RECORD DRAWING AS CONSTRUCTED

INSPECTED AND APPROVED FOR ISSUE

PRINT
SIZE