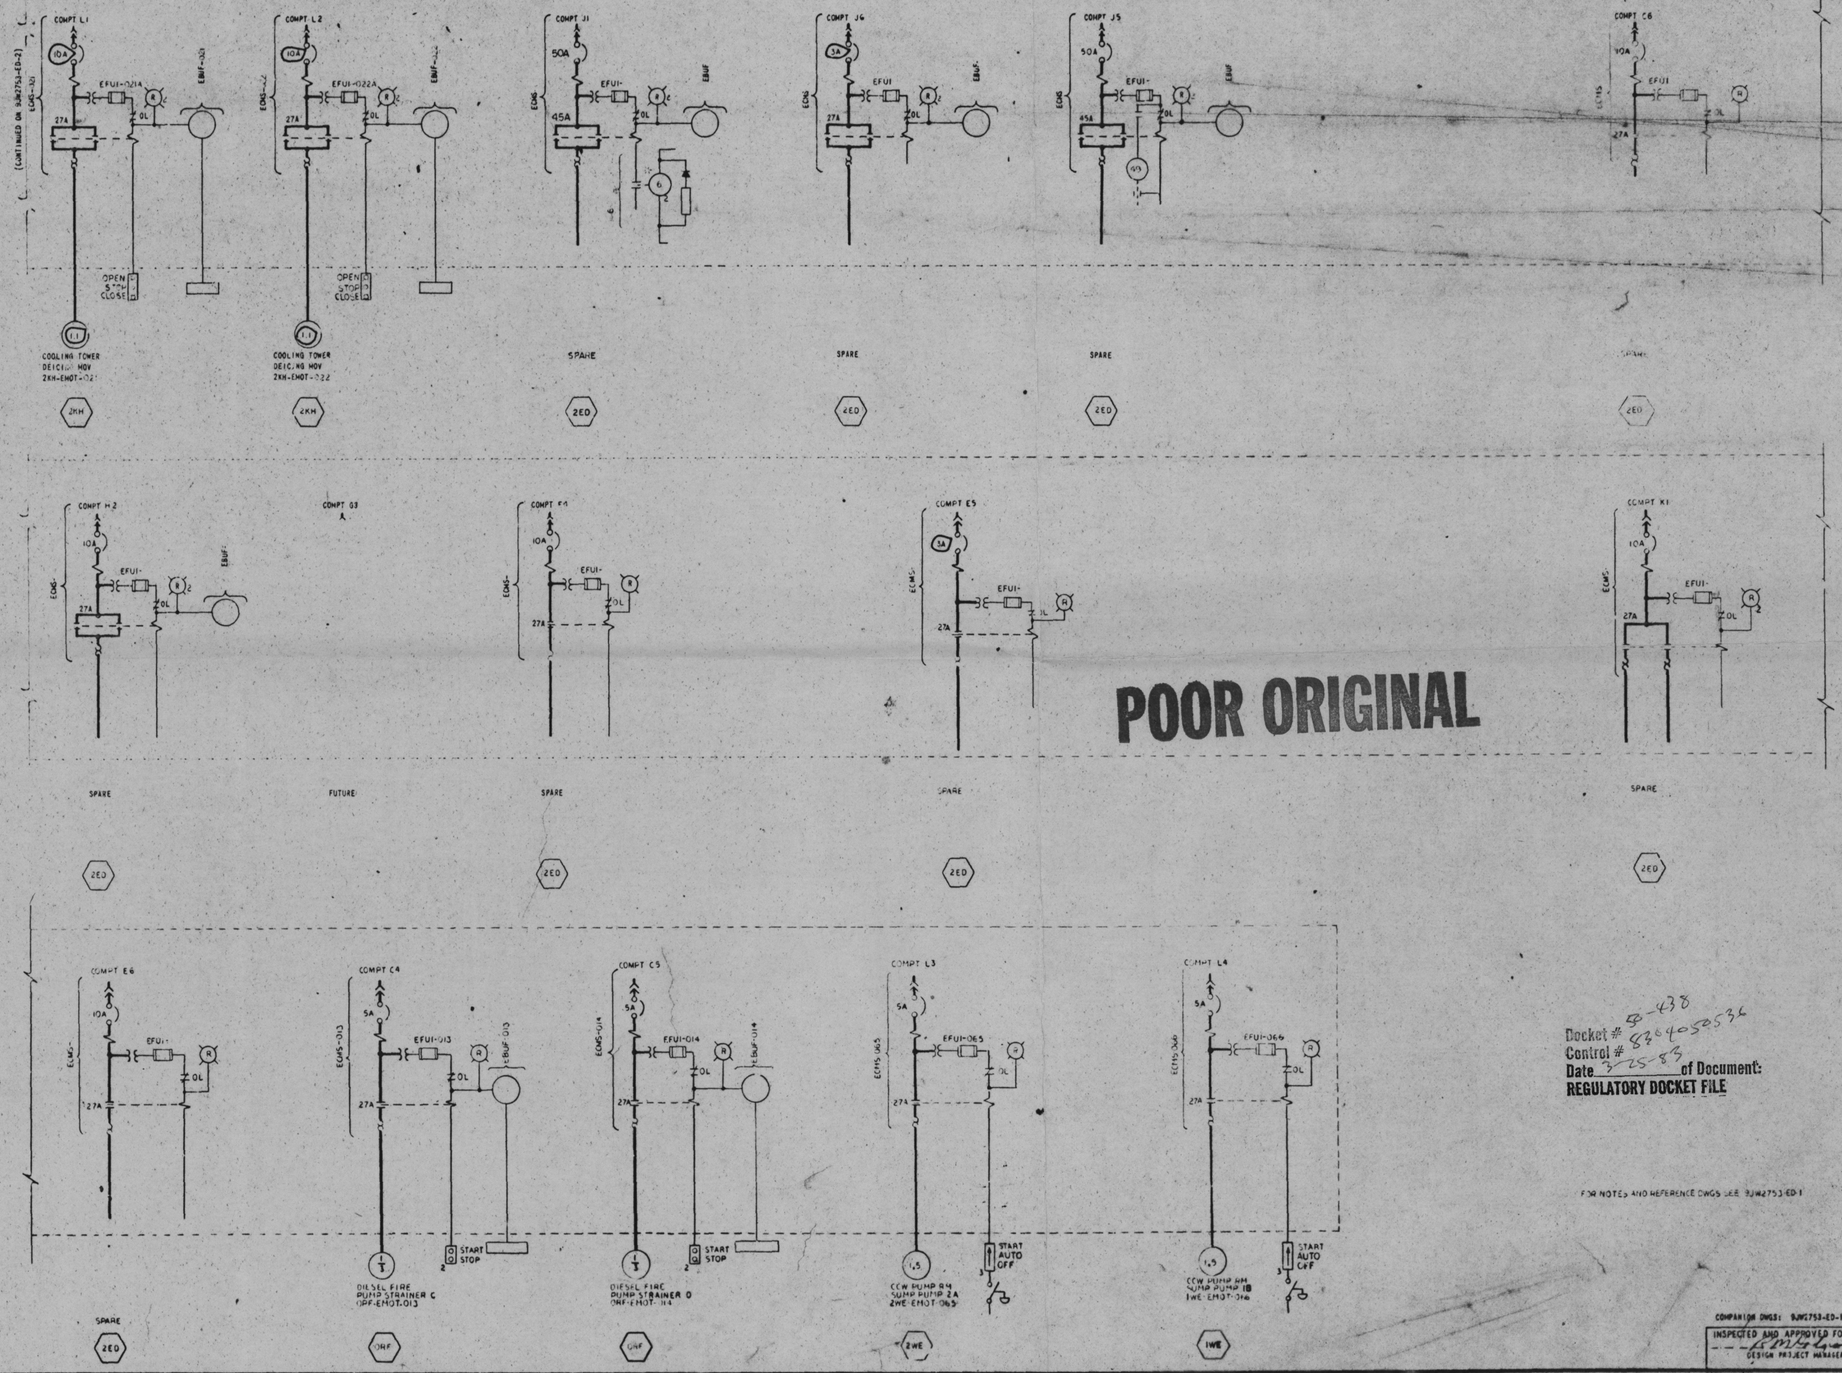

POOR ORIGINAL

PRC APERTURE CARD

5	1069													
ECN 969-EXCHANGED 480V CKT BKRS AND CHANGED MOV HORSEPOWER														
4	1591													
ECN 591 CHANGED CKT BKR AND MOTOR STARTER														
3	1425,51													
ECN 425-DELETED CT BLWDN HOLD UP MOV. ECN 51-VARIOUS MINOR CHANGES.														
2	137													
ECN 51-MINOR CHGS TO CONFORM TO MCC DESIGN CHGS & V MFRR														
1	95,51,134													
ADDED INTERPOSING RELAYS PER ECN-95. INCORPORATED UNIT 2 SYS GEN REV PER ECN-51, VARIOUS. INCORPORATED LOAD CHGS PER ECN 134														
REV NO.	ECN NO.	DATE	DSGN	DRWN	CHKD	SUPV	ENGR	INSP	SUBM	RECM	APPR			

DSGN - H.J. PATTISON
DRWN - R. SCHOEBE
CHKD - J.E. BLANKENSHIP
SUPV - J.E. BLANKENSHIP
INSP
ENGINEER

CCW PUMPING STATION
UNIT 2

SINGLE LINE
480V MCC SXC2
2ED-EMCC-77

BELLEFONTE NUCLEAR PLANT
TENNESSEE VALLEY AUTHORITY
DIVISION OF ENGINEERING DESIGN

N

SUBMITTED	RECOMMENDED	APPROVED

KNOXVILLE 12-20-74 | 88 | E | 9JW2753-ED-3 | 85

RECORD DRAWING AS CONSTRUCTED

Docket # 50-438
Control # 8304050536
Date 3-25-83 of Document:
REGULATORY DOCKET FILE

FOR NOTES AND REFERENCE DWGS SEE 9JW2753-ED-1

COMPANION DWGS: 9JW2753-ED-1,2

INSPECTED AND APPROVED FOR ISSUE
DESIGN PROJECT MANAGER

PRINTS REQD-P 2
BR of PROJ

DWG	SIZE	P	R
MC			
CC			
CE			
AD			
CD			
ED			
HD			
BF			
SW			
BL			
PA			