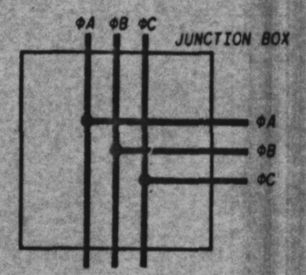

DETAIL 1

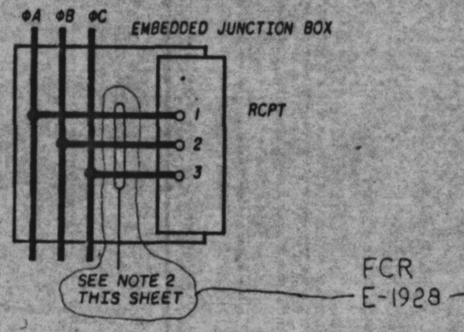

DETAIL 2

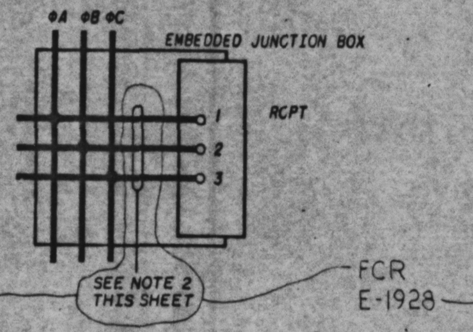

DETAIL 3

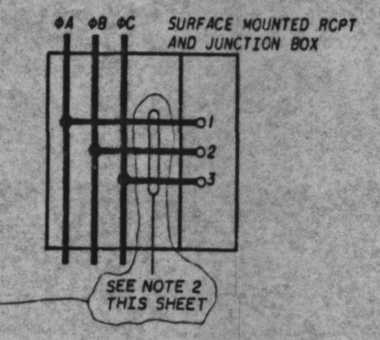

DETAIL 4

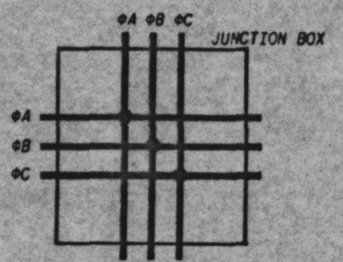

DETAIL 5

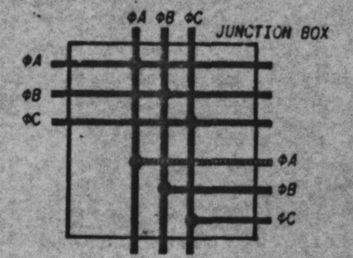

DETAIL 6

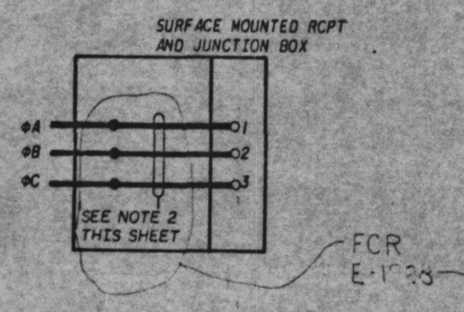

DETAIL 15

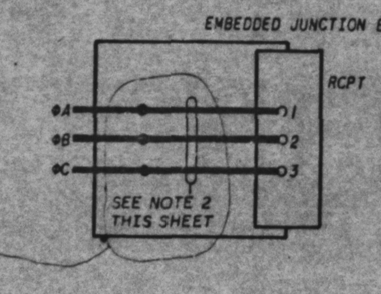

DETAIL 16

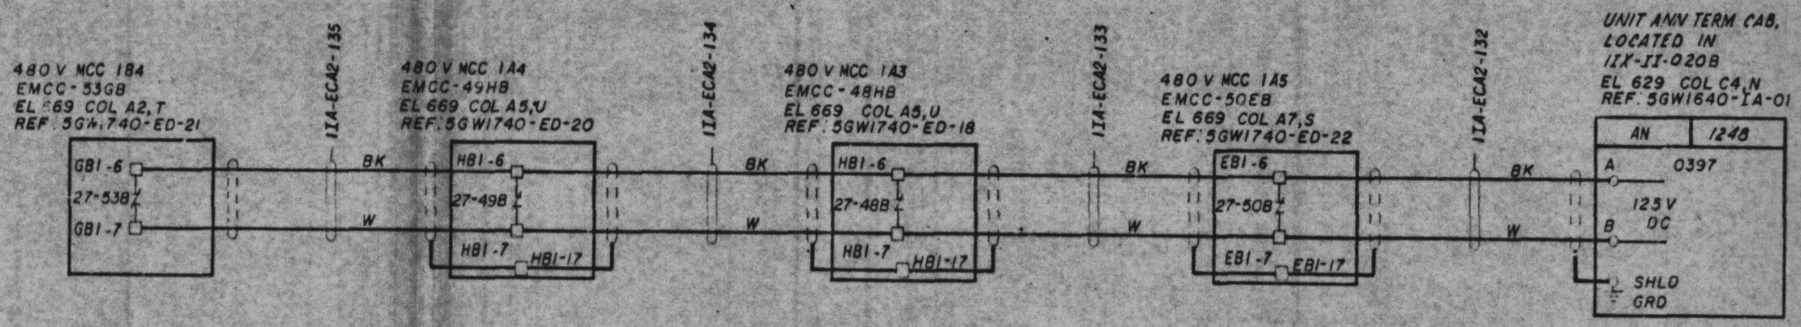

MCC LOSS OF VOLTAGE

DETAIL 7

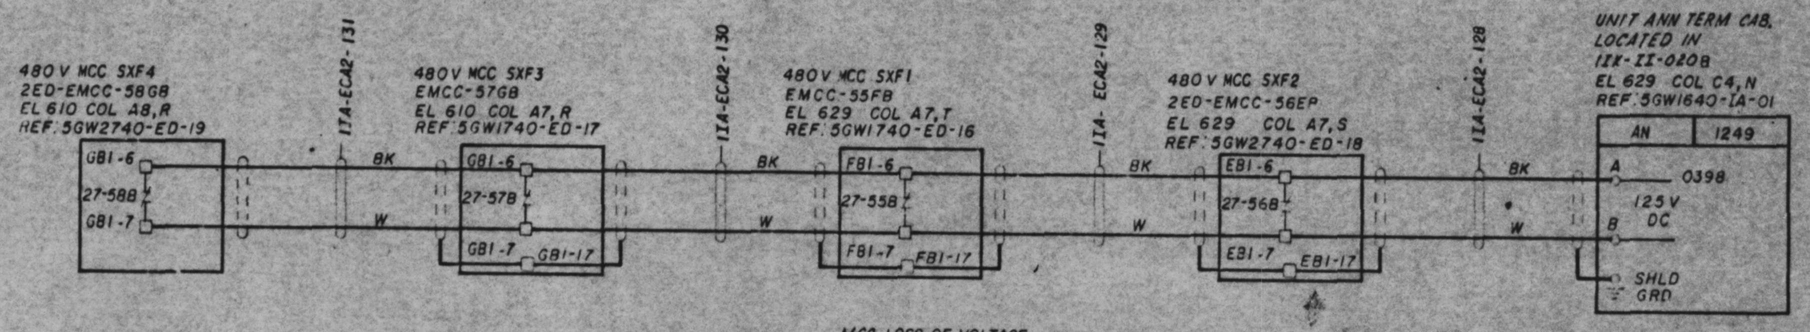

MCC LOSS OF VOLTAGE

DETAIL 8

NOTES:

1. FOR GENERAL NOTES AND SYMBOLS SEE DWG 5GW1740-ED-01.
2. 60 AMP POWER RECEPTACLE CONNECTOR PIGTAILS MAY BE REDUCED TO A MINIMUM OF 4 AWG IF REQUIRED.

FCR E-1928

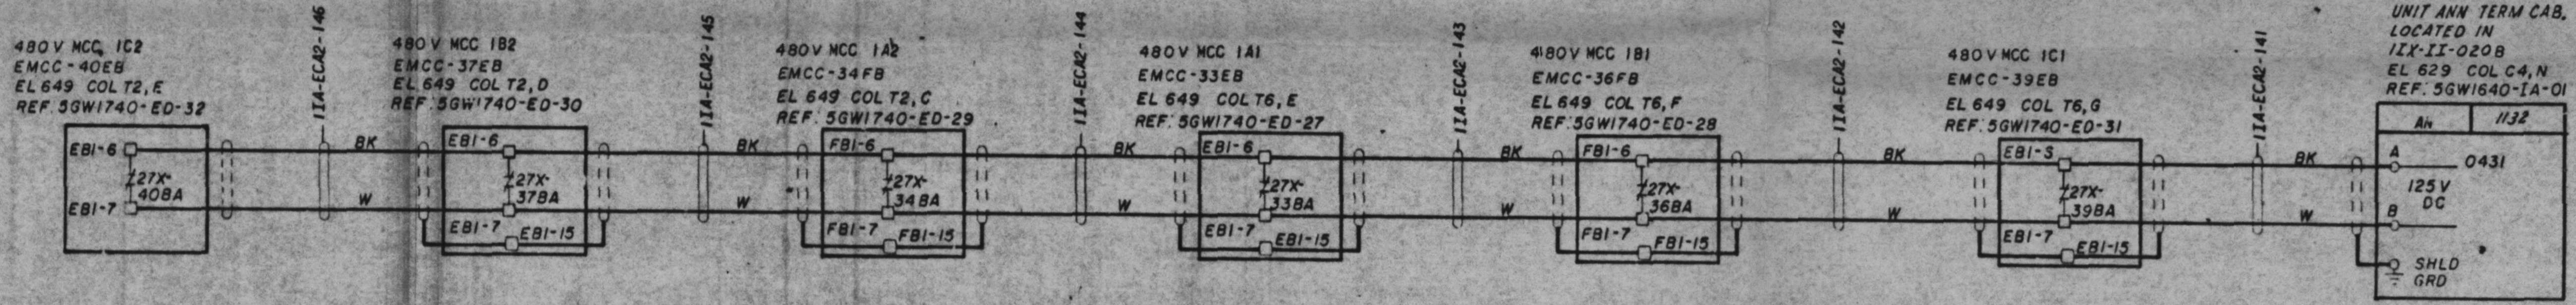

MCC LOSS OF VOLTAGE

DETAIL 9

Docket # 50-438
Control # 8304050536
Date 3-25-83 of Document:
REGULATORY DOCKET FILE

PRC APERTURE CARD

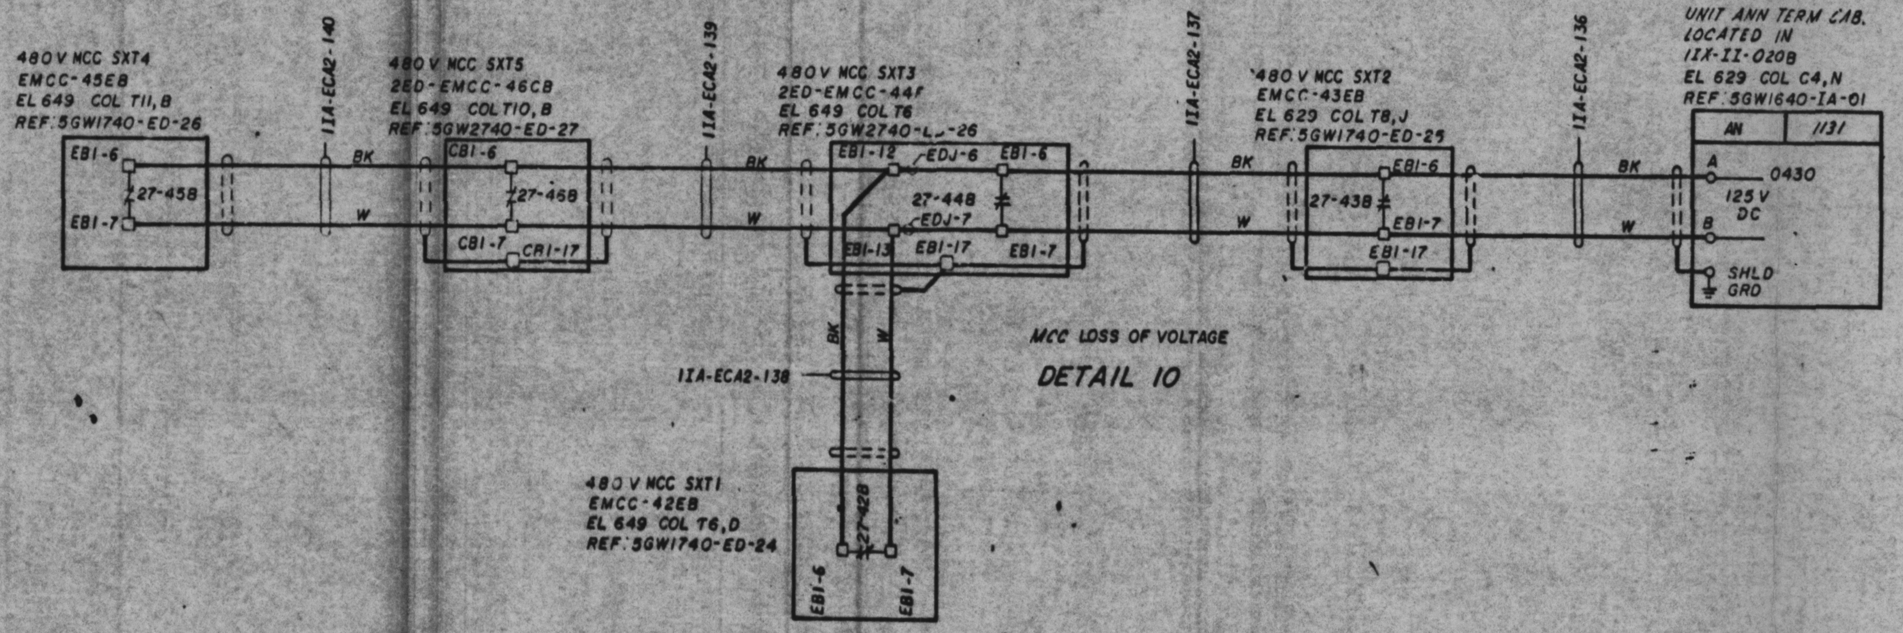

MCC LOSS OF VOLTAGE

DETAIL 10

REV NO.	ECN NO.	DATE	DSGN	DRWN	CHKD	SUPV	ENGR	INSP	SUBM	RECM	APPD
2	SI	[illegible]	[illegible]	[illegible]	[illegible]	[illegible]	[illegible]		[illegible]	JLS	[illegible]
INCORPORATED FCR E-1928.											
1	SI	4-26-79	[illegible]	[illegible]	[illegible]	[illegible]	[illegible]	–	[illegible]	JLS	[illegible]
REMOVED WIRE SIZES FROM JUNCTION BOX & RCPT DETAILS, CHANGED UNDERVOLTAGE TO LOSS OF VOLTAGE, & ADD'L'D REF DWG SH NO.											

DSGN [illegible]
DRWN [illegible]
CHKD [illegible]
SUPV [illegible]
INSP
ENGINEER W L Aldredge

SCALE: EXCEPT AS NOTED

GENERAL
UNITS 1&2

SYSTEM SCHEMATIC
480V NORMAL AC
AUX POWER DISTRIBUTION SYSTEM

BELLEFONTE NUCLEAR PLANT
TENNESSEE VALLEY AUTHORITY
DIVISION OF ENGINEERING DESIGN
N

SUBMITTED	RECOMMENDED	APPROVED
W L Aldredge	[illegible]	[illegible]

INSPECTED AND APPROVED FOR ISSUE

KNOXVILLE 6-16-78 88 E 5GW1740-ED-33 R2

RECORD DRAWING AS CONSTRUCTED

PRINT
SIZE