


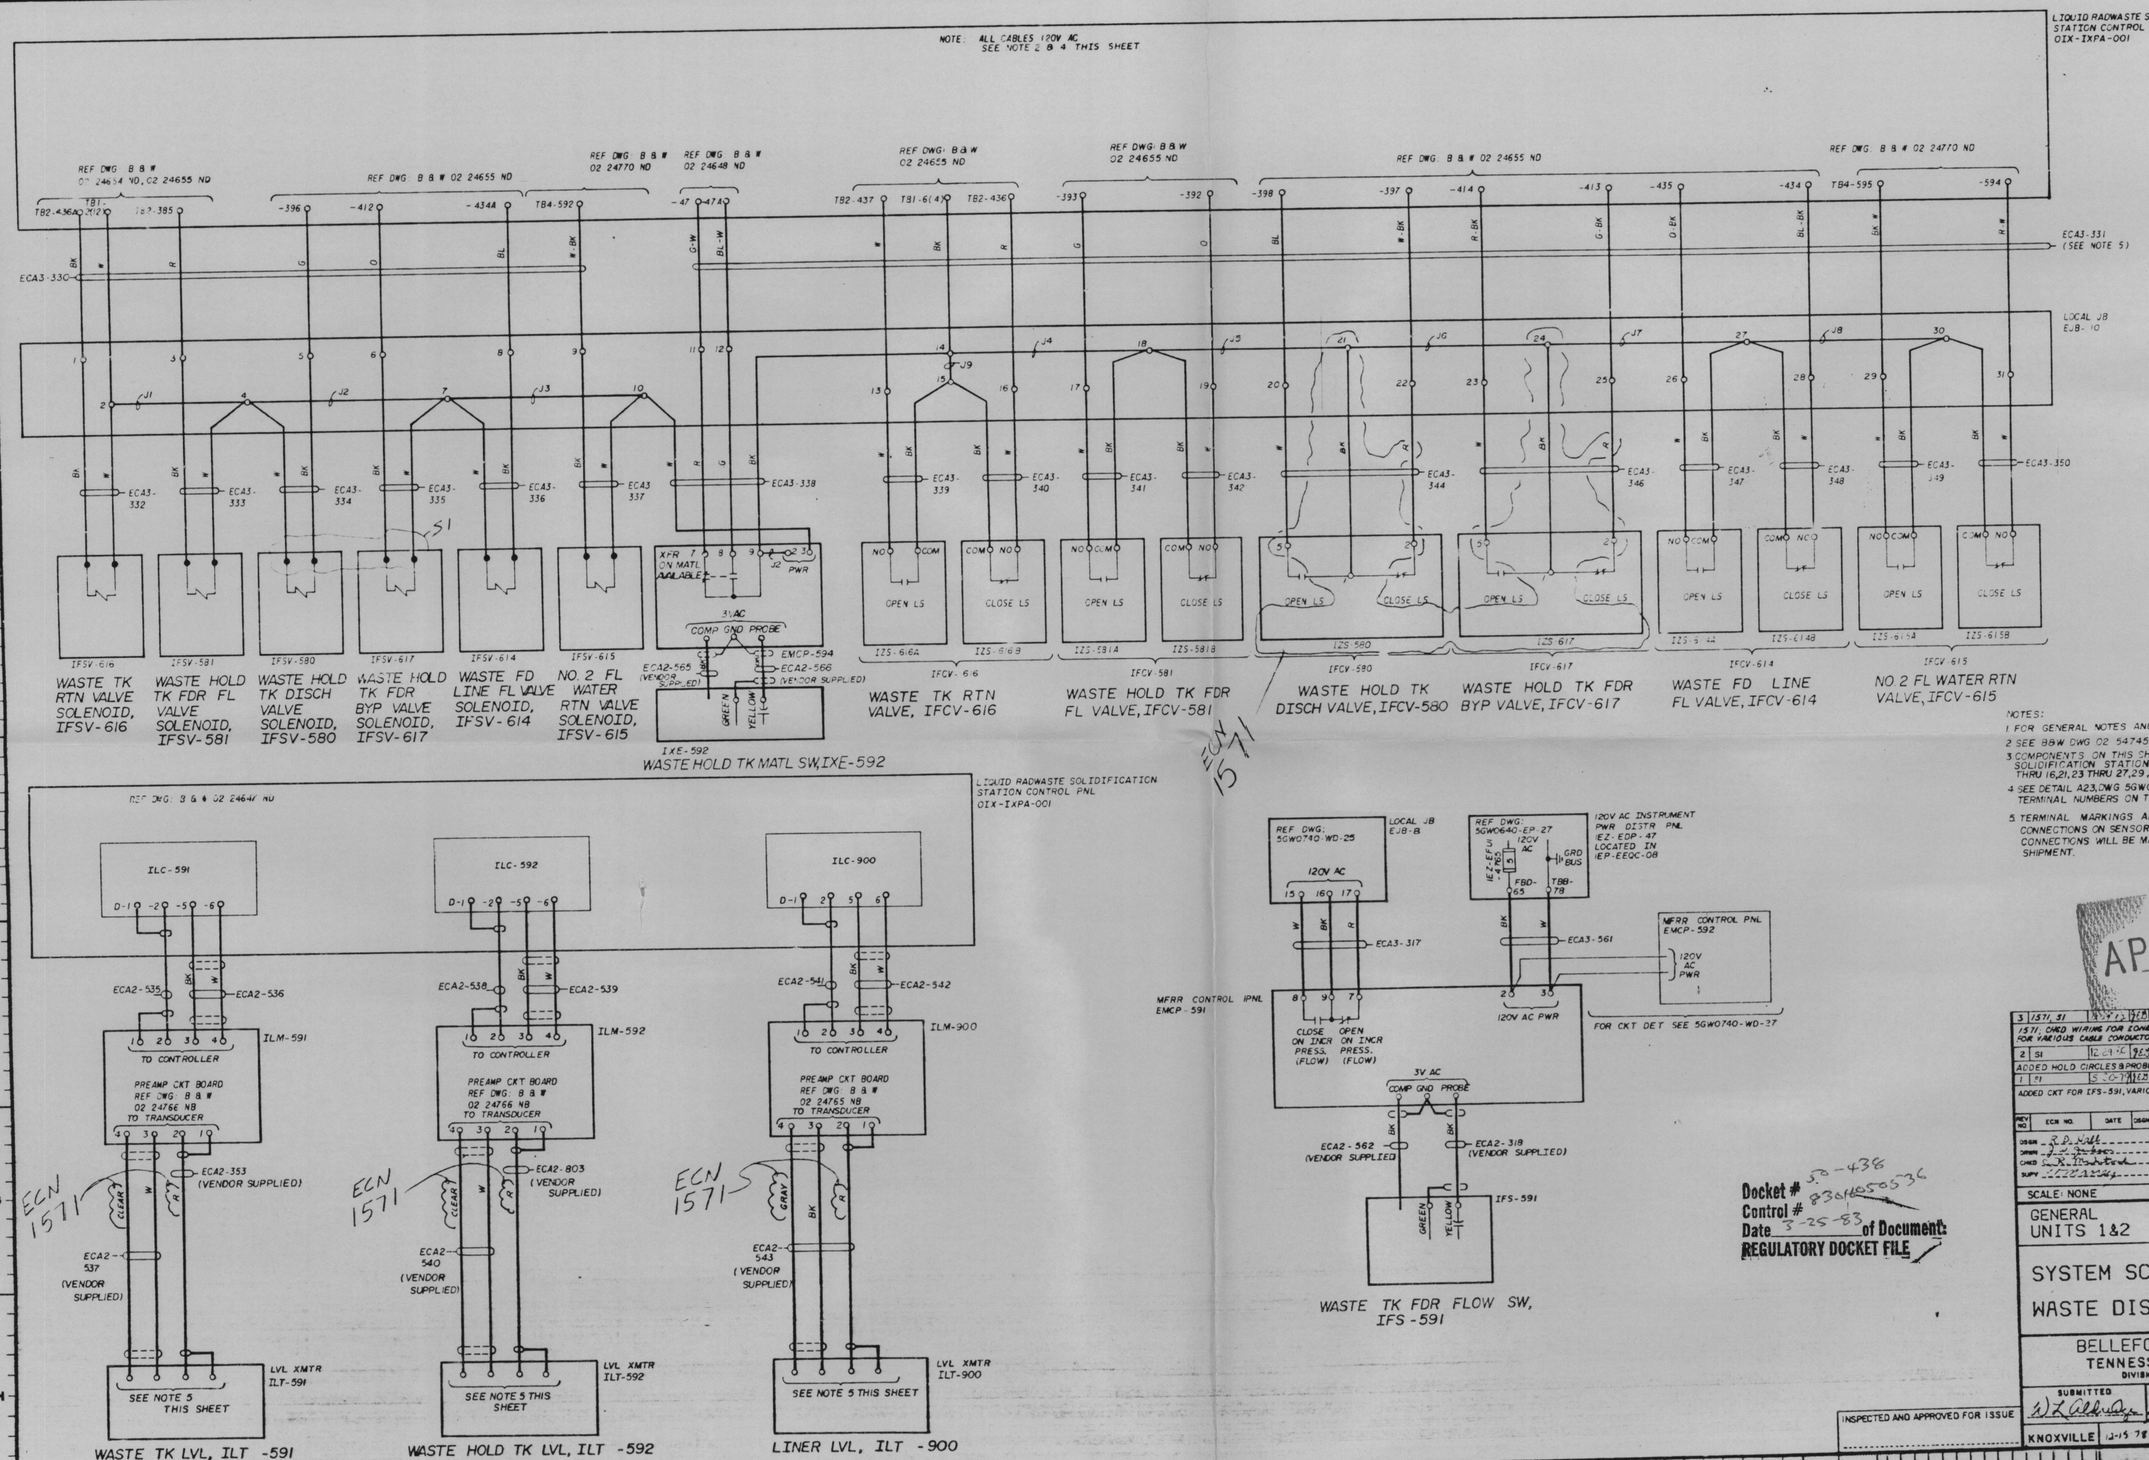





NOTES:

1 FOR GENERAL NOTES AND SYMBOLS, SEE 5GW0740-WD-01

2 SEE B&W DWG 02 54745 NF FOR TERMINATION INFORMATION.

3 COMPONENTS ON THIS SHEET ARE OF THE LIQUID RADWASTE SOLIDIFICATION STATION PACKAGE SHOWN ON SH 02,03,11 THRU 16,21,23 THRU 27,29,30.

4 SEE DETAIL A23, DWG 5GW0740-WD-23 FOR EXPLANATION OF TERMINAL NUMBERS ON TBI WHICH INCLUDE PARENTHESIS.

5 TERMINAL MARKINGS ARE NOT SHOWN FOR THE CABLE CONNECTIONS ON SENSORS OWL-ILT-591,-592 & 900. THE CONNECTIONS WILL BE MADE BY THE VENDOR PRIOR TO SHIPMENT.

PRC APERTURE CARD

| REV NO. | ECN NO. | DATE | DSGN | DRWN | CHKD | SUPV | ENGR | INSP | SUBM | RECM | APPD |
|---|---|---|---|---|---|---|---|---|---|---|---|
| 3 | 1571, S1 | | | | | | | | | | |
| 2 | S1 | | | | | | | | | | |
| 1 | S1 | | | | | | | | | | |

3 | 1571, S1 | CHKD WIRING FOR ZONE SWITCHES FOR IFCV-580 & -617. CHKD COLOR CODE FOR VARIOUS CABLE CONDUCTORS; 3-1, REMOVED HOLD.
2 | S1 | ADDED HOLD CIRCLES & PROBE TO WASTE HOLD TK MATL SW & MADE MINOR CHANGES
1 | S1 | ADDED CKT FOR IFS-591, VARIOUS TERM. NO., JUMPER NO. AND MINOR CHANGES.

DSGN R.D. Hill
DRWN
CHKD
SUPV
INSP
ENGINEER W.L. Oldridge

SCALE: NONE — EXCEPT AS NOTED

GENERAL
UNITS 1&2

SYSTEM SCHEMATIC
WASTE DISPOSAL SYSTEM

BELLEFONTE NUCLEAR PLANT
TENNESSEE VALLEY AUTHORITY
DIVISION OF ENGINEERING DESIGN

N

SUBMITTED W.L. Oldridge | RECOMMENDED | APPROVED R.M. Hodges

KNOXVILLE 12-15-78 | 88 | E | 5GW0740-WD-26 R3

RECORD DRAWING AS CONSTRUCTED

INSPECTED AND APPROVED FOR ISSUE

Docket # 50-438 50-439
Control # 8304050536
Date 3-25-83 of Document:
REGULATORY DOCKET FILE