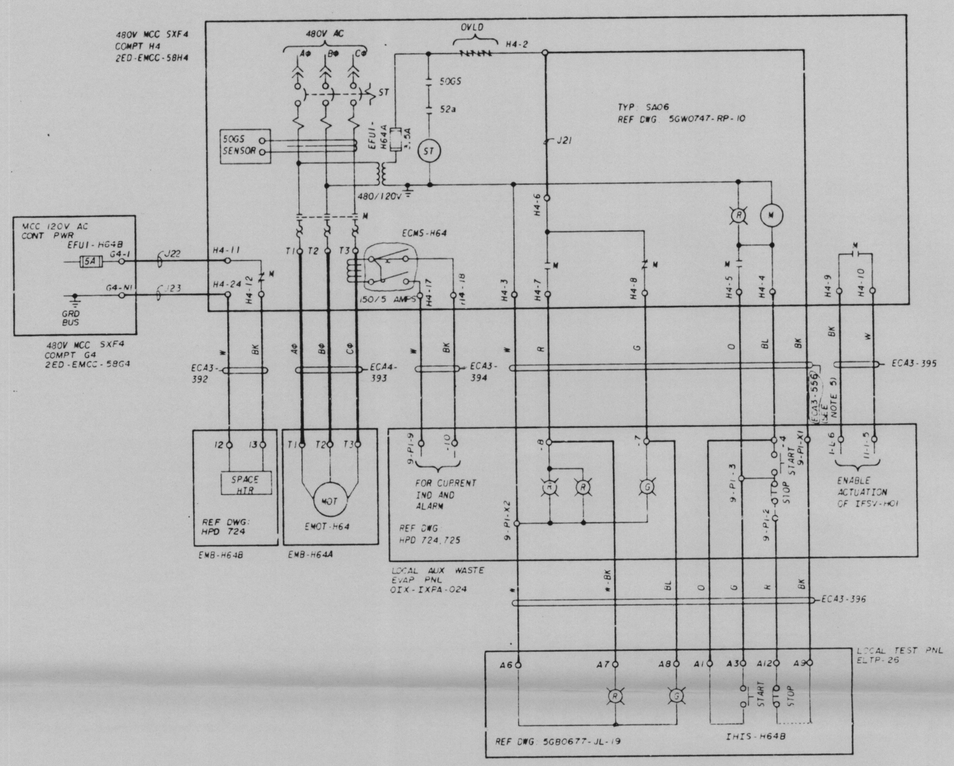

AUX WASTE EVAP MEVP-039 RECIRCULATION PUMP, MPMP-H64
(SEE NOTE 3 THIS SHEET)

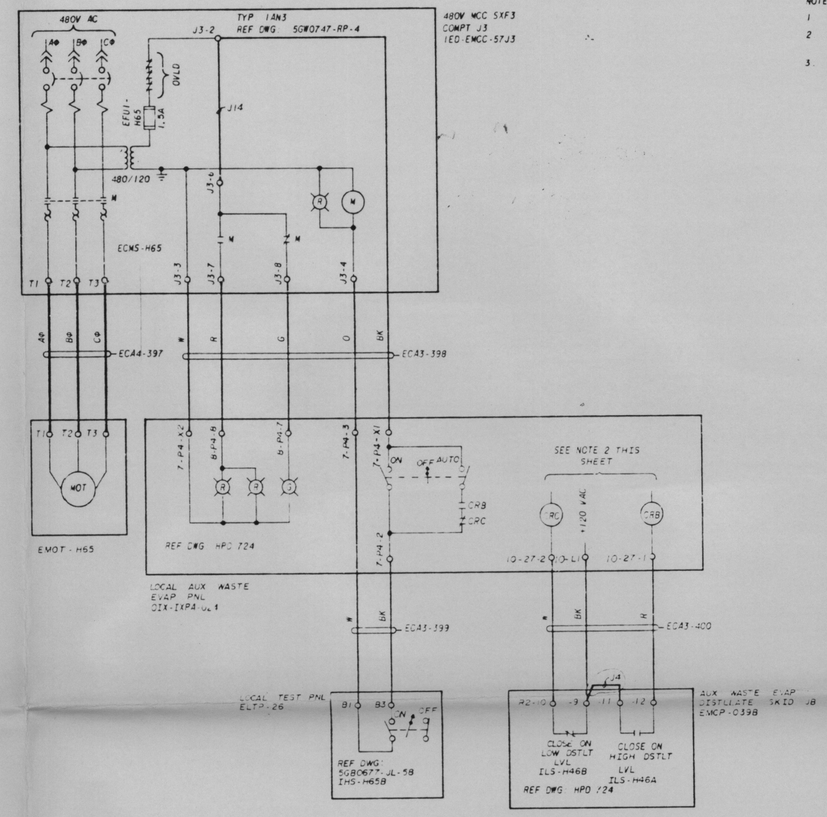

AUX WASTE EVAP MEVP-039 DISTILLATE PUMP, MPMP-H65
(SEE NOTE 3 THIS SHEET)

NOTES:

1. FOR GENERAL NOTES AND SYMBOLS, SEE 5GW0740-WD-01
2. RELAYS CRB AND CRC ARE SHOWN ON HPD DWG 724 AND ARE SHOWN ON THIS DWG ONLY FOR CLARITY
3. THE AUX WASTE EVAP PACKAGE MEVP-039 IS SHOWN ON SHEETS 28 THRU 34

PRC
APERTURE
CARD

Docket # 50-438
Control # 8304050536
Date 3-25-83 of Document:
REGULATORY DOCKET FILE

REV NO.	ECN NO.	DATE	DSGN	DRWN	CHKD	SUPV	ENGR	NSP	SUBM	RECM	APPD
1	S1	6-30-79									

ADDED TERM NO., REF DWG NO. & MINOR CHANGES.

DSGN 3-9-78
DRWN
CHKD
SUPV
INSP
ENGINEER W L Aldredge

SCALE: NONE — EXCEPT AS NOTED

GENERAL
UNITS 1 & 2

SYSTEM SCHEMATIC
WASTE DISPOSAL SYSTEM

BELLEFONTE NUCLEAR PLANT
TENNESSEE VALLEY AUTHORITY
DIVISION OF ENGINEERING DESIGN

N

SUBMITTED	RECOMMENDED	APPROVED
W L Aldredge		R M Hodges

KNOXVILLE 12-15-78 | 88 | E | 5GW0740-WD-28 R1

RECORD DRAWING AS CONSTRUCTED

INSPECTED AND APPROVED FOR ISSUE

PRINT H 3
SIZE F 0