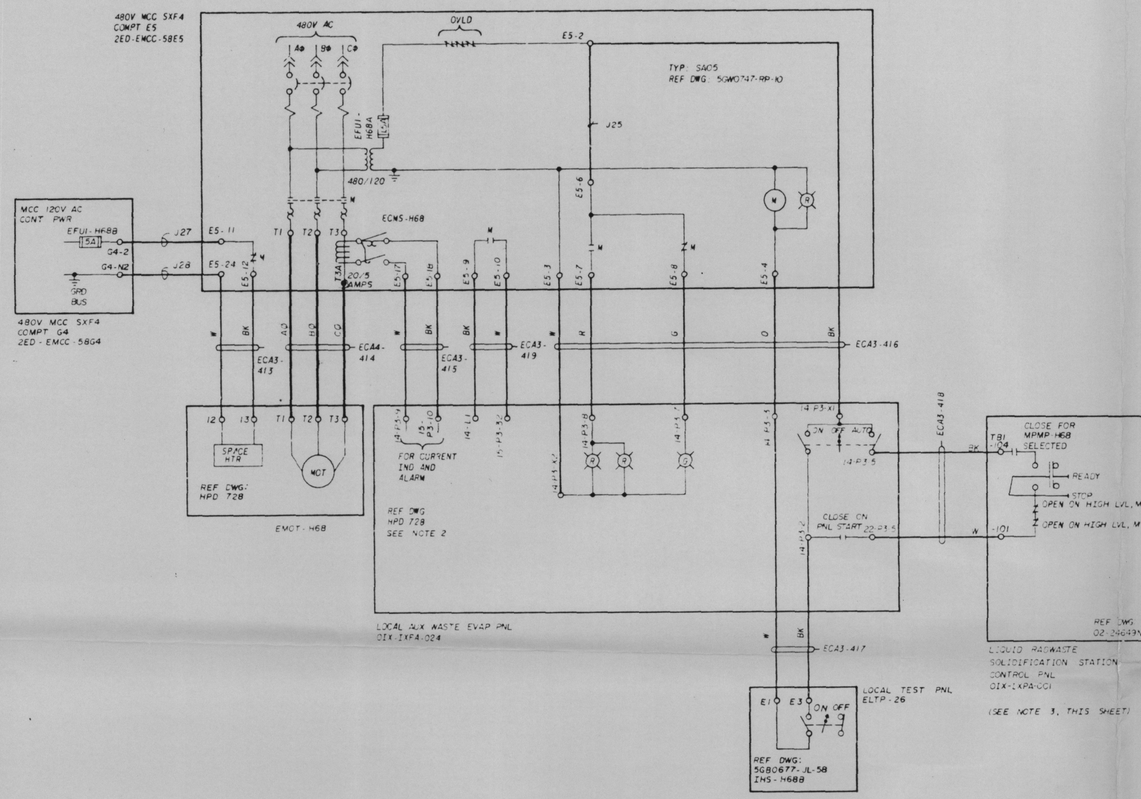

AUX WASTE EVAP MEVP-039 BOTTOMS PUMP, MPMP - H68
(SEE NOTE 2, THIS SHEET)

NOTES
1. FOR GENERAL NOTES AND SYMBOLS, SEE 5GW0740-WD-01.
2. THE AUX WASTE EVAP PACKAGE MEVP-039 IS SHOWN ON SHEETS 28 THRU 34.
3. THE LIQUID RADWASTE SOLIDIFICATION STATION PACKAGE IS SHOWN ON SH 02, 03, 11 THRU 16, 21, 23 THRU 27, 29, 30.

PRC APERTURE CARD

REV NO	ECN NO	DATE	DSGN	OPER	CHKD	SUPV	ENGR	NSP	SUBM	RECM	APPD
3	SI										
	MADE MINOR CHANGES.										
2	SI										
	MADE MINOR CHANGES REMOVED EL & COL.										
1	SI	10-20-77									
	ADDED TERM NO., REF DWG NO. & JUMPER NO.										

DSGN - R.D. Wells
OPER - J.W. Patton
CHKD - L.L. Cobbs
SUPV - W.L. Elsley
NSP
ENGINEER - W.L. Elsley

SCALE NONE — EXCEPT AS NOTED

GENERAL
UNITS 1 & 2

SYSTEM SCHEMATIC
WASTE DISPOSAL SYSTEM

BELLEFONTE NUCLEAR PLANT
TENNESSEE VALLEY AUTHORITY
DIVISION OF ENGINEERING DESIGN

N

SUBMITTED	RECOMMENDED	APPROVED
W.L. Elsley	L.L. Cobbs	R.M. Hodges

KNOXVILLE 12-15 78 | 88 | E | SGW0740-WD-30 | R3

RECORD DRAWING AS CONSTRUCTED

INSPECTED AND APPROVED FOR ISSUE

PRINT
SIZE E

PRINTS REQD-R

Docket # 50-438
Control # 8304050536
Date 3-25-83 of Document
REGULATORY DOCKET FILE