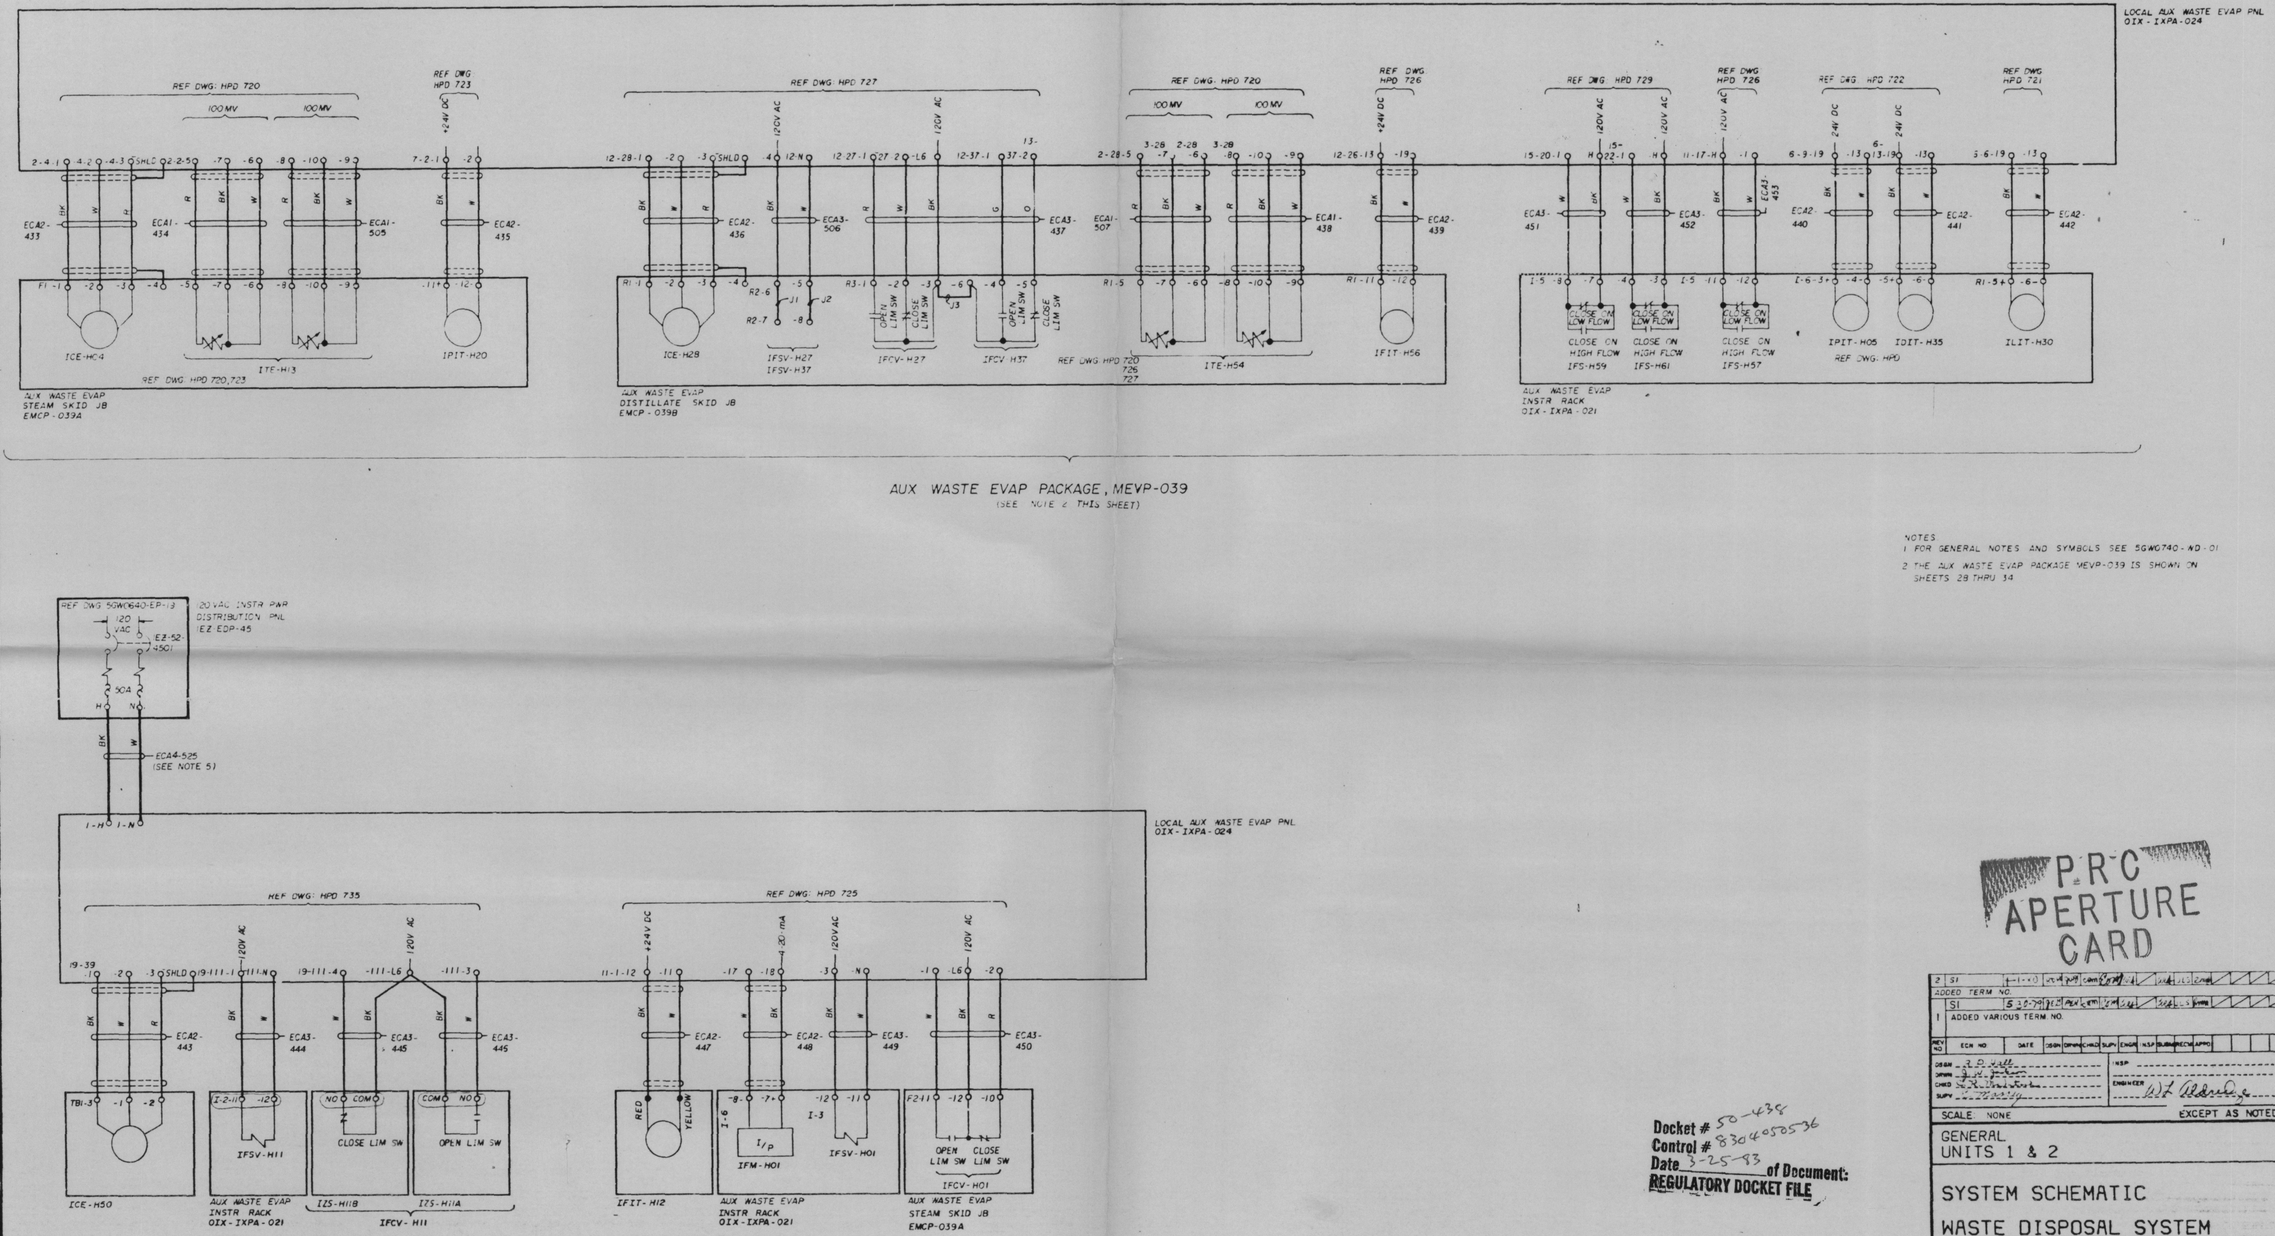

NOTES:
1. FOR GENERAL NOTES AND SYMBOLS SEE 5GW0740-WD-01
2. THE AUX WASTE EVAP PACKAGE MEVP-039 IS SHOWN ON SHEETS 28 THRU 34

P.R.C. APERTURE CARD

REV NO	ECN NO	DATE	DSGN	DRWN	CHKD	SUPV	ENGR	INSP	SUBMIT	RECM	APPD
2	S1										
ADDED TERM NO.											
1	S1	5-30-79									
1	ADDED VARIOUS TERM NO.										

DSGN
DRWN
CHKD
SUPV
INSP
ENGINEER
SCALE: NONE
EXCEPT AS NOTED

GENERAL
UNITS 1 & 2

SYSTEM SCHEMATIC
WASTE DISPOSAL SYSTEM

BELLEFONTE NUCLEAR PLANT
TENNESSEE VALLEY AUTHORITY
DIVISION OF ENGINEERING DESIGN

N

SUBMITTED | RECOMMENDED | APPROVED

KNOXVILLE 12-15-78 | 88 | E | 5GW0740-WD-32 | R2

RECORD DRAWING AS CONSTRUCTED

INSPECTED AND APPROVED FOR ISSUE

Docket # 50-438
Control # 8304050536
Date 3-25-83 of Document:
REGULATORY DOCKET FILE