NOTES:
1. FOR GENERAL NOTES AND SYMBOLS SEE 5GW0740-WD-01
2. THE AUX WASTE EVAP PACKAGE MEVP-039 IS SHOWN ON SH 28 THRU 34.

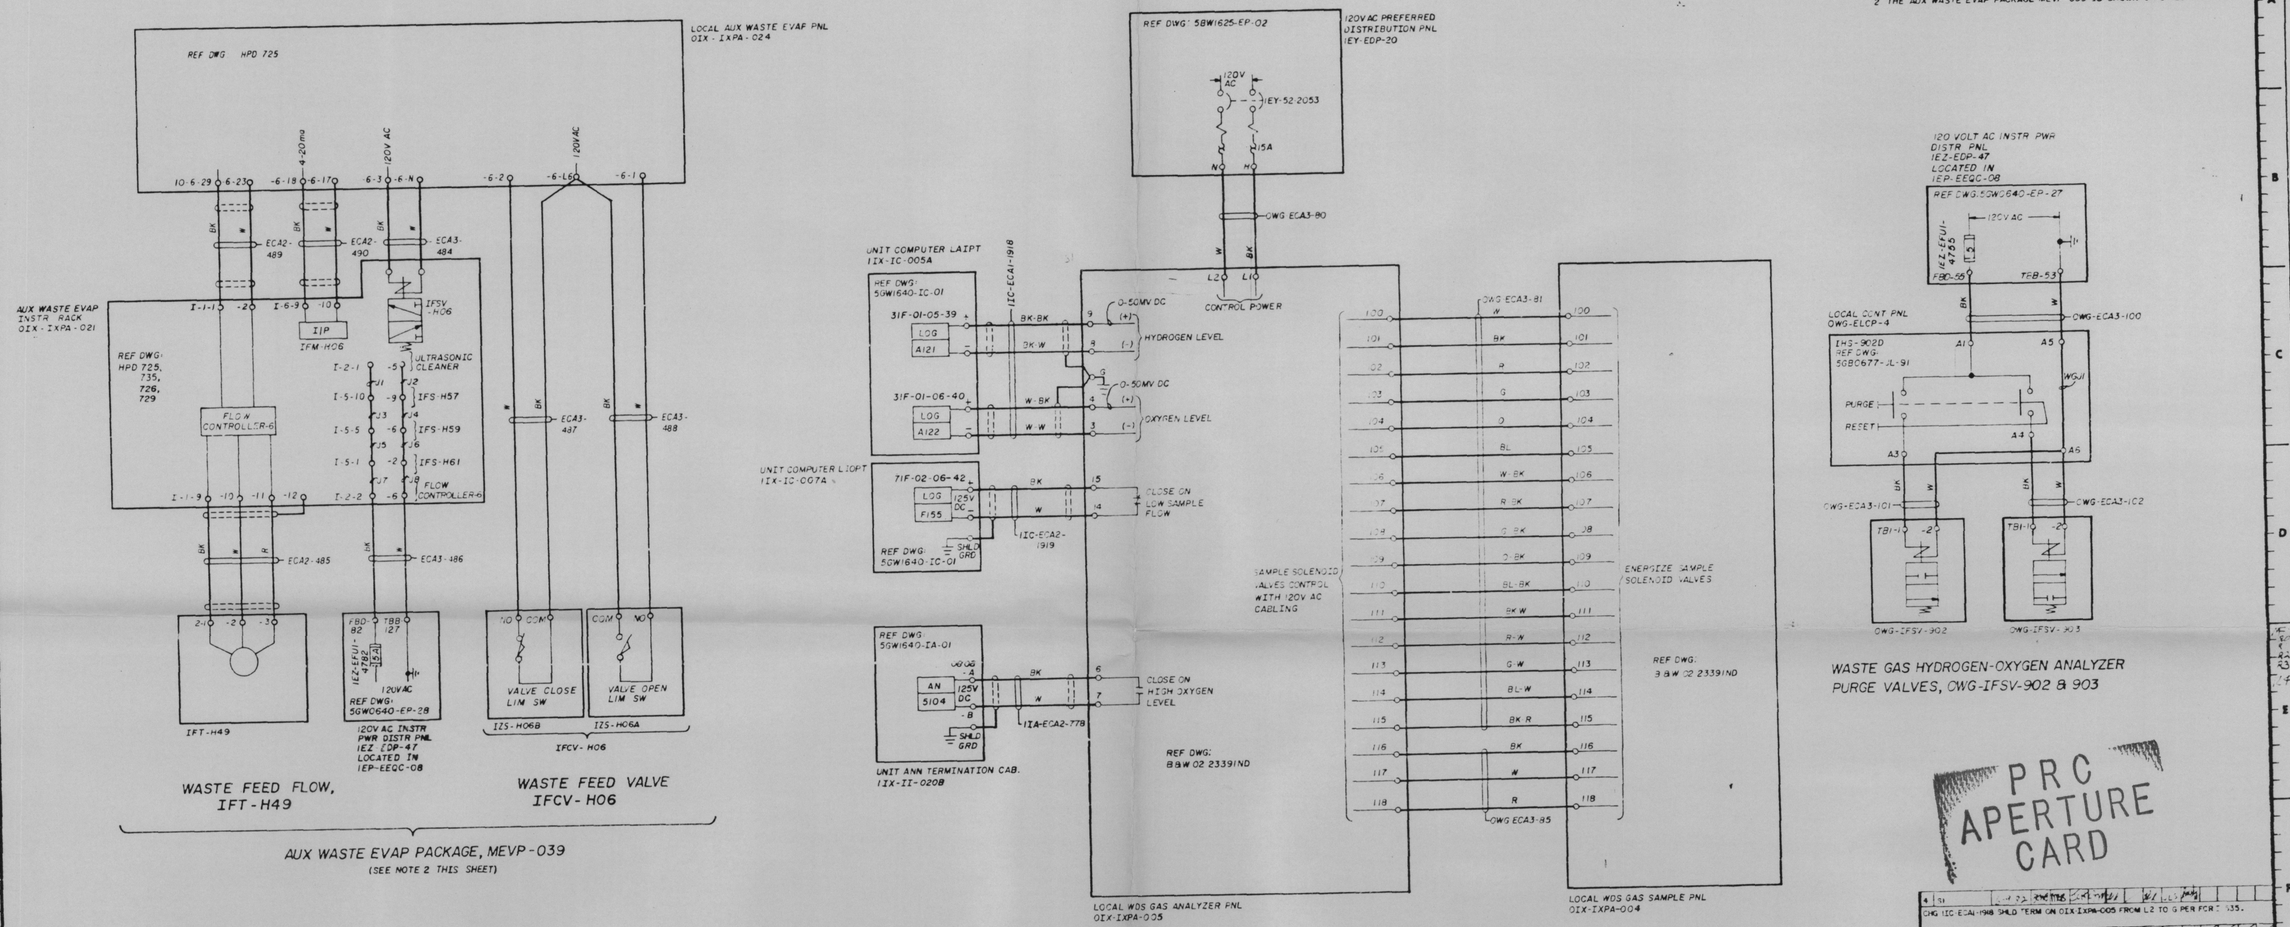

PRC APERTURE CARD

REV NO	ECN NO	DATE	DESIGN	DRAFTING	CHKD	SUPV	ENGR	NSP	SUBMITTED	RECM	APPD
4	S1										
CHG IIC-ECA1-1918 SHLD TERM ON 0IX-IXPA-005 FROM L2 TO G PER FCR T 535.											
3	S1										
ADDED TERM NO 9 MADE MINOR CHANGES.											
2	S1										
ADDED PWR SUPPLY AND MADE MINOR CHANGES.											
1	S1	12-20-79									
ADDED MONITORING SYS CABLE NO., VARIOUS TERM NO., REF DWG NO., JUMPER NO., AND MINOR CHANGES.											

DESIGN W.E. Hall
DRAFTING J.W. Smith
CHKD R. Christofferson
SUPV R.M. Hodges
NSP
ENGINEER W.L. Aldridge

SCALE: NONE — EXCEPT AS NOTED

GENERAL
UNITS 1 & 2

SYSTEM SCHEMATIC
WASTE DISPOSAL SYSTEM

BELLEFONTE NUCLEAR PLANT
TENNESSEE VALLEY AUTHORITY
DIVISION OF ENGINEERING DESIGN

N

SUBMITTED: W.L. Aldridge
RECOMMENDED: [illegible]
APPROVED: R.M. Hodges

KNOXVILLE 12-4-79 | 88 | E | 5GW0740-WD-34 R4

RECORD DRAWING AS CONSTRUCTED

INSPECTED AND APPROVED FOR ISSUE

Docket # 50-438
Control # 8304050536
Date 3-25-83 of Document:
REGULATORY DOCKET FILE