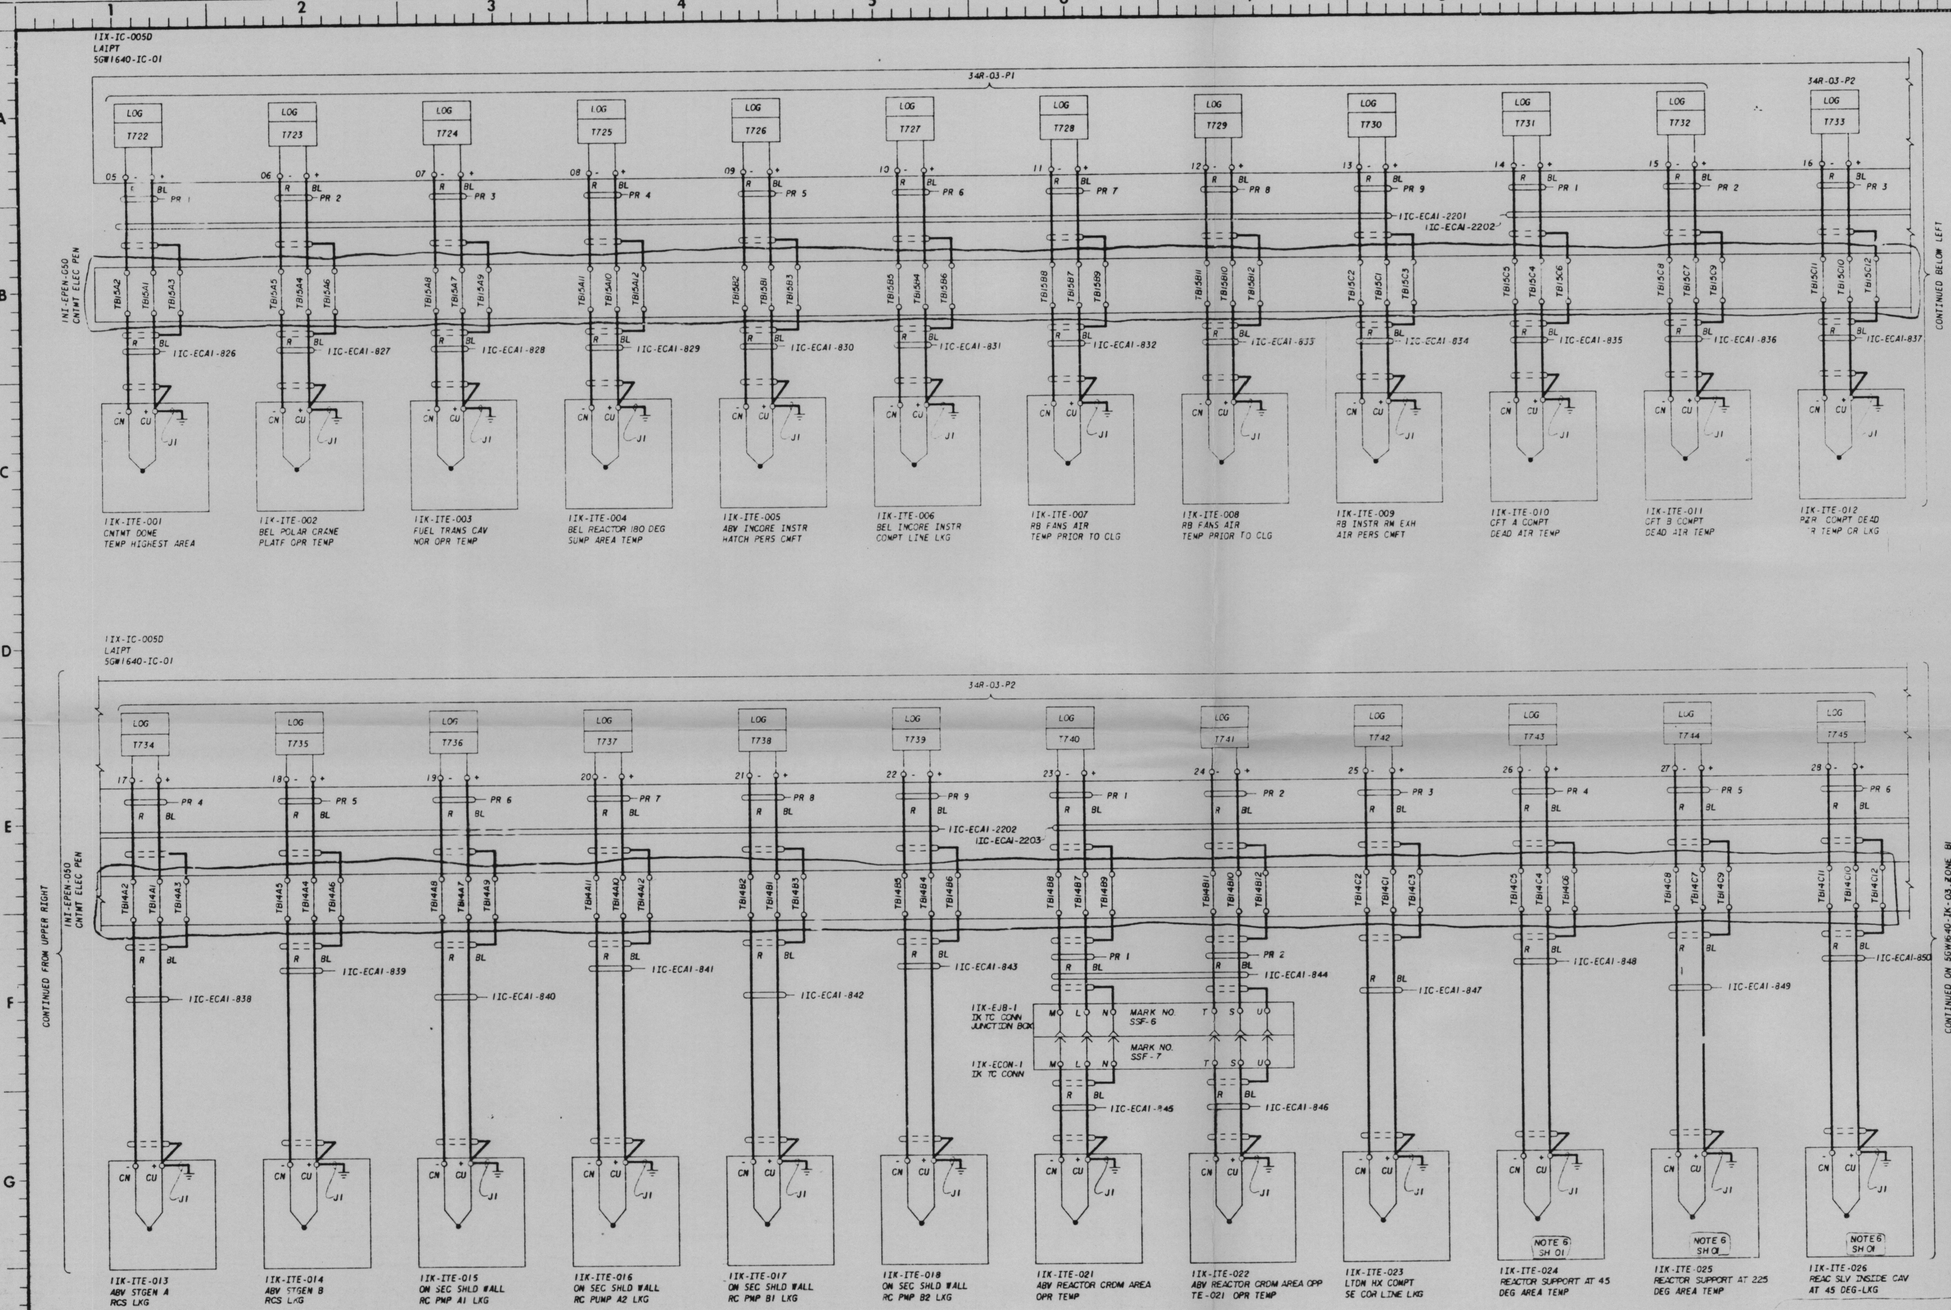

NOTES:)
1. SEE 5GW1640-IK-01 FOR GENERAL NOTES, REFERENCE DRAWINGS AND SYMBOLS.

Docket # 50-438
Control # 8304050536
Date 3-25-83 of Document:
REGULATORY DOCKET FILE

PRC
APERTURE
CARD

REV NO	ECN NO	DATE	DSGN	DRWN	CHKD	SUPV	ENGR	INSP	SUBM	RECV	APPD
1	S1	7-7-80									

REASSIGNED PENETRATION TERMINATIONS N WAS 0° DELETED FURTHER REVIEW BLOCK ADDED NOTE 6 REF.

DSGN
DRWN
CHKD
SUPV
INSP
ENGINEER

SCALE: NTS EXCEPT AS NOTED

GENERAL
UNIT 1

SCHEMATIC DIAGRAM
TEMPERATURE MONITORING
SYSTEM

BELLEFONTE NUCLEAR PLANT
TENNESSEE VALLEY AUTHORITY
DIVISION OF ENGINEERING DESIGN

N

SUBMITTED | RECOMMENDED | APPROVED

KNOXVILLE 9-13-79 | 88 | E | 5GW1640-IK-02 R1

RECORD DRAWING AS CONSTRUCTED

INSPECTED AND APPROVED FOR ISSUE

PRINT
SIZE