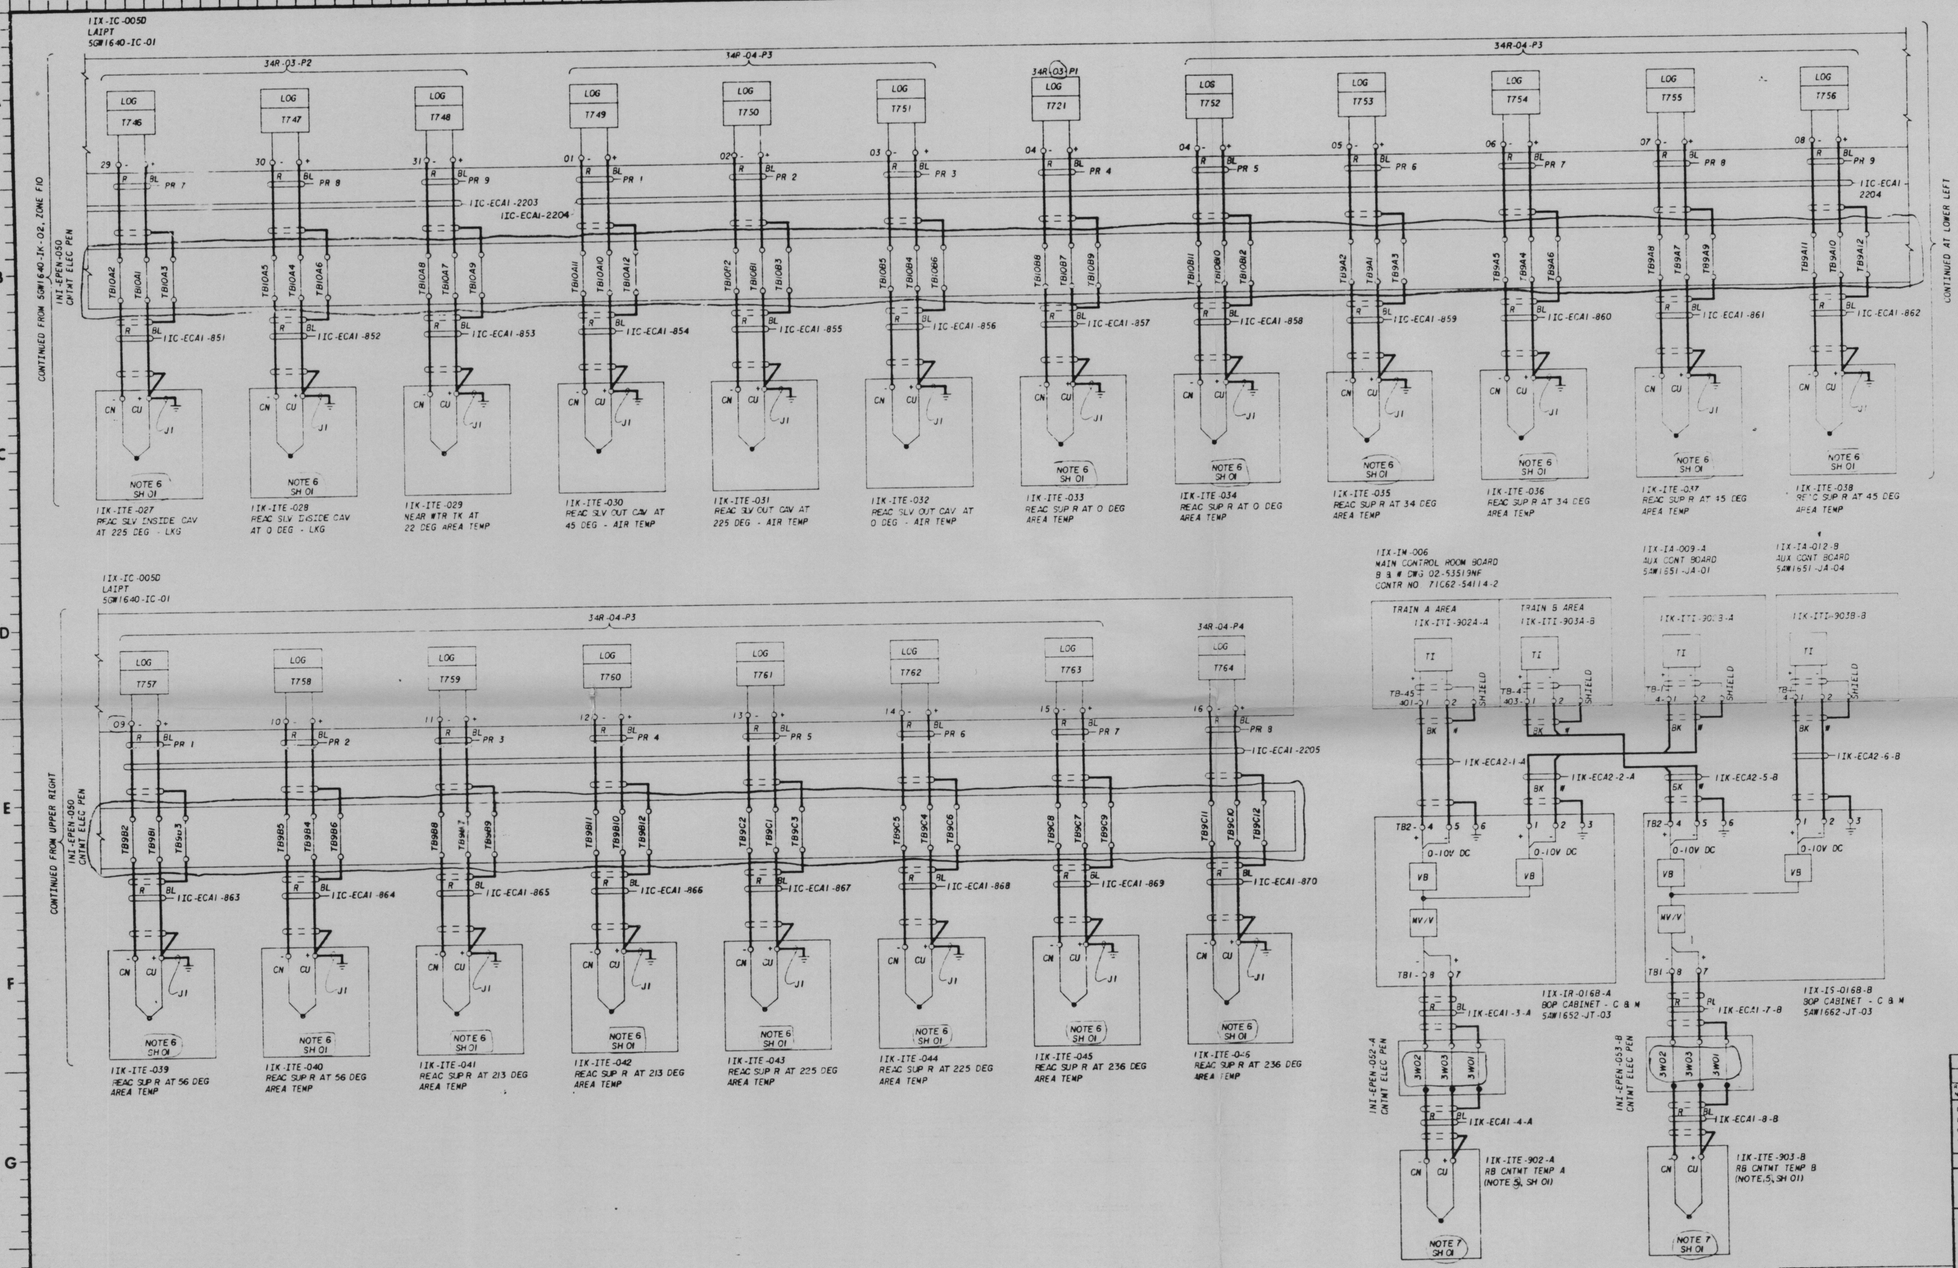

NOTES:
1 SEE SQN1640-IK-01 FOR GENERAL NOTES, REFERENCE DRAWINGS, AND SYMBOLS.

Docket #53-438
Control #8304050536
Date 3-25-83 of Document:
REGULATORY DOCKET FILE

PRC APERTURE CARD

REV NO.	ECN NO.	DATE	DSGN	DRWN	CHKD	SUPV	ENGR	INSP	SUBM	MECH	APPD			
1	S1	7-7-80										N/A	N/A	N/A

REASSIGNED PEN TERM'S. ADDED NOTE 6 & 7 REF. NOTE 5 WAS 6, MISC CHANGE

DSGN
DRWN
CHKD
SUPV
INSP
ENGINEER

SCALE EXCEPT AS NOTED

GENERAL
UNIT 1

SCHEMATIC DIAGRAM
TEMPERATURE MONITORING
SYSTEM

BELLEFONTE NUCLEAR PLANT
TENNESSEE VALLEY AUTHORITY
DIVISION OF ENGINEERING DESIGN

Q

SUBMITTED | RECOMMENDED | APPROVED

KNOXVILLE | 7-13-79 | 88 | E | SGW1640-IK-03 01

RECORD DRAWING AS CONSTRUCTED

REVIEWED
RC (CIVIL) N/A
RE (ELEC) N/A
RM (MECH) N/A

INSPECTED AND APPROVED FOR ISSUE

PRINT
SIZE
BR OR PROJ
PRINTS REQD