NOTES:
1. FOR GENERAL NOTES AND SYMBOLS SEE SHEET 01.
2. FIELD TO IDENTIFY WITH TVA UNID NO.

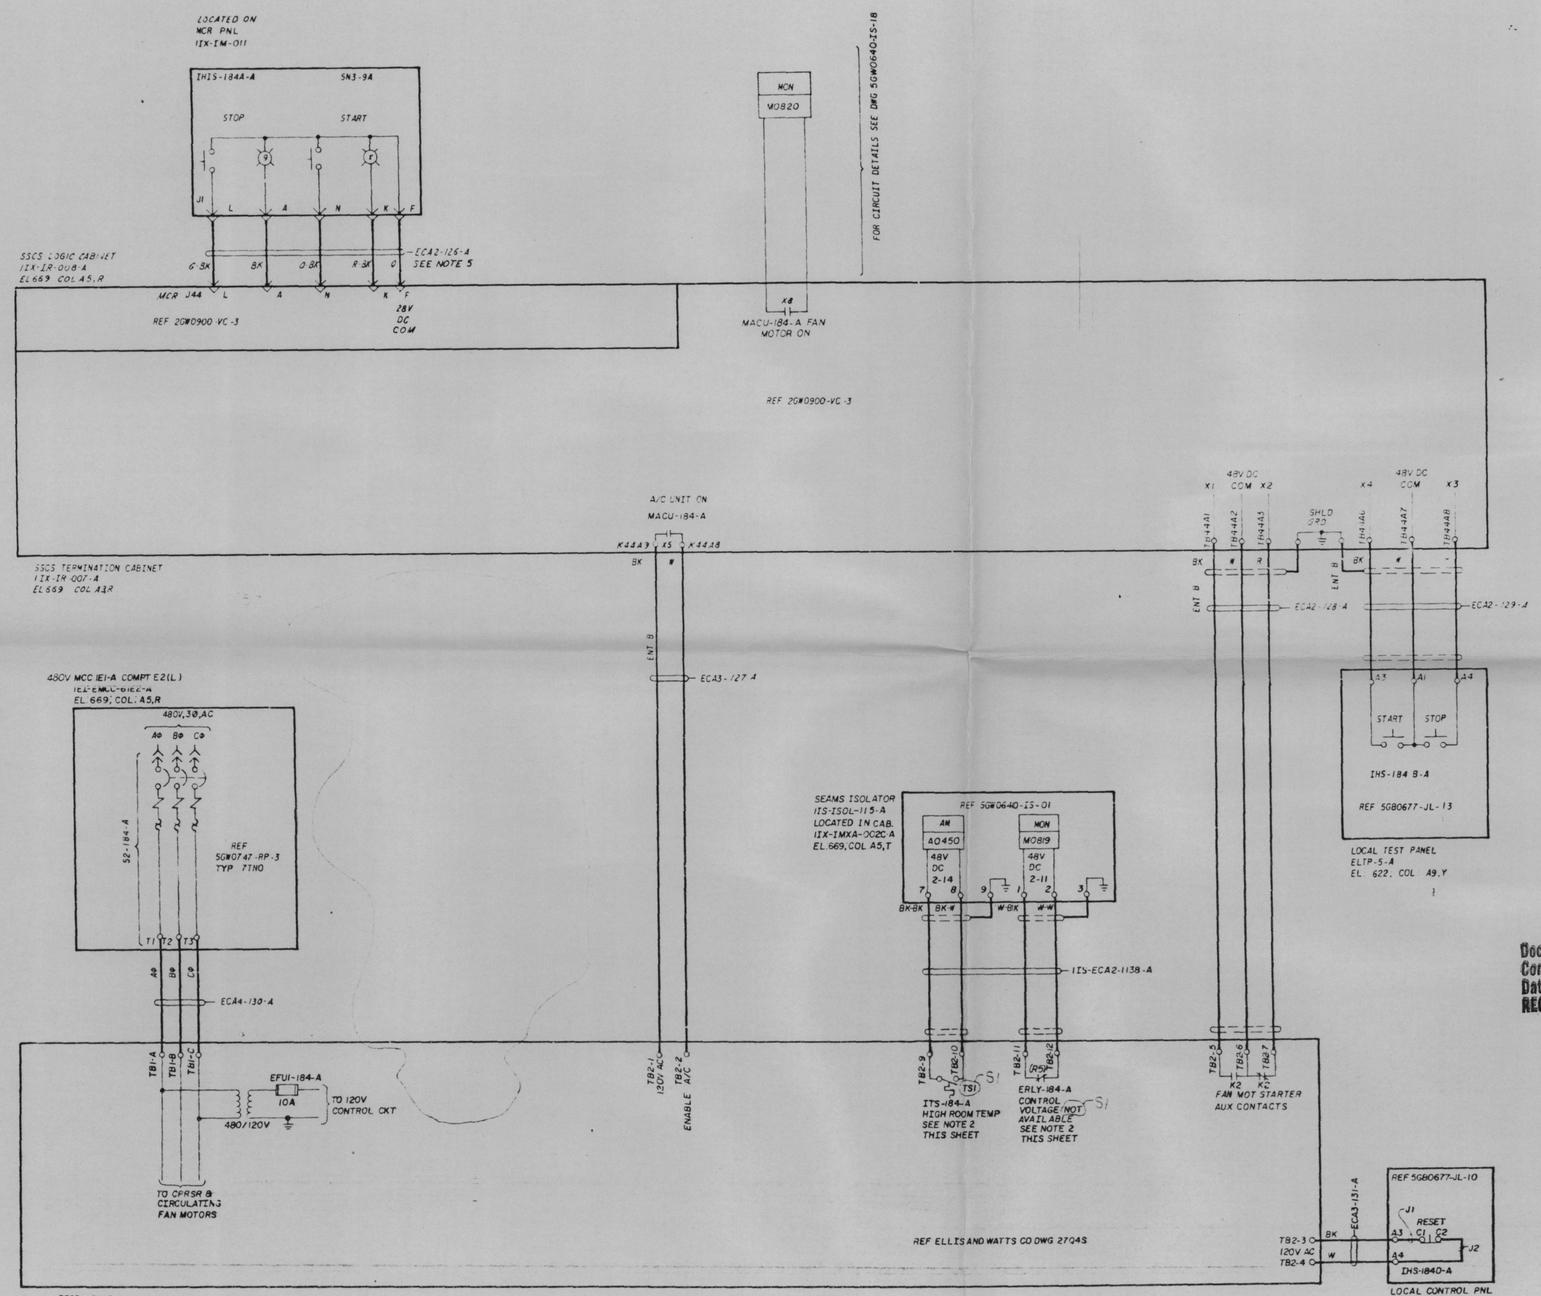

S1

SPENT FUEL (PUMP) AREA A/C UNIT MACU-184-A

Docket # 50-438
Control # 8304050536
Date 3-25-83 of Document:
REGULATORY DOCKET FILE

PRC APERTURE CARD

REV NO	ECN NO	DATE	DSGN	DFTM	CHKD	TLPV	ENGR	NSP	SUPR	RECM	APPD
2	757,S1	11-21-79									
DELETED SF PMP AREA A/C UNIT MCR TEMP INDICATION AND MINOR CHANGES.											
1	S1	7-23-79									
ADDED SPENT FUEL PMP AREA TEMP XMTR 1TT-184-A CKT AND MINOR CHG.											

DSGN
DRWN
CHKD
SUPV
NSP
ENGINEER

SCALE EXCEPT AS NOTED

GENERAL
UNITS 1 & 2

SYSTEM SCHEMATIC
AUX BLDG COMMON AREA
ENVIRONMENTAL CONTROL SYS

BELLEFONTE NUCLEAR PLANT
TENNESSEE VALLEY AUTHORITY
DIVISION OF ENGINEERING DESIGN

Q

SUBMITTED | RECOMMENDED | APPROVED

KNOXVILLE 6-23-78 | 88 | E | 5GW0740-VC-14 | R2

RECORD DRAWING AS CONSTRUCTED

REVIEWED
RC (CIVIL) N/A
RE (ELEC) N/A
RM (MECH) N/A

INSPECTED AND APPROVED FOR ISSUE

PRINT
SIZE