NOTES:
1. FOR GENERAL NOTES AND SYMBOLS SEE SHEET 01.
2. FIELD TO IDENTIFY WITH TVA UNID NO.

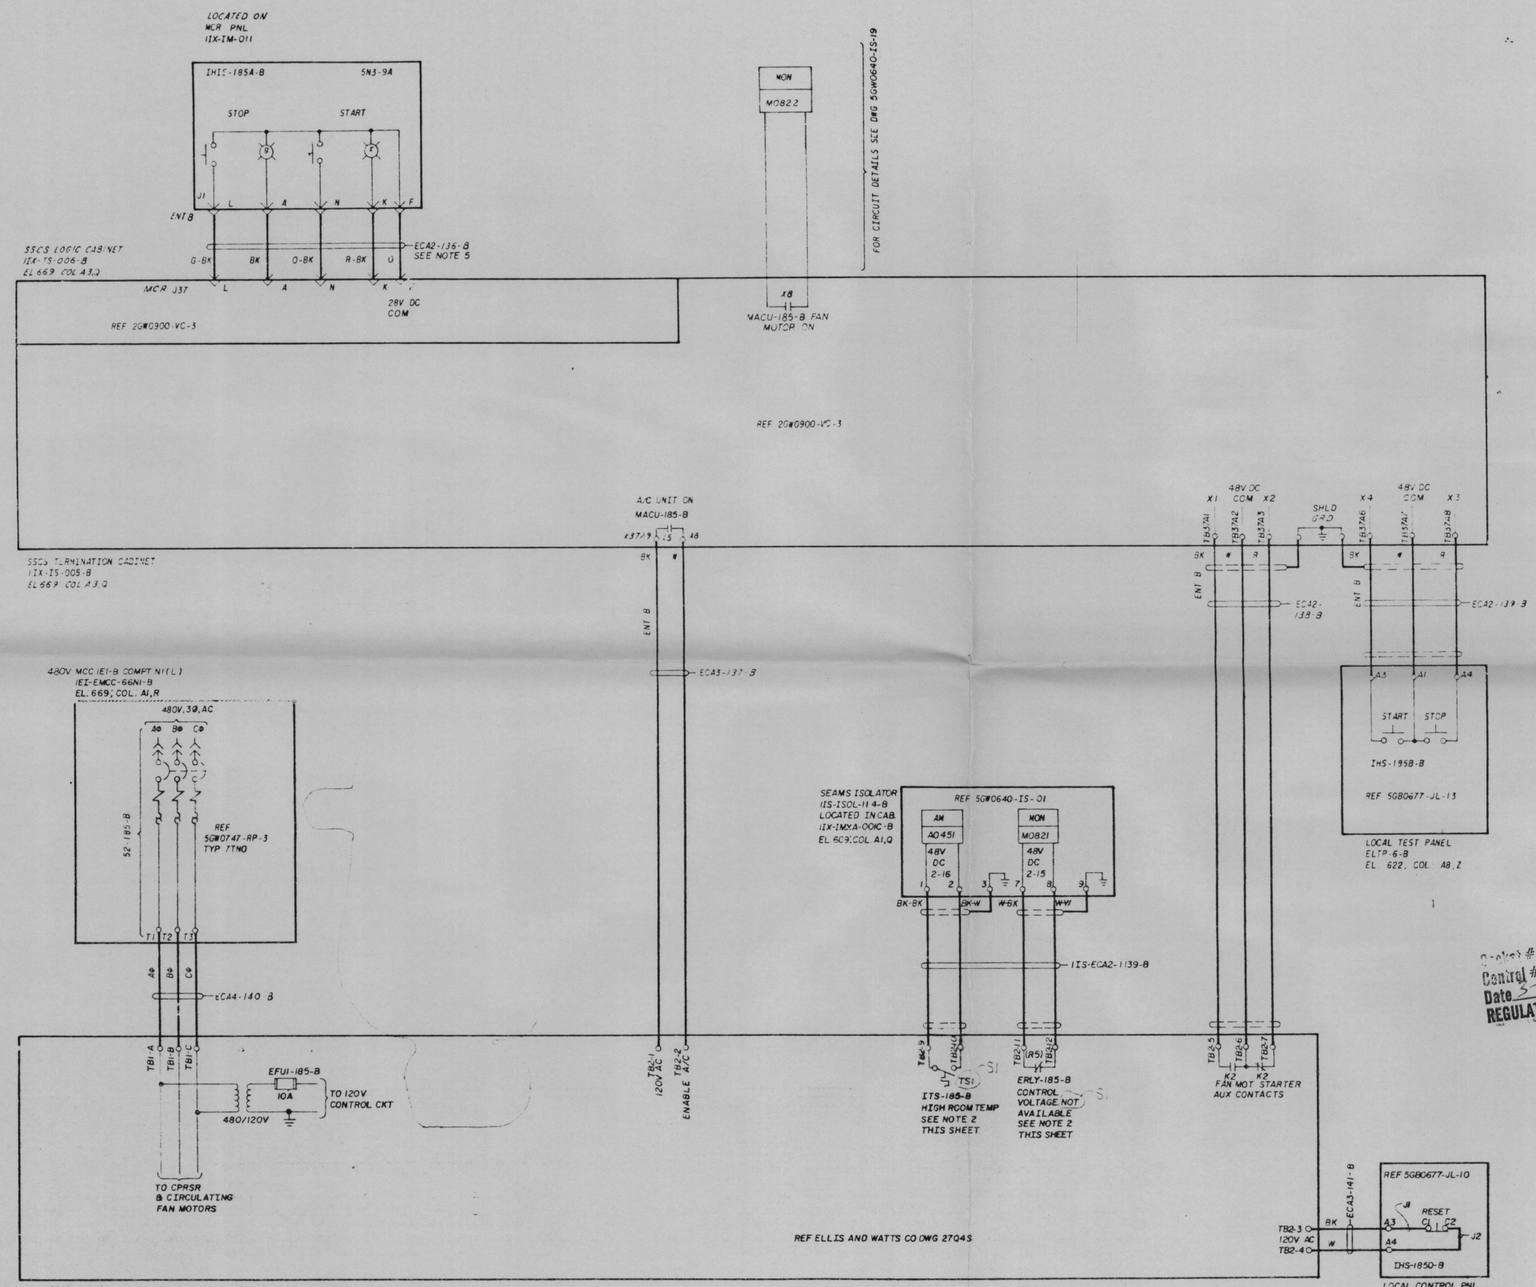

SPENT FUEL PUMP AREA A/C UNIT MACU-185-B

Contract #53-438
Control #8304050571
Date 3-25-83 of Document:
REGULATORY DOCKET FILE

PRC APERTURE CARD

REV NO	ECN NO	DATE	DESIGN	DRAWN	CHKD	SUPV	ENGR	INSP	PLANNER	MECH	APPD
2	757, S1										
DELETED SF PMP AREA A/C UNIT MCR TEMP INDICATION AND MINOR CHANGES											
1	S1										
ADDED SPENT FUEL PMP AREA TEMP XMTR ITT-185-B CKT AND MINOR											

DESIGN — INSP
DRAWN — ENGINEER
CHKD
SUPV

SCALE — EXCEPT AS NOTED

GENERAL
UNITS 1 & 2

SYSTEM SCHEMATIC
AUX BLDG COMMON AREA
ENVIRONMENTAL CONTROL SYS

BELLEFONTE NUCLEAR PLANT
TENNESSEE VALLEY AUTHORITY
DIVISION OF ENGINEERING DESIGN

Q

SUBMITTED — RECOMMENDED — APPROVED

KNOXVILLE 4-27-78 | 88 | E | 5GW0740-VC-15 | R2

RECORD DRAWING AS CONSTRUCTED

REVIEWED
RC (CIVIL) N/A
RE (ELEC) N/A
RM (MECH) N/A

INSPECTED AND APPROVED FOR ISSUE

PRINT
SIZE