88 | E | 5DW1732-ED-03

NOTES:
1. FOR GENERAL NOTES, REFERENCE DRAWINGS AND SYMBOLS SEE DRAWING [illegible]

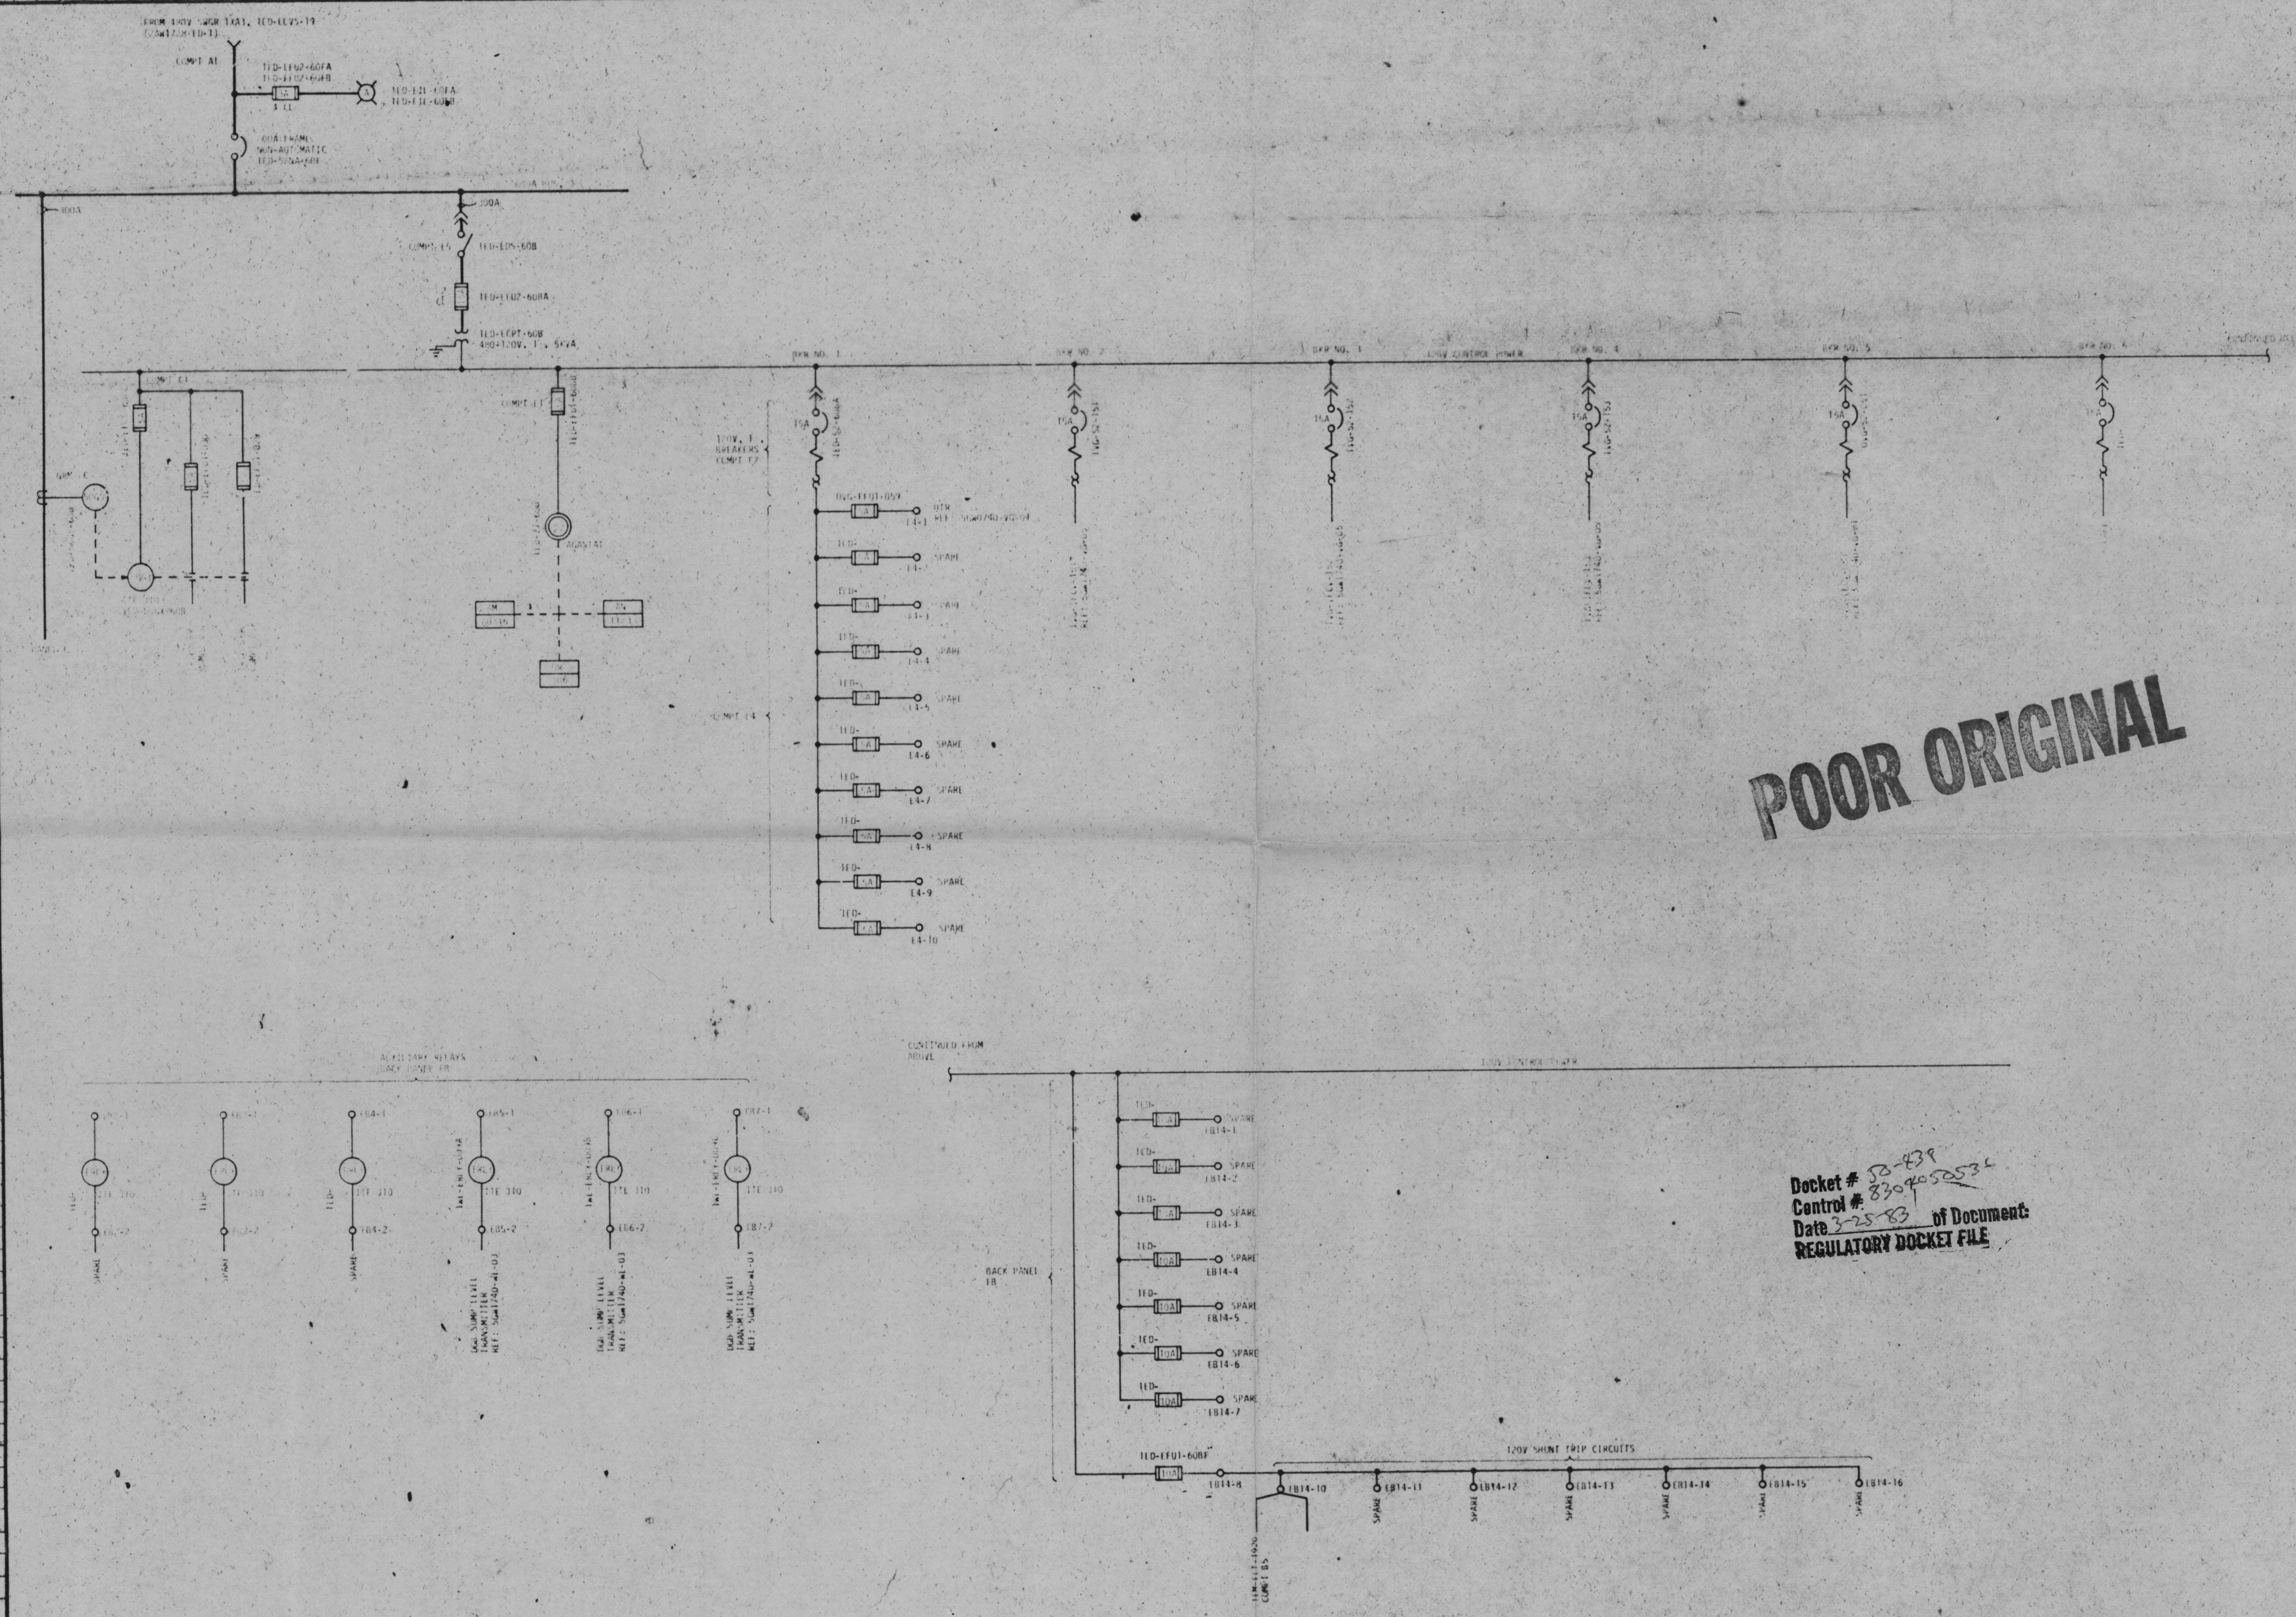
FROM 480V SWGR 1XA1, 1ED-ELVS-19
(28W1728-ED-1)
COMPT A1
1ED-EFU2-60FA
1ED-EFU2-60FB
5A
1ED-EIL-60FA
1ED-EIL-60FB
100A FRAME
NON-AUTOMATIC
100A
100A
COMPT E5
1ED-EDS-60B
1ED-EFU2-60BA
1ED-ECPT-60B
480-120V, 1Ø, 5KVA
COMPT C1
COMPT E1
AGASTAT
120V, 1Ø, BREAKERS COMPT E2
BKR NO. 1
BKR NO. 2
BKR NO. 3
120V CONTROL POWER
BKR NO. 4
BKR NO. 5
BKR NO. 6
CONTINUED BELOW
15A
0VG-EFU1-059
UTR
REF: 5GW0740-VG-04
E4-1
1ED-
5A
SPARE
E4-2
E4-3
E4-4
E4-5
E4-6
E4-7
E4-8
E4-9
E4-10
COMPT E4
AUXILIARY RELAYS
BACK PANEL FB
EB3-1
EB3-2
EB4-1
EB4-2
EB5-1
EB5-2
EB6-1
EB6-2
EB7-1
EB7-2
ERLY
ITE J10
1WI-ERLY-001A
1WI-ERLY-001B
1WI-ERLY-001C
DGB SUMP LEVEL
TRANSMITTER
REF: 5GW1740-WI-03
CONTINUED FROM
ABOVE
120V CONTROL POWER
BACK PANEL
FB
10A
EB14-1
EB14-2
EB14-3
EB14-4
EB14-5
EB14-6
EB14-7
1ED-EFU1-60BF
EB14-8
120V SHUNT TRIP CIRCUITS
EB14-10
EB14-11
EB14-12
EB14-13
EB14-14
EB14-15
EB14-16
1EM-ELT-1920
COMPT B5

POOR ORIGINAL

Docket # 50-438
Control # 8304050536
Date 3-25-83 of Document:
REGULATORY DOCKET FILE

PRC
APERTURE
CARD

REV NO	ECN NO	DATE	DSGN	DRWN	CHKD	SUPV	ENGR	INSP	SUBM	RECM	APPD

DSGN
DRWN
CHKD
SUPV
INSP
ENGINEER

SCALE: NTS EXCEPT AS NOTED

DIESEL GENERATOR BUILDING
UNIT 1

SINGLE LINE
480V MCC 1D1
1ED-EMCC-60

BELLEFONTE NUCLEAR PLANT
TENNESSEE VALLEY AUTHORITY
DIVISION OF ENGINEERING DESIGN
N

SUBMITTED
RECOMMENDED
APPROVED

INSPECTED AND APPROVED FOR ISSUE

KNOXVILLE 8-3-82 | 88 | E | 5DW1732-ED-03 R0

RECORD DRAWING AS CONSTRUCTED

PRINT
SIZE