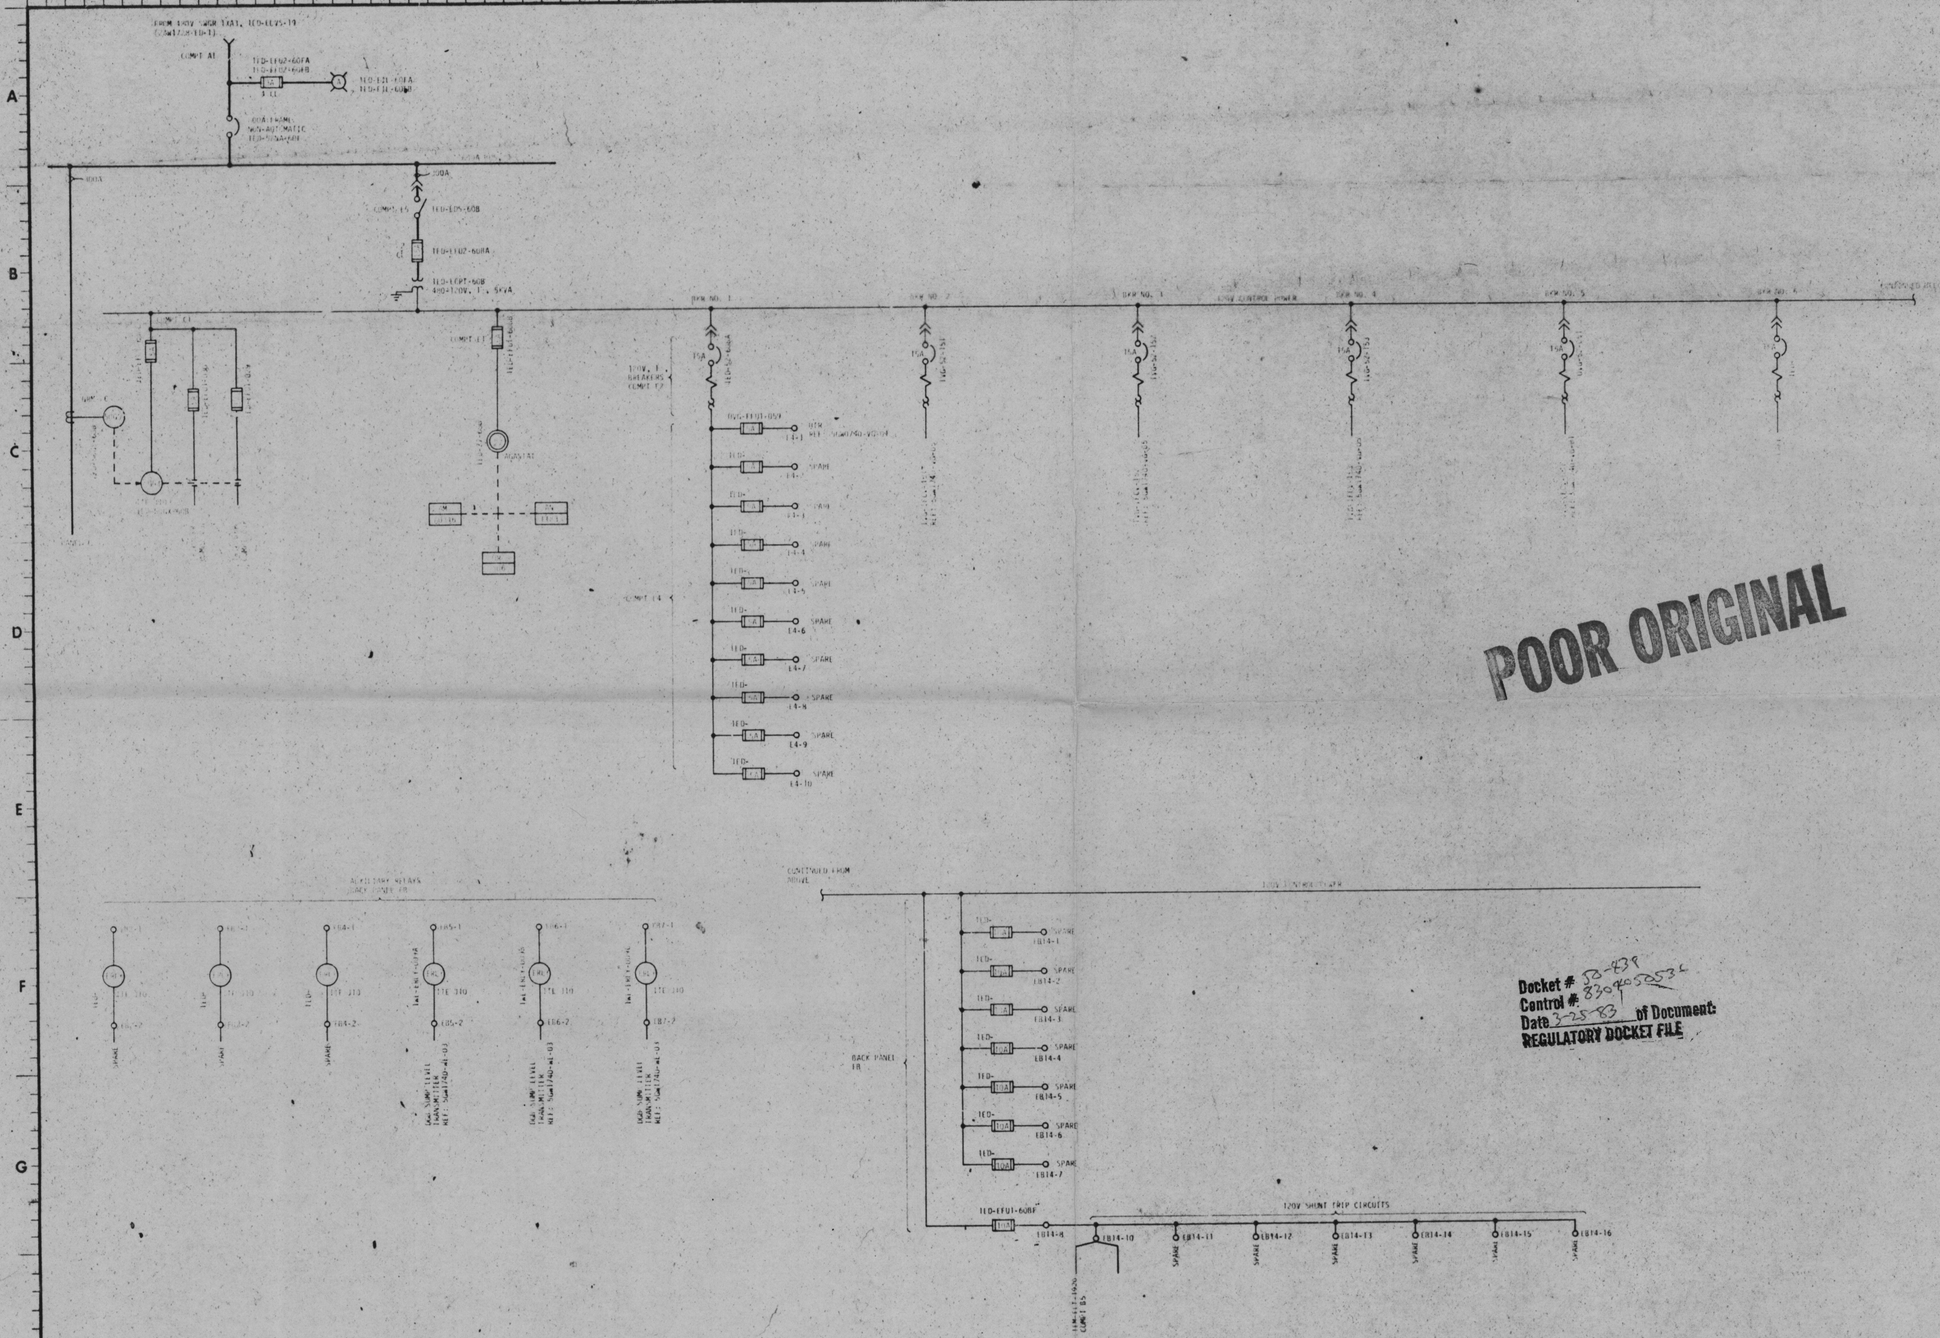

POOR ORIGINAL

Docket # 50-438
Control # 830405053
Date 3-25-83 of Document:
REGULATORY DOCKET FILE

PRC APERTURE CARD

REV NO	ECN NO	DATE	DSGN	DRWN	CHKD	SUPV	ENGR	INSP	SUBM	RECM	APPD

DSGN
DRWN
CHKD
SUPV
NSR
ENGINEER

SCALE: NTS EXCEPT AS NOTED

DIESEL GENERATOR BUILDING
UNIT 1

SINGLE LINE
480V MCC 1D1
1ED-EMCC-60

BELLEFONTE NUCLEAR PLANT
TENNESSEE VALLEY AUTHORITY
DIVISION OF ENGINEERING DESIGN

N

SUBMITTED	RECOMMENDED	APPROVED

KNOXVILLE 8-3-82

88 E 5DW1732-ED-03 R0

RECORD DRAWING AS CONSTRUCTED

INSPECTED AND APPROVED FOR ISSUE

88 E 5DW1732-ED-03