NOTES:
1 FOR GENERAL NOTES AND REFERENCE DRAWINGS SEE 5GW1740-EA-01.

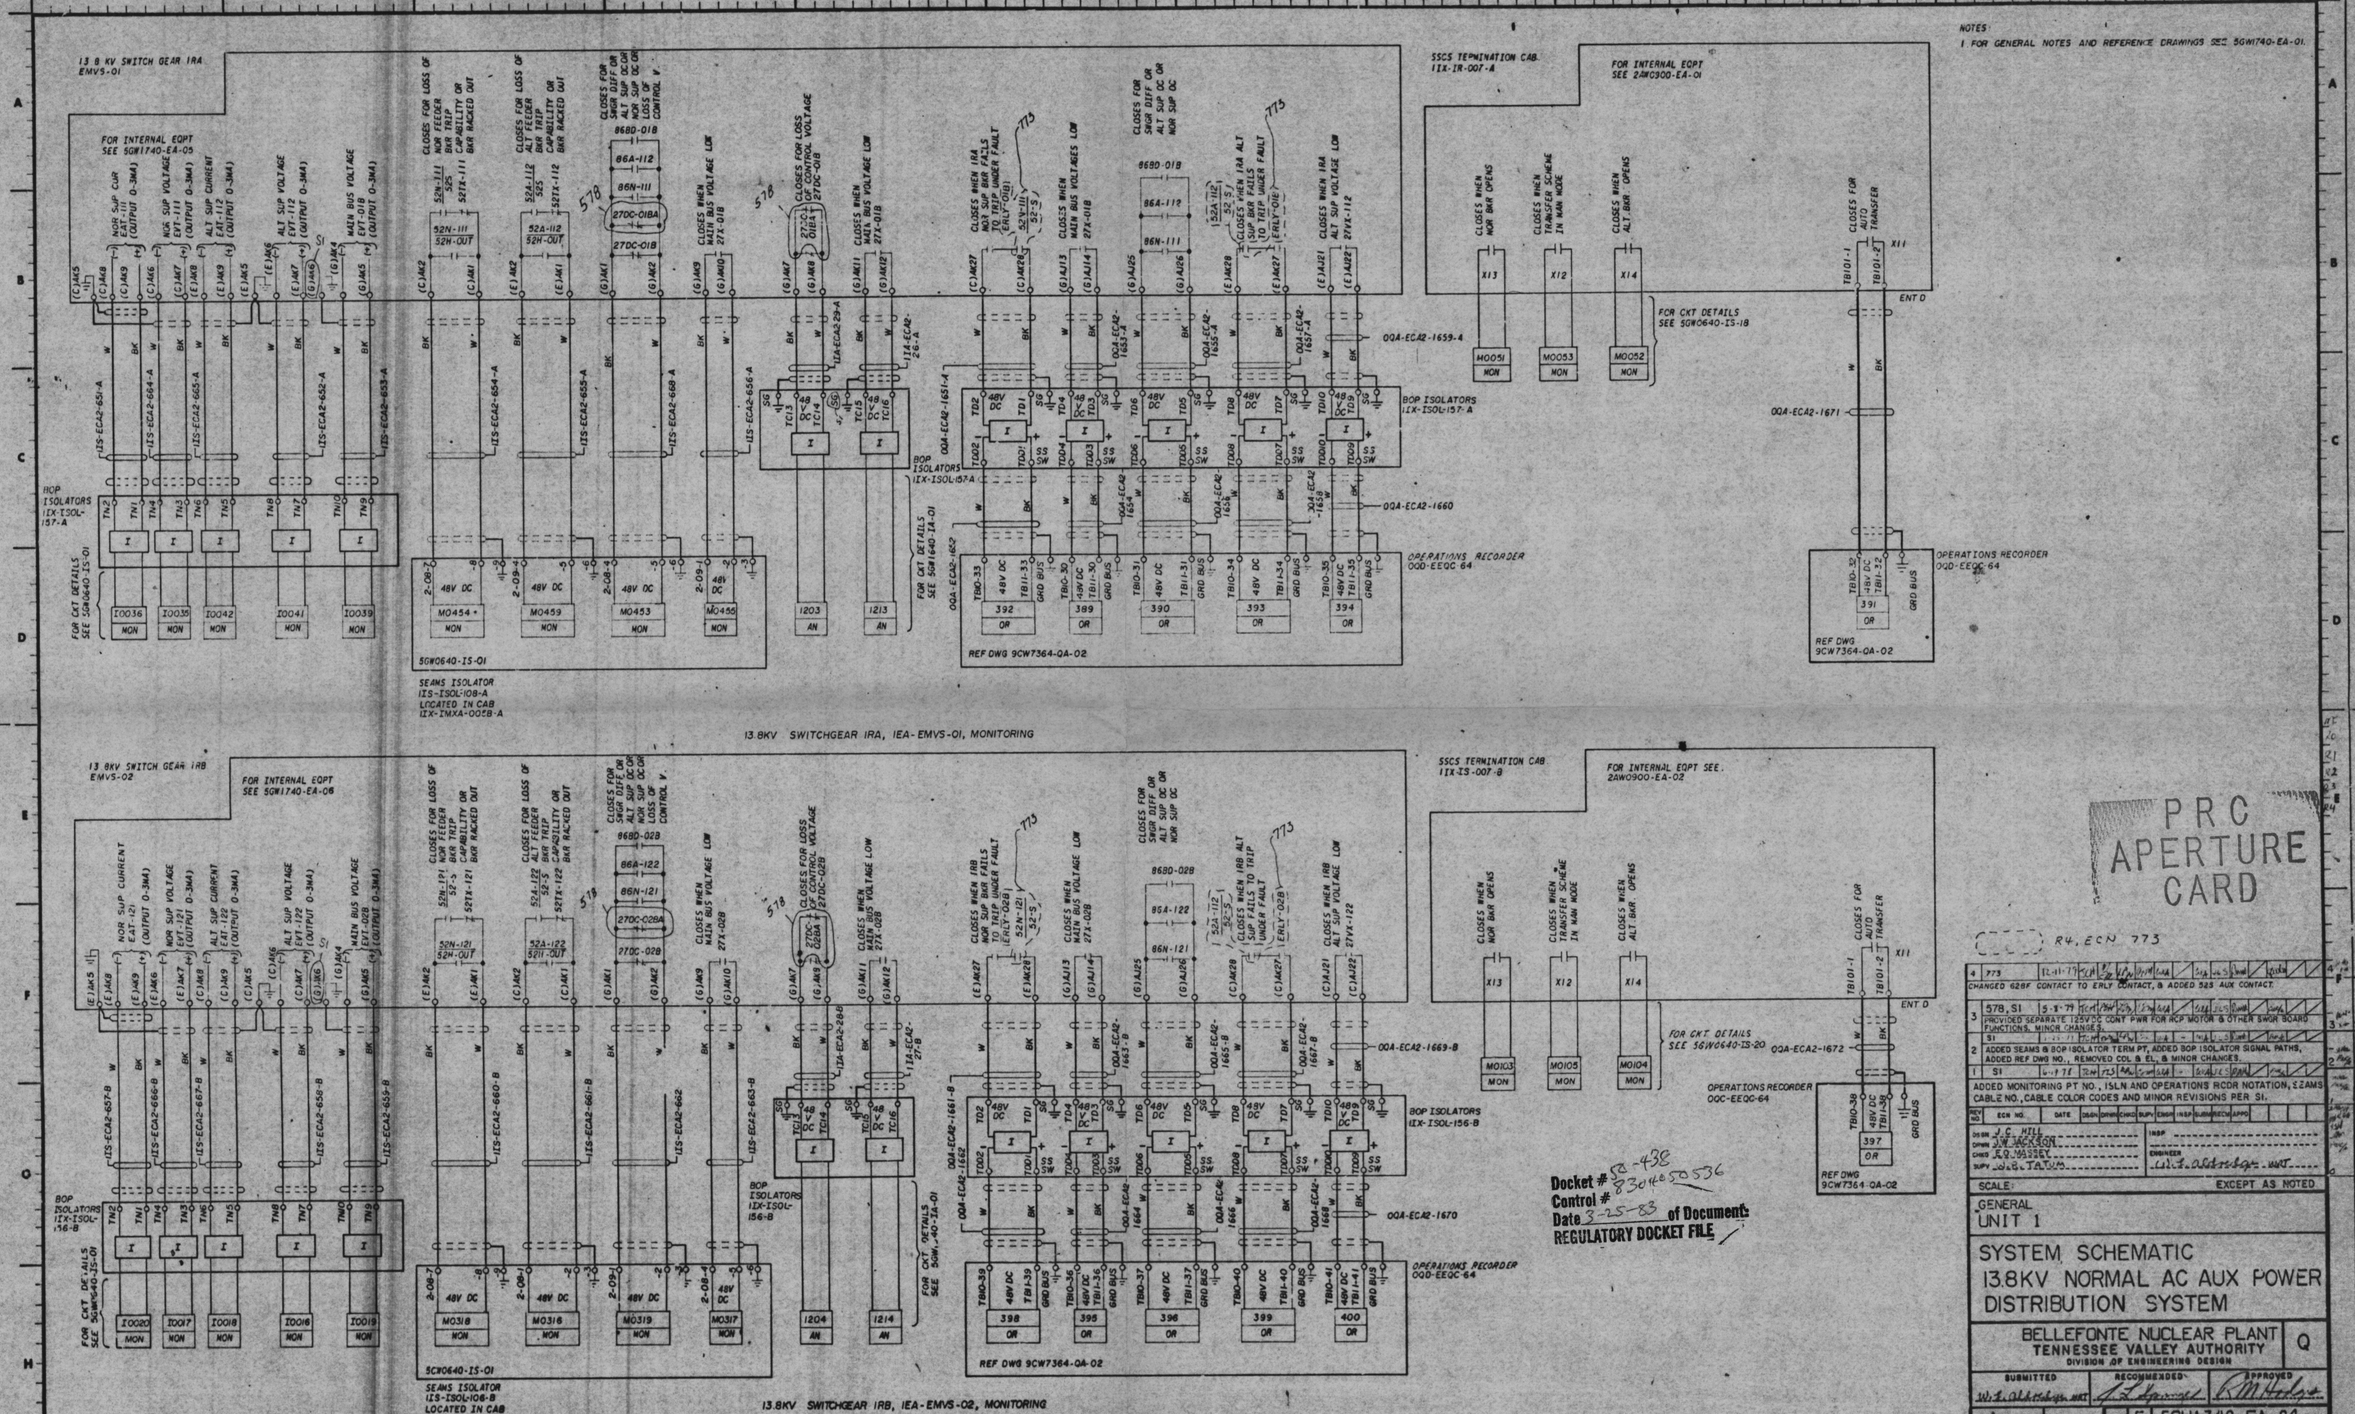

13.8KV SWITCHGEAR IRA, IEA-EMVS-01, MONITORING

13.8KV SWITCHGEAR IRB, IEA-EMVS-02, MONITORING

Docket # 50-438
Control # 8304050536
Date 3-25-83 of Document:
REGULATORY DOCKET FILE

PRC APERTURE CARD

R4, ECN 773

REV NO	ECN NO.	DATE	DRAWN	DWN	CHKD	SUPV	ENGR	INSP	SUPERVISOR	RECD	APPD
4	773	12-11-77									
	CHANGED 628F CONTACT TO ERLY CONTACT, & ADDED 52S AUX CONTACT.										
3	578, S1	5-5-77									
	PROVIDED SEPARATE 125VDC CONT PWR FOR RCP MOTOR & OTHER SWGR BOARD FUNCTIONS, MINOR CHANGES.										
	S1										
2	ADDED SEAMS & BOP ISOLATOR TERM PT, ADDED BOP ISOLATOR SIGNAL PATHS, ADDED REF DWG NO., REMOVED COL & EL, & MINOR CHANGES.										
1	S1	6-17-76									
	ADDED MONITORING PT NO., ISLN AND OPERATIONS RCDR NOTATION, SEAMS CABLE NO., CABLE COLOR CODES AND MINOR REVISIONS PER S1.										

DESIGN J.E. HILL
DRAWN J.W. JACKSON
CHKD E.O. MASSEY
SUPV J.R. TATUM
INSP
SUPERVISOR
ENGINEER

SCALE: EXCEPT AS NOTED

GENERAL
UNIT 1

SYSTEM SCHEMATIC 13.8KV NORMAL AC AUX POWER DISTRIBUTION SYSTEM

BELLEFONTE NUCLEAR PLANT
TENNESSEE VALLEY AUTHORITY
DIVISION OF ENGINEERING DESIGN

Q

SUBMITTED	RECOMMENDED	APPROVED

KNOXVILLE 9-13-77 88 E 5GW1740-EA-04 R4

RECORD DRAWING AS CONSTRUCTED