NOTES:
1. FOR GENERAL NOTES AND REFERENCE DRAWINGS SEE 5GW2740-EA-01.
2. FOR MONITORING SYSTEMS DEVELOPMENT SEE 5GW2740-EA-04.

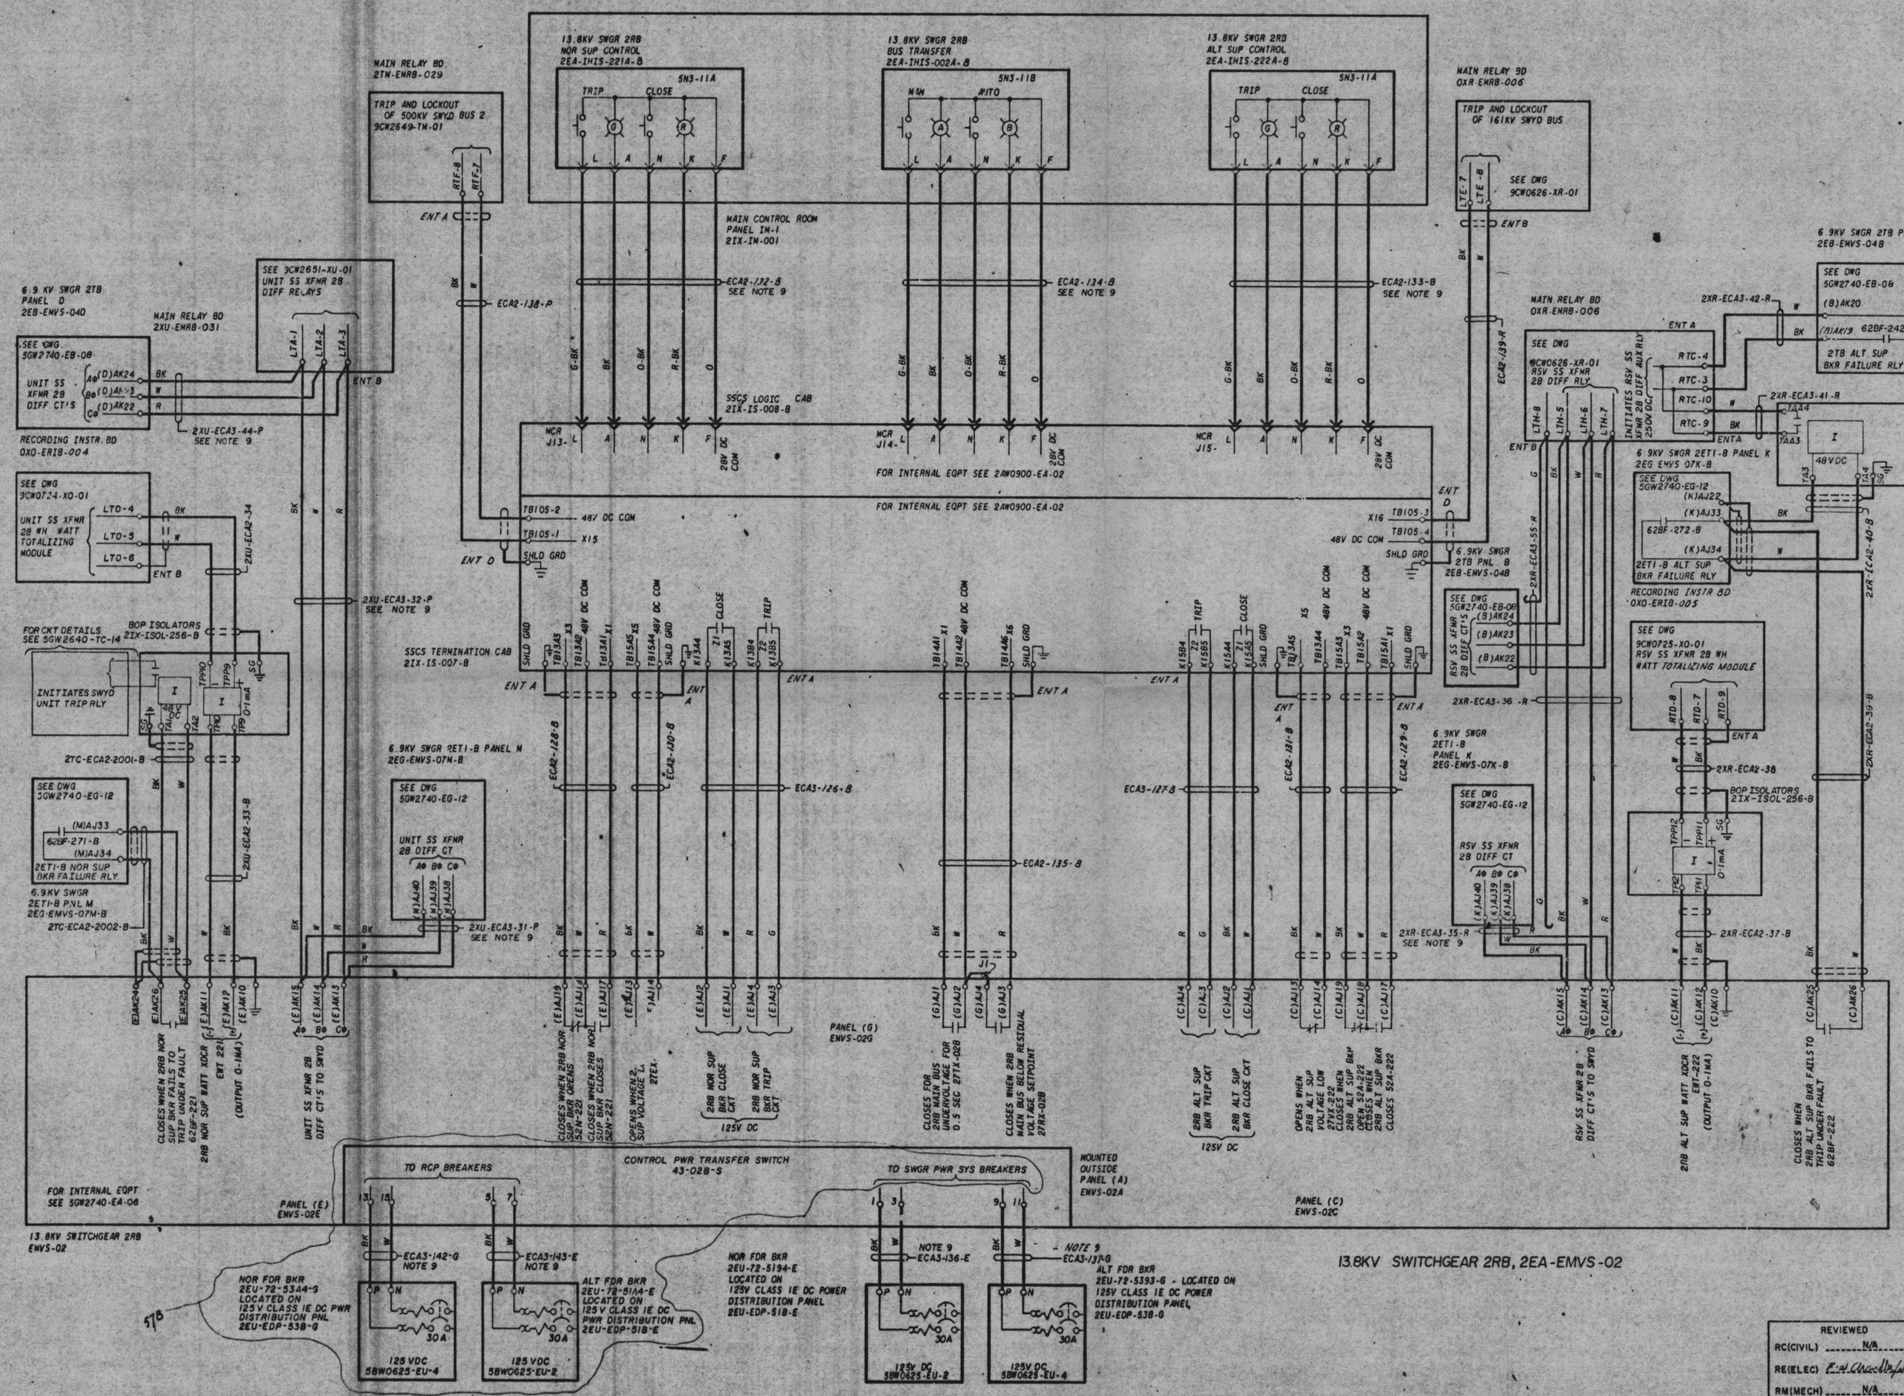

Docket # 50-438
Control # 8304050536
Date 3-25-83 of Document
REGULATORY DOCKET FILE

PRC APERTURE CARD

REV	ECN NO.	DATE	DSGN	DRAN	CHKD	SUPV	ENGR	INSP	SUBM	RECM	APPD
1	578										

PROVIDED SEPARATE 125 VDC CONT PWR FOR RCP MOT & OTHER BOARD FUNCTIONS, ADDED BOP ISOLATOR TERMINAL POINTS & SIGNAL PATHS.

DSGN / DRAN / CHKD / SUPV / INSP / ENGINEER

SCALE: EXCEPT AS NOTED

GENERAL
UNIT 2

SYSTEM SCHEMATIC
13.8KV NORMAL AC AUX POWER DISTRIBUTION SYSTEM

BELLEFONTE NUCLEAR PLANT
TENNESSEE VALLEY AUTHORITY
DIVISION OF ENGINEERING DESIGN

Q

SUBMITTED / RECOMMENDED / APPROVED

KNOXVILLE 1-10-77 88 E 5GW2740-EA-03 R1

RECORD DRAWING AS CONSTRUCTED

REVIEWED
RC(CIVIL) N/A
RE(ELEC)
RM(MECH) N/A