NOTES:
1. FOR GENERAL NOTES AND SYMBOLS SEE DWG 5GW1740-ED-01.

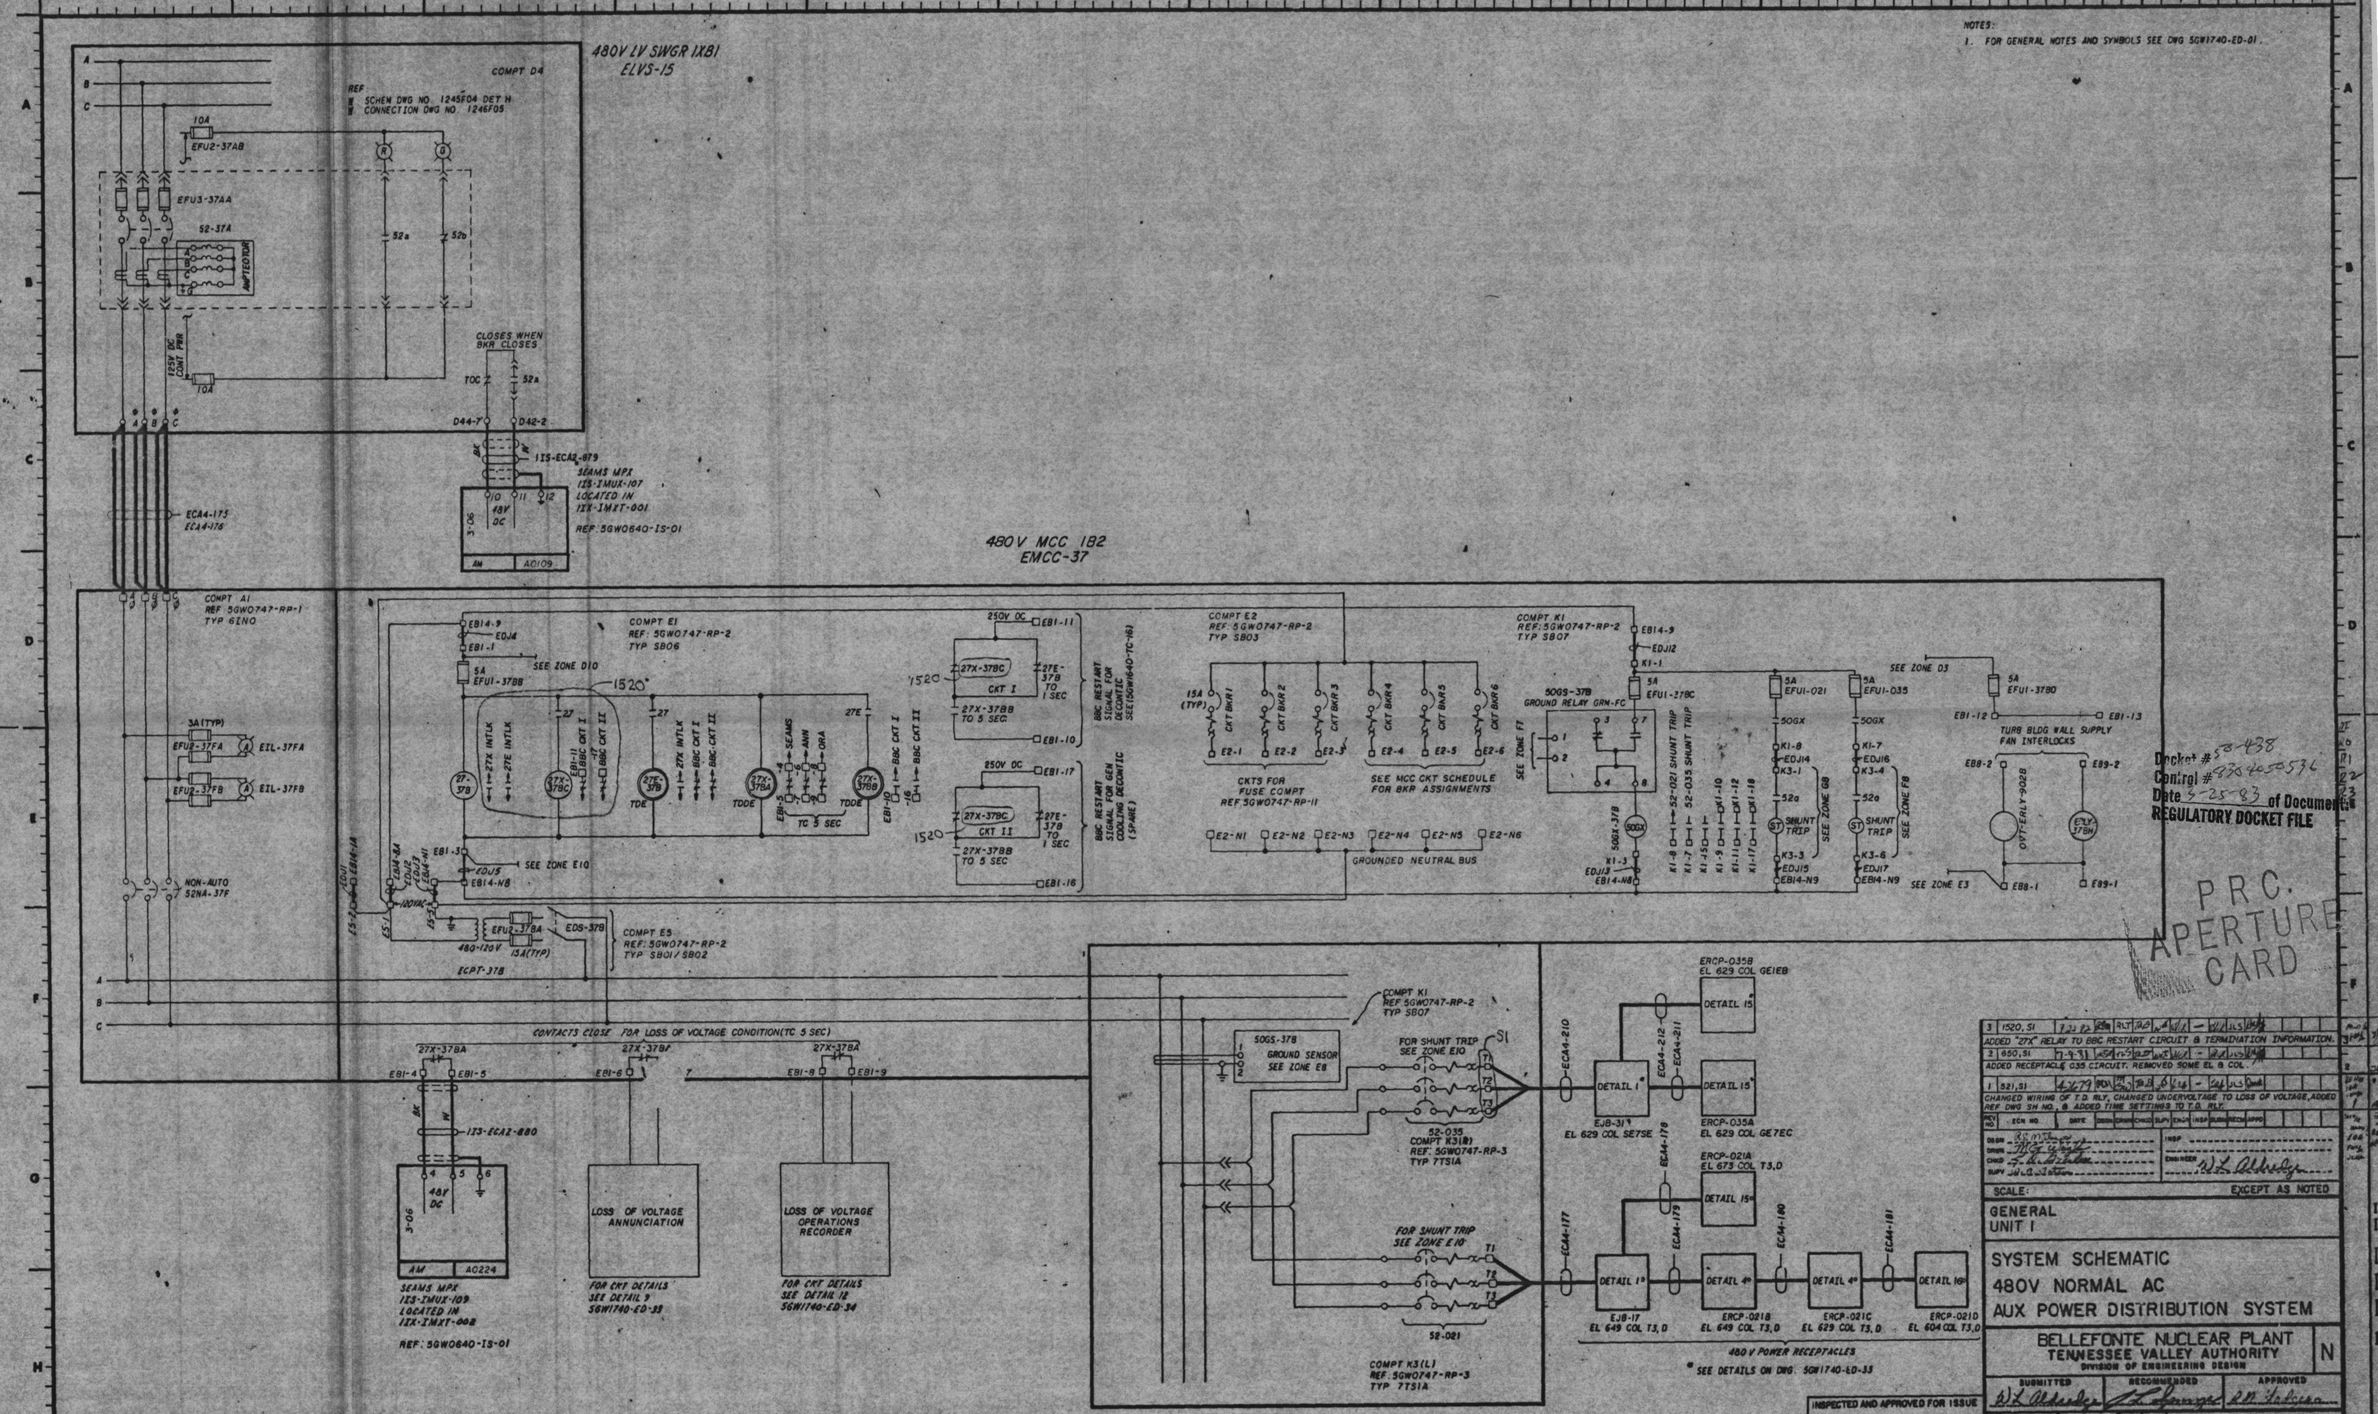

Docket # 50-438
Control # 8304050536
Date 4-25-83
of Documents
REGULATORY DOCKET FILE

PRC. APERTURE CARD

3	1520, S1	7-22-82	ADDED "27X" RELAY TO BBC RESTART CIRCUIT & TERMINATION INFORMATION.
2	850, S1	7-9-81	ADDED RECEPTACLE 035 CIRCUIT. REMOVED SOME EL & COL.
1	521, S1	4-27-79	CHANGED WIRING OF T.D. RLY, CHANGED UNDERVOLTAGE TO LOSS OF VOLTAGE, ADDED REF DWG SH NO., & ADDED TIME SETTINGS TO T.D. RLY.

NO. | ECN NO. | DATE | DRWN | DSGN | CHKD | SUPV | ENGR | INSP | SUBM | REVIEW | APPRD

DRWN M. G. Wright
CHKD J. D. Fuller
SUPV W. L. Albright
INSP
ENGINEER W. L. Albright

SCALE: EXCEPT AS NOTED

GENERAL
UNIT 1

SYSTEM SCHEMATIC
480V NORMAL AC
AUX POWER DISTRIBUTION SYSTEM

BELLEFONTE NUCLEAR PLANT
TENNESSEE VALLEY AUTHORITY
DIVISION OF ENGINEERING DESIGN

N

SUBMITTED W. L. Albright | RECOMMENDED J. L. Lemmer | APPROVED R. M. Fabian

KNOXVILLE 4-16-79 | 88 | E | 5GW1740-ED-30 | AB

RECORD DRAWING AS CONSTRUCTED

INSPECTED AND APPROVED FOR ISSUE