NOTES:
1. FOR NOTES AND SYMBOLS SEE SHEET 01.

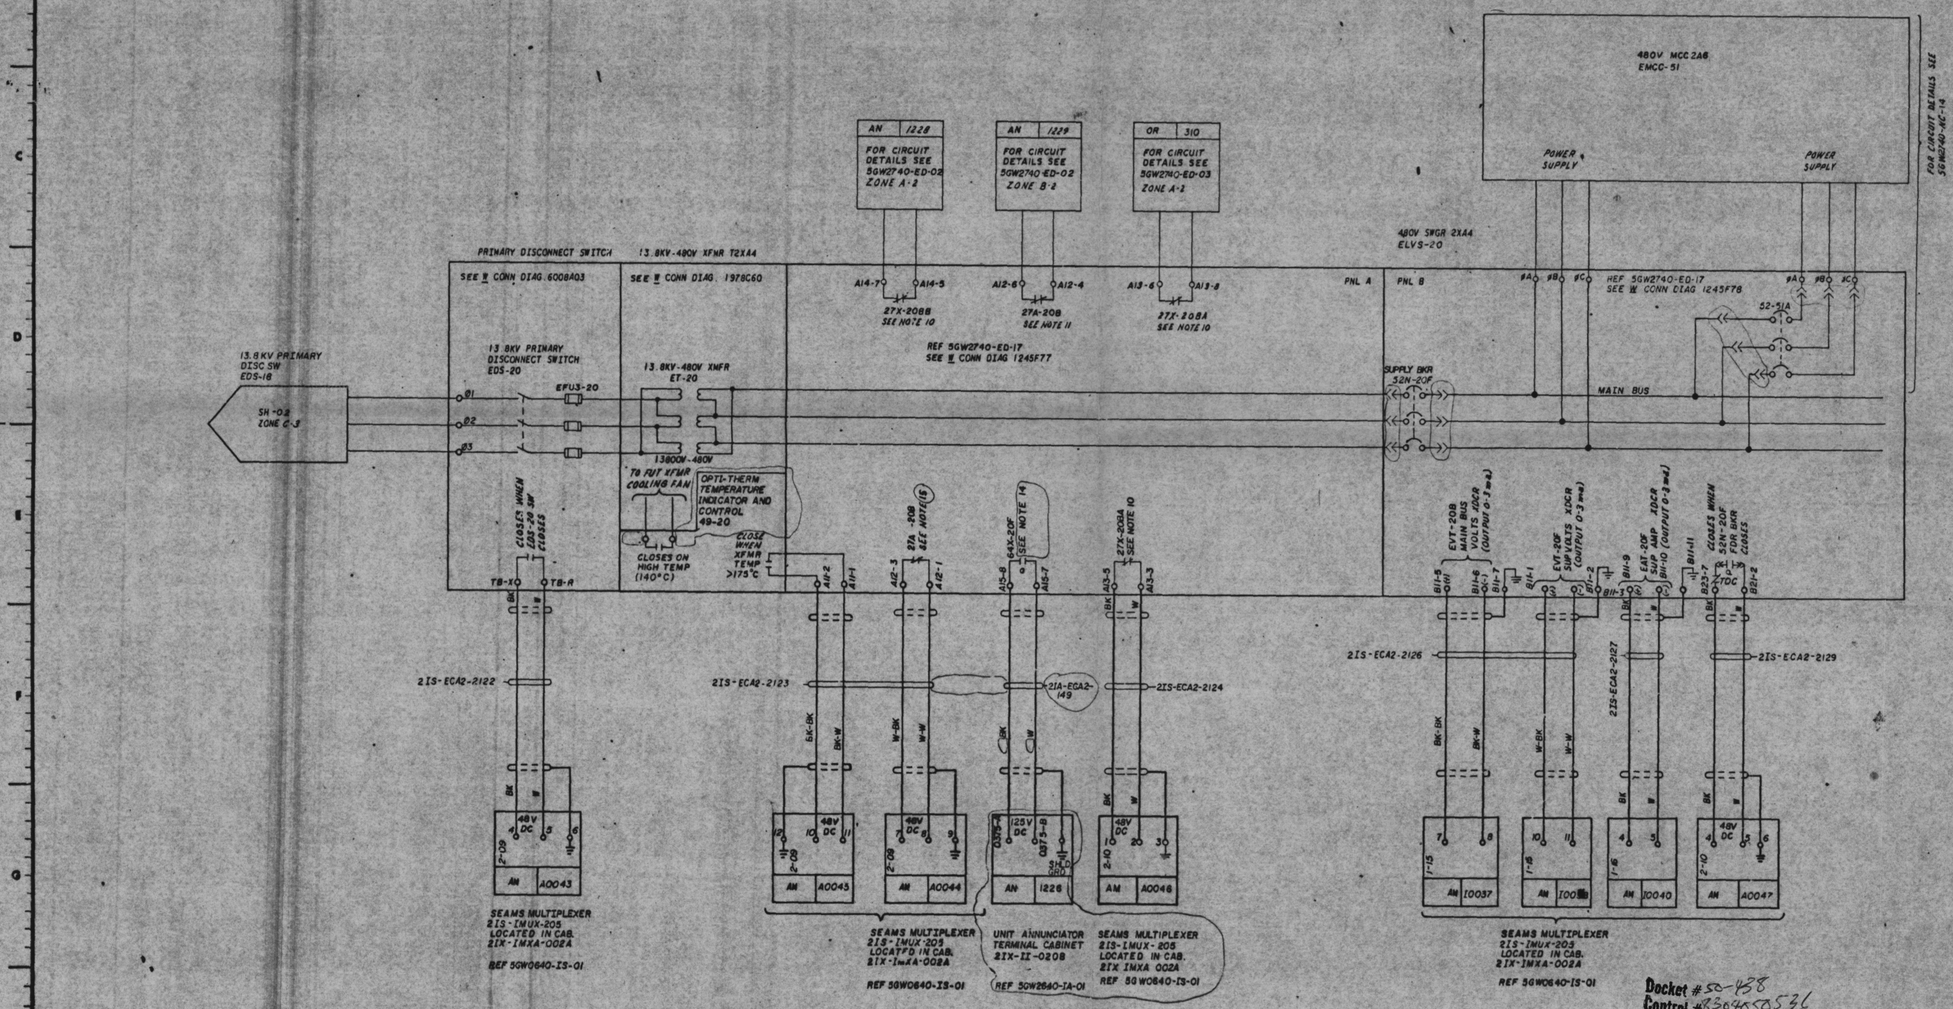

PRC APERTURE CARD

REV NO.	ECN NO.	DATE	DRAWN	DESIGN	CHECKED	SUPV	COORD	INSP	SUBMIT	RECOM	APPRO
1	31	9-21-79	2286	PAT	TRD	JS	JAB	—	GAP	LJS	JMB

MINOR CHANGES.

DRAWN — DESIGN — CHKD — SUPV — INSP — ENGINEER

SCALE: EXCEPT AS NOTED

GENERAL
UNIT 2

SYSTEM SCHEMATIC
480V NORMAL AC AUXILIARY
POWER DISTRIBUTION SYSTEM

BELLEFONTE NUCLEAR PLANT
TENNESSEE VALLEY AUTHORITY
DIVISION OF ENGINEERING DESIGN

N

SUBMITTED — RECOMMENDED — APPROVED

KNOXVILLE 12-20-78

88 E 5GW2740-ED-05 01

RECORD DRAWING AS CONSTRUCTED

INSPECTED AND APPROVED FOR ISSUE

Docket #50-438
Control #8304050536
Date 3-25-83 of Document:
REGULATORY DOCKET FILE