NOTES:
1. FOR NOTES AND SYMBOLS SEE SHEET 01.

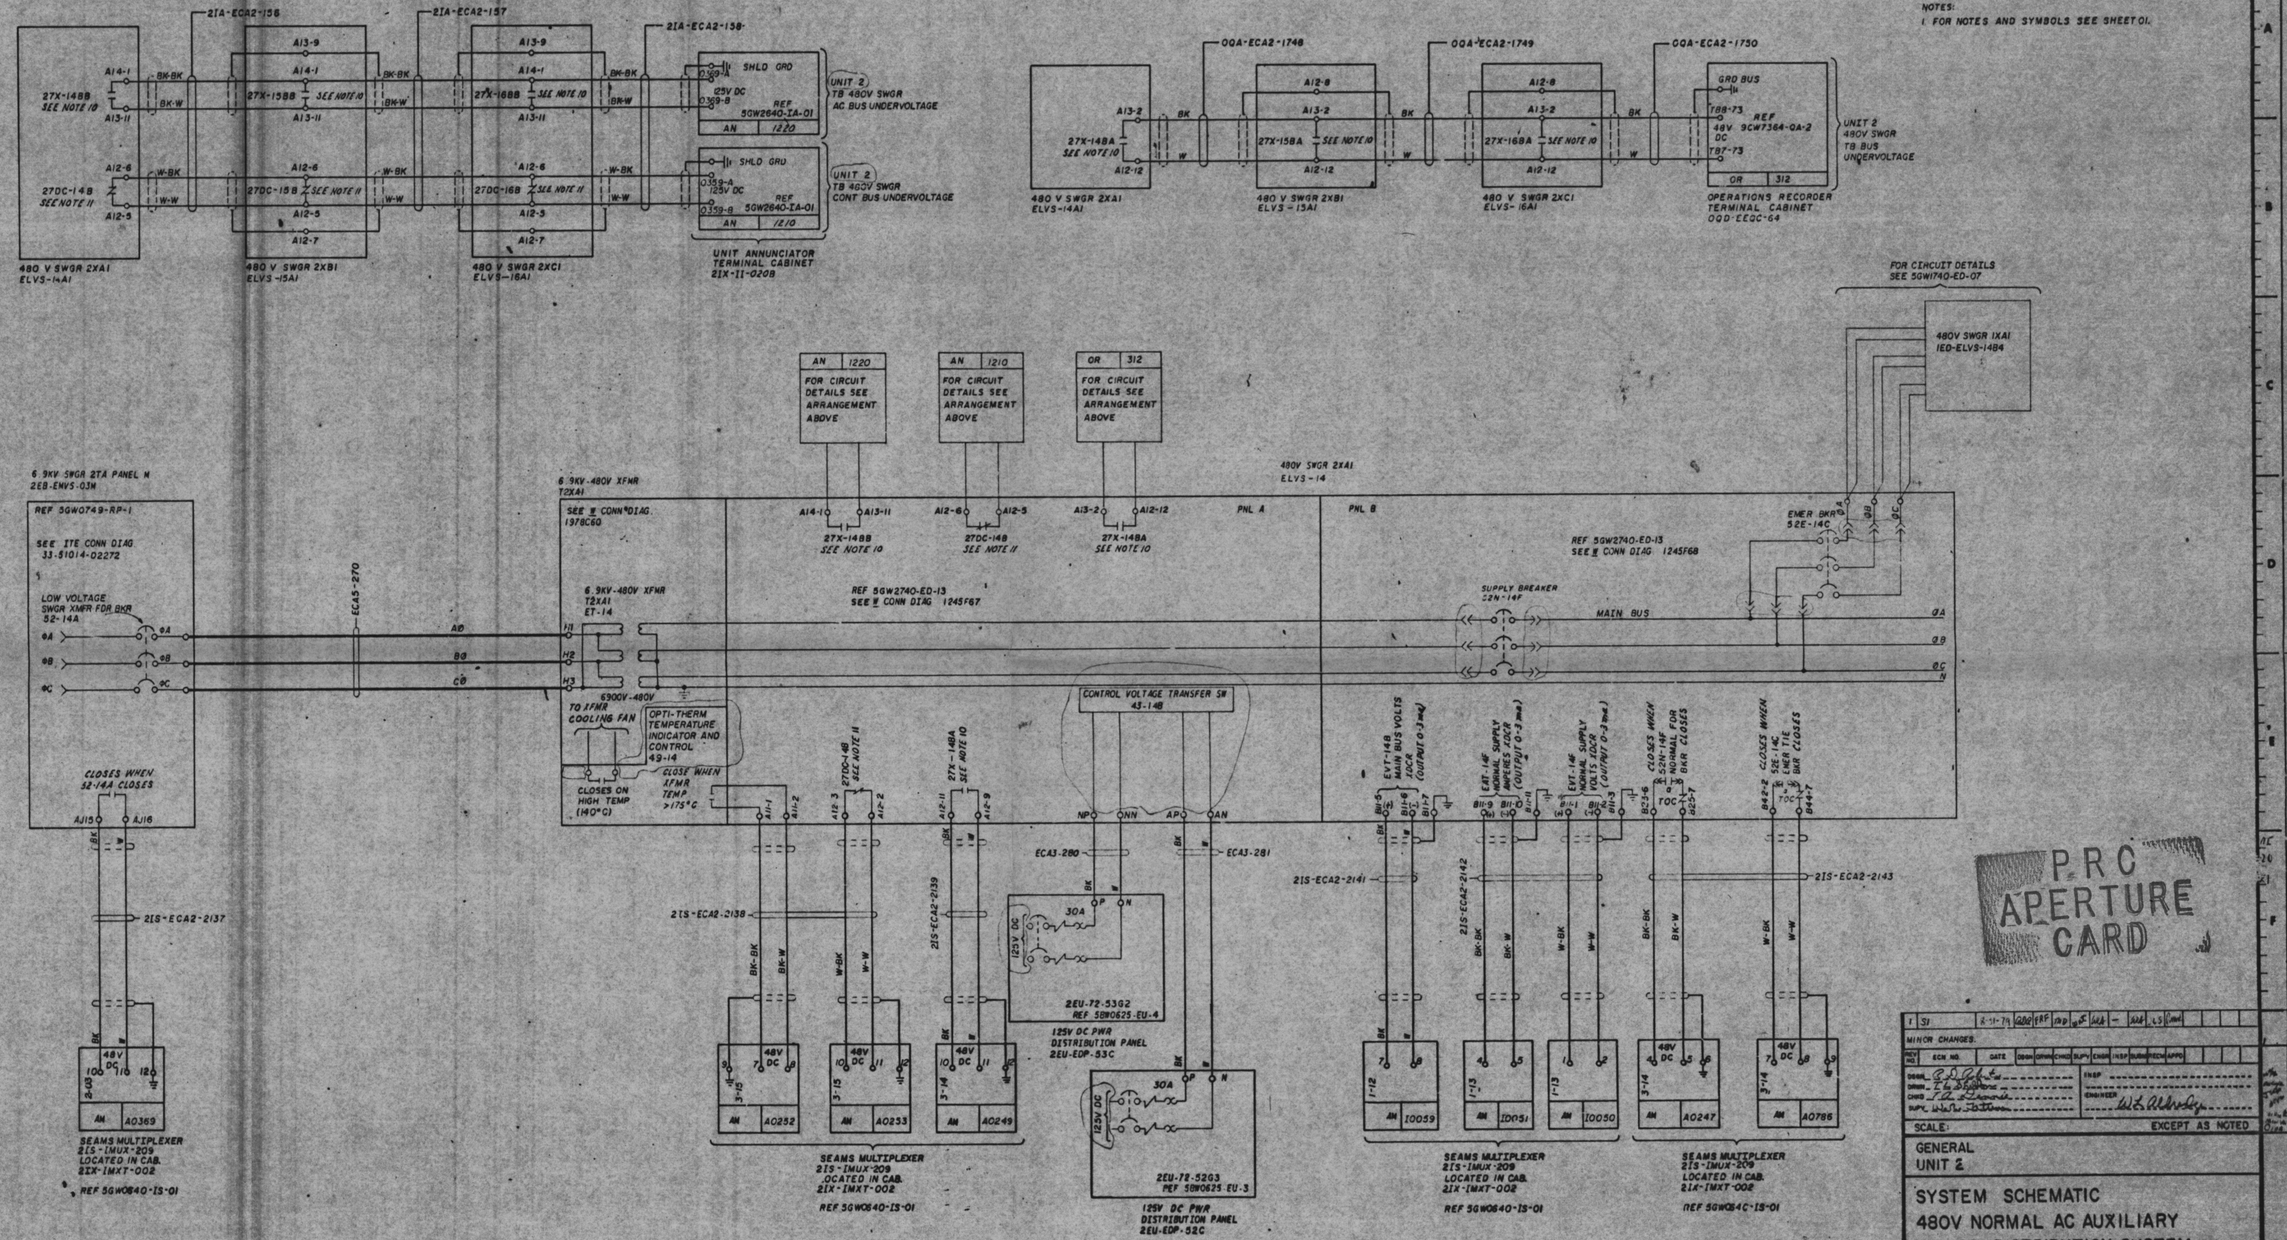

LOW VOLTAGE SWGR 2XA1

P.R.C. APERTURE CARD

MINOR CHANGES.

SCALE: EXCEPT AS NOTED

GENERAL
UNIT 2

SYSTEM SCHEMATIC
480V NORMAL AC AUXILIARY
POWER DISTRIBUTION SYSTEM

BELLEFONTE NUCLEAR PLANT
TENNESSEE VALLEY AUTHORITY
DIVISION OF ENGINEERING DESIGN

N

SUBMITTED / RECOMMENDED / APPROVED

KNOXVILLE

88 E 5GW2740-ED-07 R1

RECORD DRAWING AS CONSTRUCTED

Docket # 50-438
Control # 8304050536
Date 3-25-83 of Document:
REGULATORY DOCKET FILE

INSPECTED AND APPROVED FOR ISSUE