NOTES:
1. FOR NOTES AND SYMBOLS SEE SHEET 01.

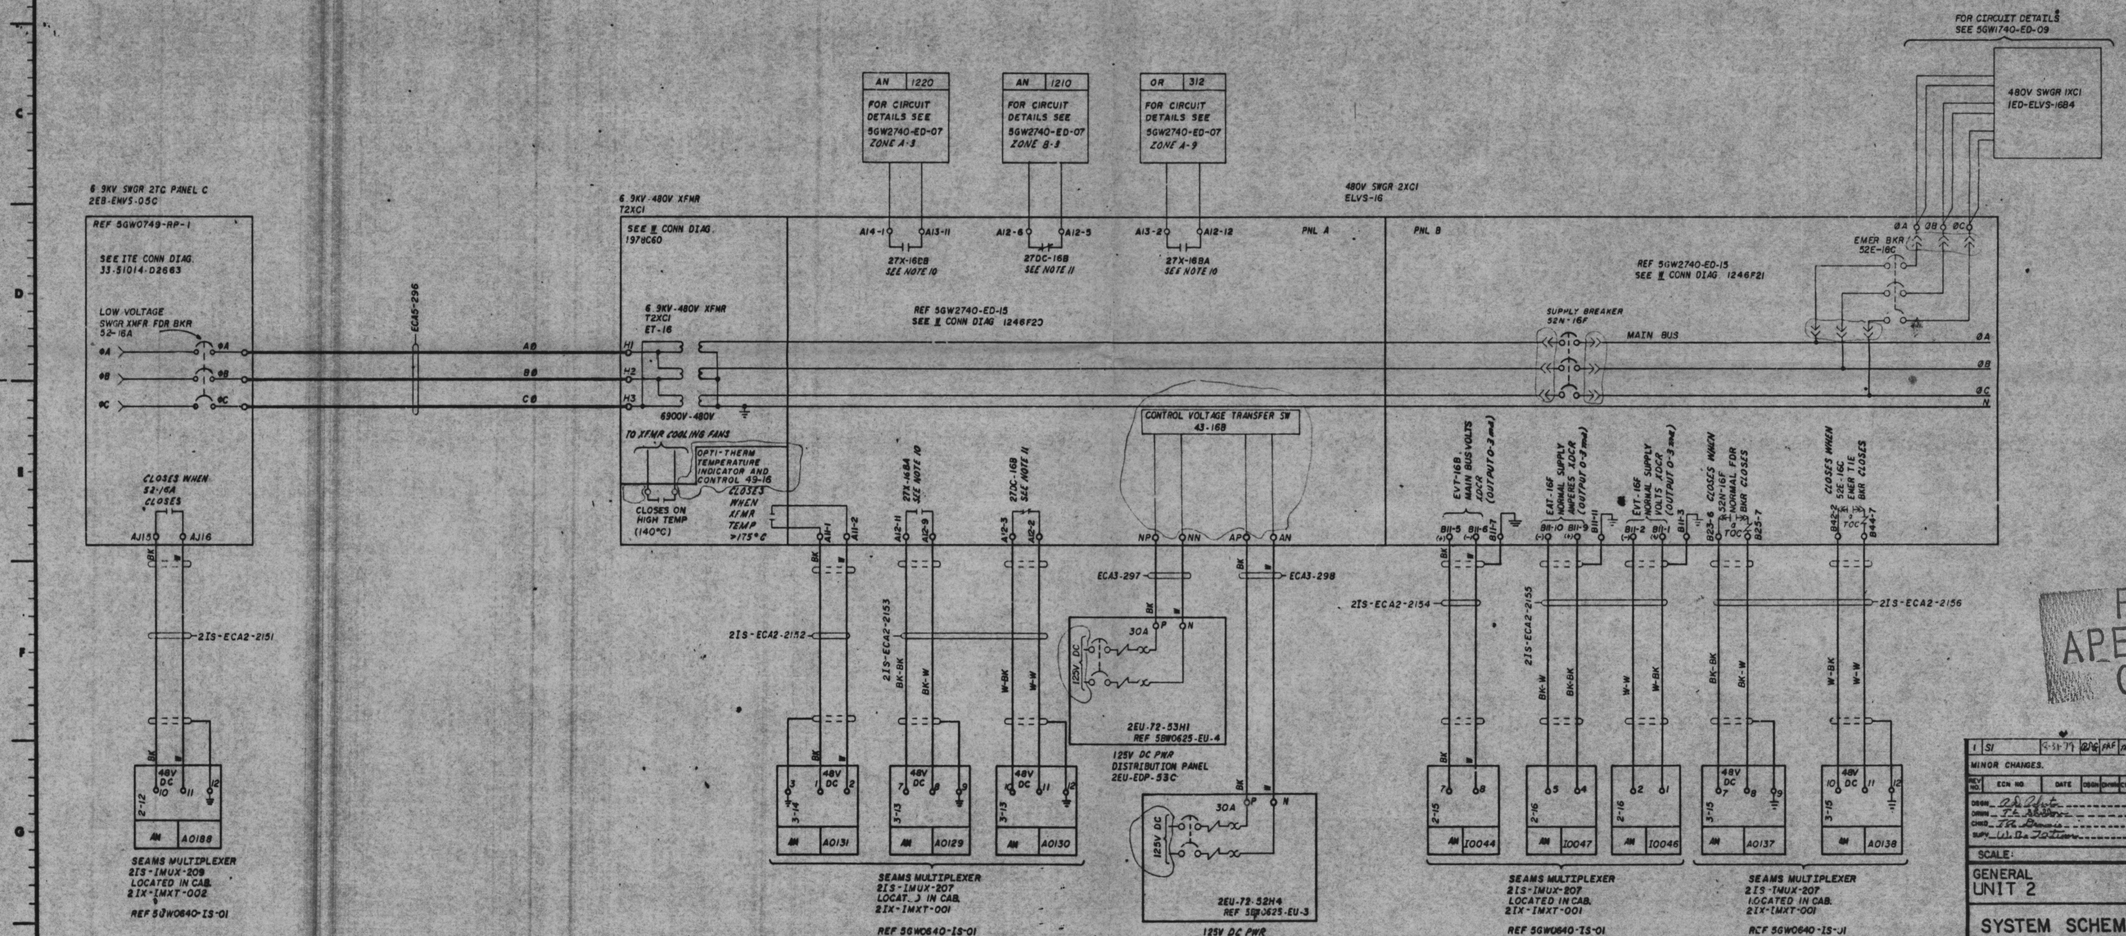

LOW VOLTAGE SWGR 2XC1

PRC APERTURE CARD

MINOR CHANGES.

REV	ECN NO.	DATE	DSGN	DRWN	CHKD	SUPV	CHGR	INSP	SUBM	RECM	APPD
1	S1	5-31-79	RPF								

DSGN. J.D. Pilot
DRWN. J.E. Abbott
CHKD. J.K. Brown
SUPV. W.D. Tolliver
INSP
ENGINEER W.L. Abbitt

SCALE: EXCEPT AS NOTED

GENERAL
UNIT 2

SYSTEM SCHEMATIC
480V NORMAL AC AUXILIARY
POWER DISTRIBUTION SYSTEM

BELLEFONTE NUCLEAR PLANT
TENNESSEE VALLEY AUTHORITY
DIVISION OF ENGINEERING DESIGN

N

SUBMITTED W.L. Abbitt
RECOMMENDED
APPROVED R.W. Hodges

KNOXVILLE 12-26-78 88 E 5GW2740-ED-09 R1

RECORD DRAWING AS CONSTRUCTED

Docket # 50-438
Control # 8304050536
Date 3-25-83 of Document:
REGULATORY DOCKET FILE

INSPECTED AND APPROVED FOR ISSUE