480V AC LIGHTING BOARD 6 (COMPARTMENTS)

CONTINUED FROM DWG 5GW0747-EL-06

NOTES:
1. FOR GENERAL NOTES AND SYMBOLS SEE DWG 5GW0747-EL-01

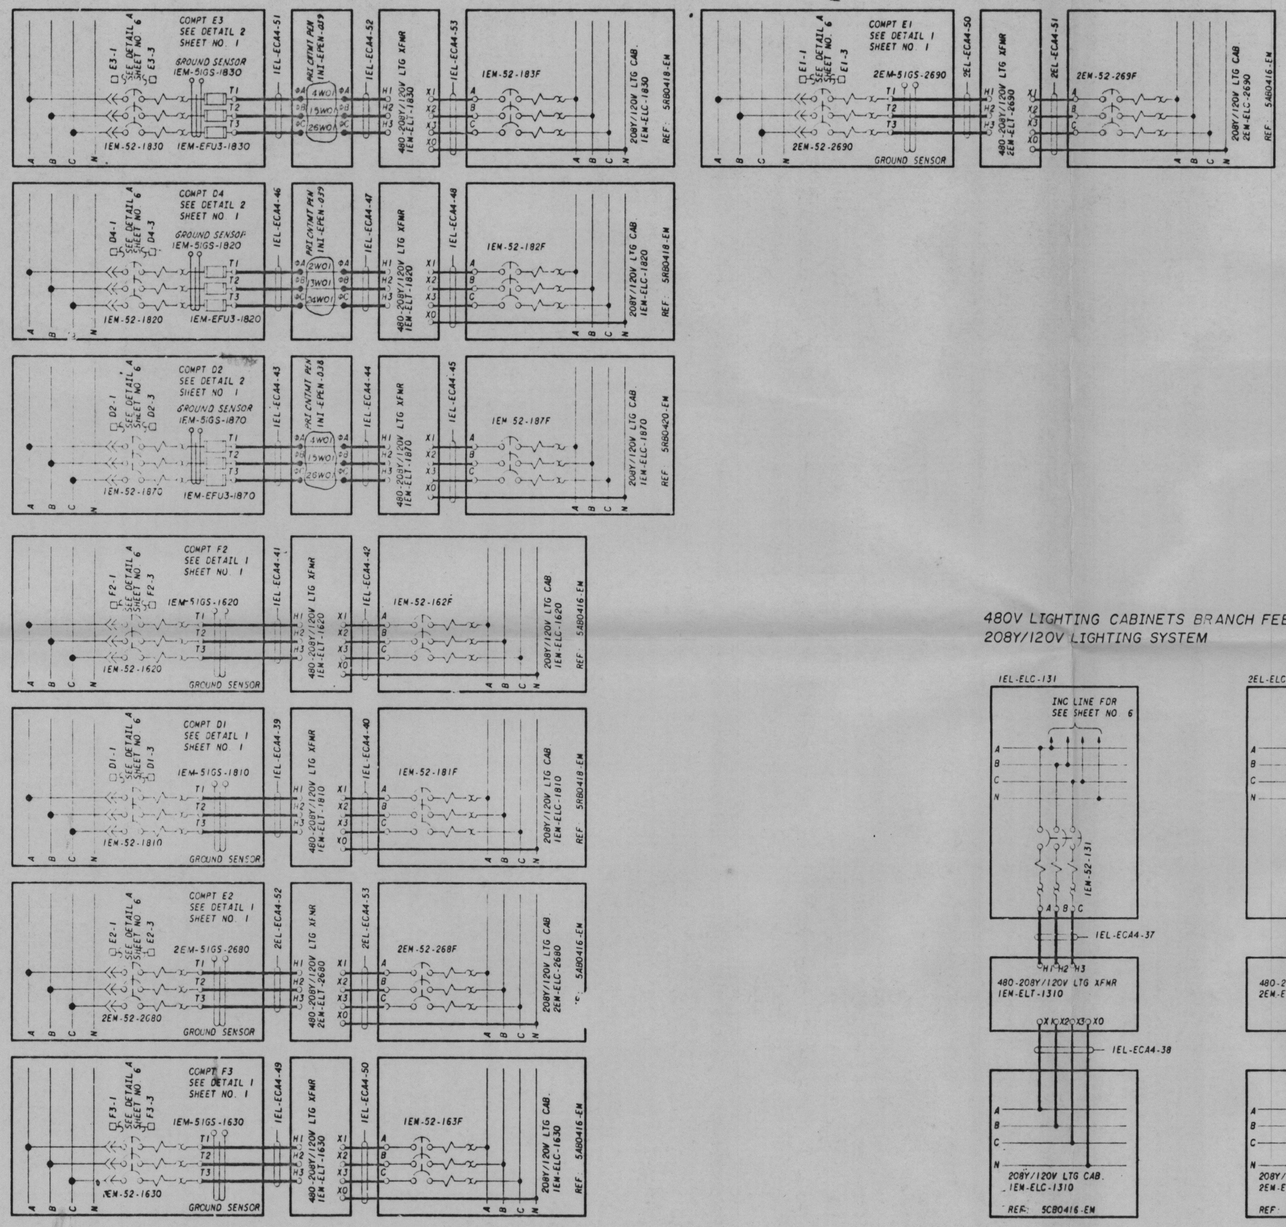

480V LIGHTING CABINETS BRANCH FEEDERS TO 208Y/120V LIGHTING SYSTEM

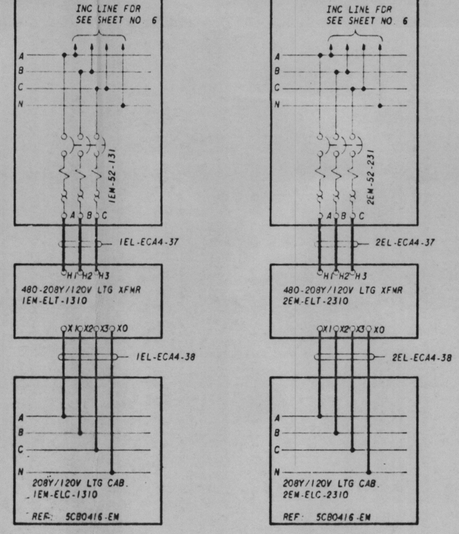

PRC APERTURE CARD

Docket # 8-438
Control # 8304050536
3-25-83

NO	ECN NO	DATE	DSGN	DRWN	CHKD	SUPV	ENGR	NSP	SUBMITTED	CHKD	APPD
2	S1	7-7-83	SDH	DWS	SCM	WS	WLA	–	SLA	DLS	WHE
1	S1	3-25-83	BEM	DWS	SCM	WS	WLA	–	WLA	DLS	WHE

CHANGED PEN WIRE NO. REMOVED EL & COL.
PEN. SPLICE SYMBOL ADDED

DSGN BE Mauldin
DRWN EDD
CHKD W.L. Adams
SUPV W.L. Adams
NSP
ENGINEER W.L. Adams

SCALE EXCEPT AS NOTED

GENERAL
UNITS 1&2

WIRING DIAGRAM NORMAL AC LIGHTING FEEDERS

BELLEFONTE NUCLEAR PLANT
TENNESSEE VALLEY AUTHORITY
DIVISION OF ENGINEERING DESIGN

N

SUBMITTED	RECOMMENDED	APPROVED
W.L. Adams	L.M. Mills	K. Whaley

INSPECTED AND APPROVED FOR ISSUE

KNOXVILLE 2-7-78

88 E 5GW0747-EL-07 R2

RECORD DRAWING AS CONSTRUCTED