480V AC LIGHTING BOARD 6 (COMPARTMENTS)

CONTINUED FROM DWG 5GW0747-EL-06

NOTES:
1. FOR GENERAL NOTES AND SYMBOLS SEE DWG 5GW0747-EL-01

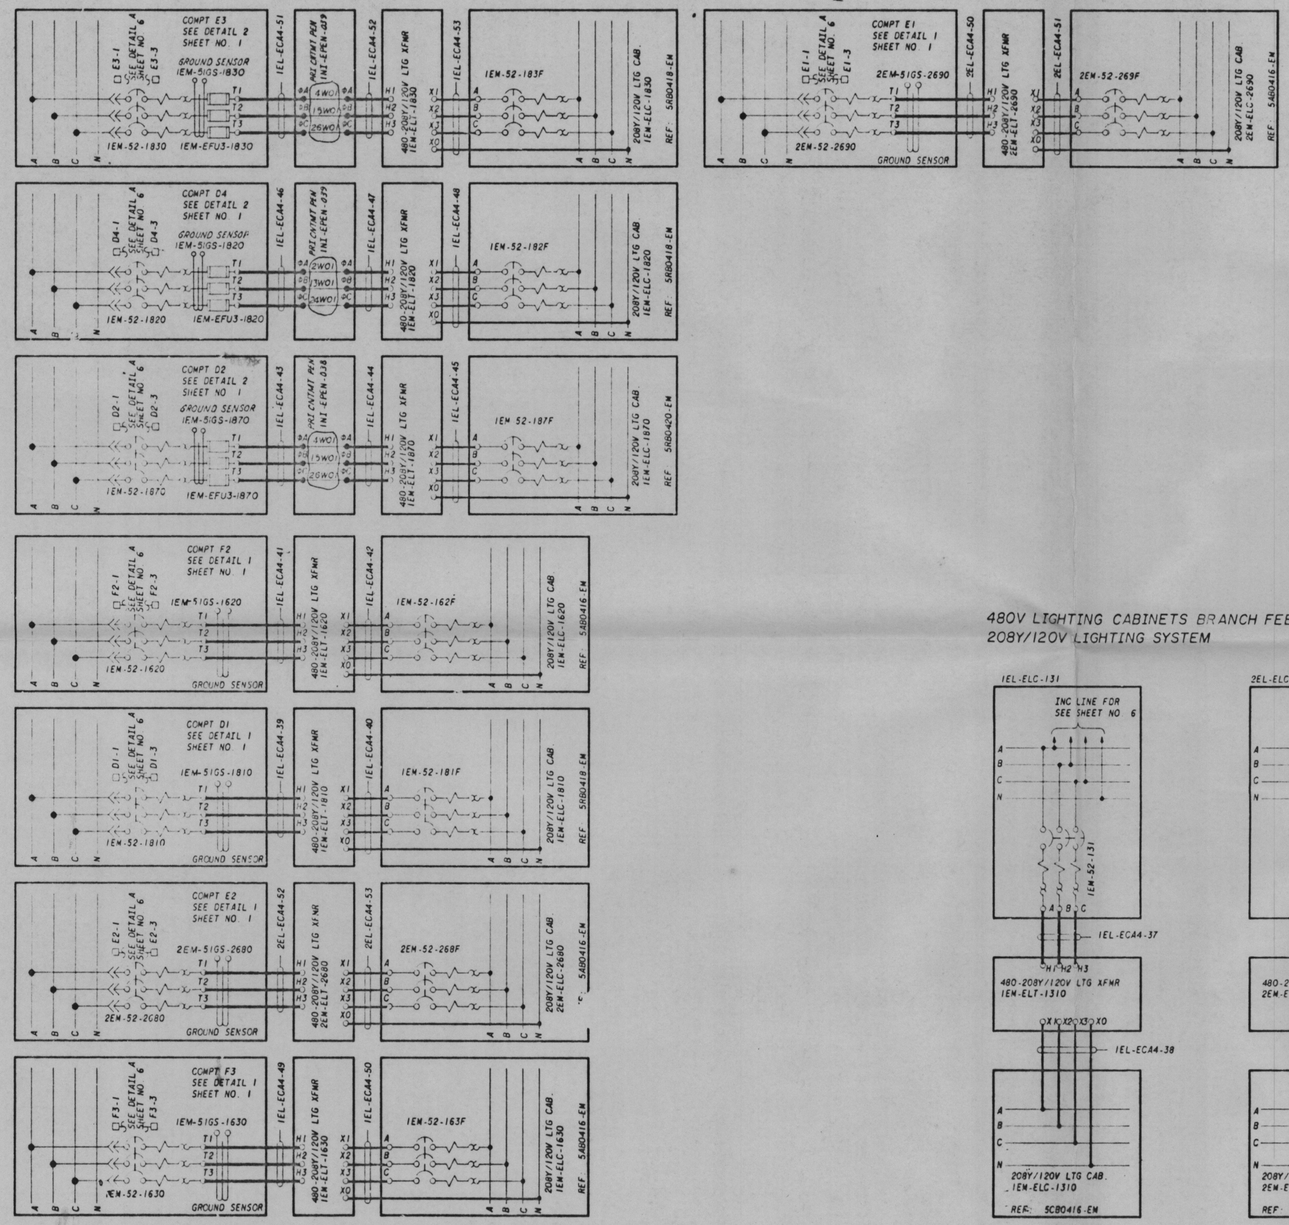

480V LIGHTING CABINETS BRANCH FEEDERS TO 208Y/120V LIGHTING SYSTEM

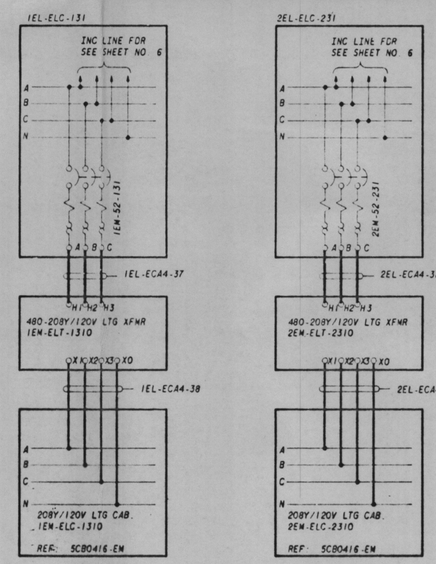

Design # 83-438
Control # 830405836
7-25-83

PRC APERTURE CARD

2	S1	7-7-83										
CHANGED PEN WIRE NO. REMOVED EL & COL.												
1	S1	3-25-77										
PEN. SPLICE SYMBOL ADDED												
REV NO	ECN NO	DATE	DSGN	DRWN	CHKD	SUPV	ENGR	NSP	SUBMITTED	RECM	APPD	

DSGN R.E. Mitchell
DRWN E.B.D.
CHKD
SUPV W.R. Patton
NSP
ENGINEER W.L. Elledge

SCALE EXCEPT AS NOTED

GENERAL
UNITS 1&2

WIRING DIAGRAM
NORMAL AC
LIGHTING FEEDERS

BELLEFONTE NUCLEAR PLANT
TENNESSEE VALLEY AUTHORITY
DIVISION OF ENGINEERING DESIGN

N

SUBMITTED	RECOMMENDED	APPROVED
W.L. Elledge	J.L. Spencer	R. Wheeler

INSPECTED AND APPROVED FOR ISSUE

KNOXVILLE 2-7-78 88 E 5GW0747-EL-07 R2

RECORD DRAWING AS CONSTRUCTED