NOTES:
1. FOR GENERAL NOTES AND REFERENCE DRAWINGS SEE SGW1640-CF-01.
2. SEE SGW1640-SE-01 FOR TURBINE DRAINS FUNCTION GROUP SWITCH, ISE-IXIS-935F.

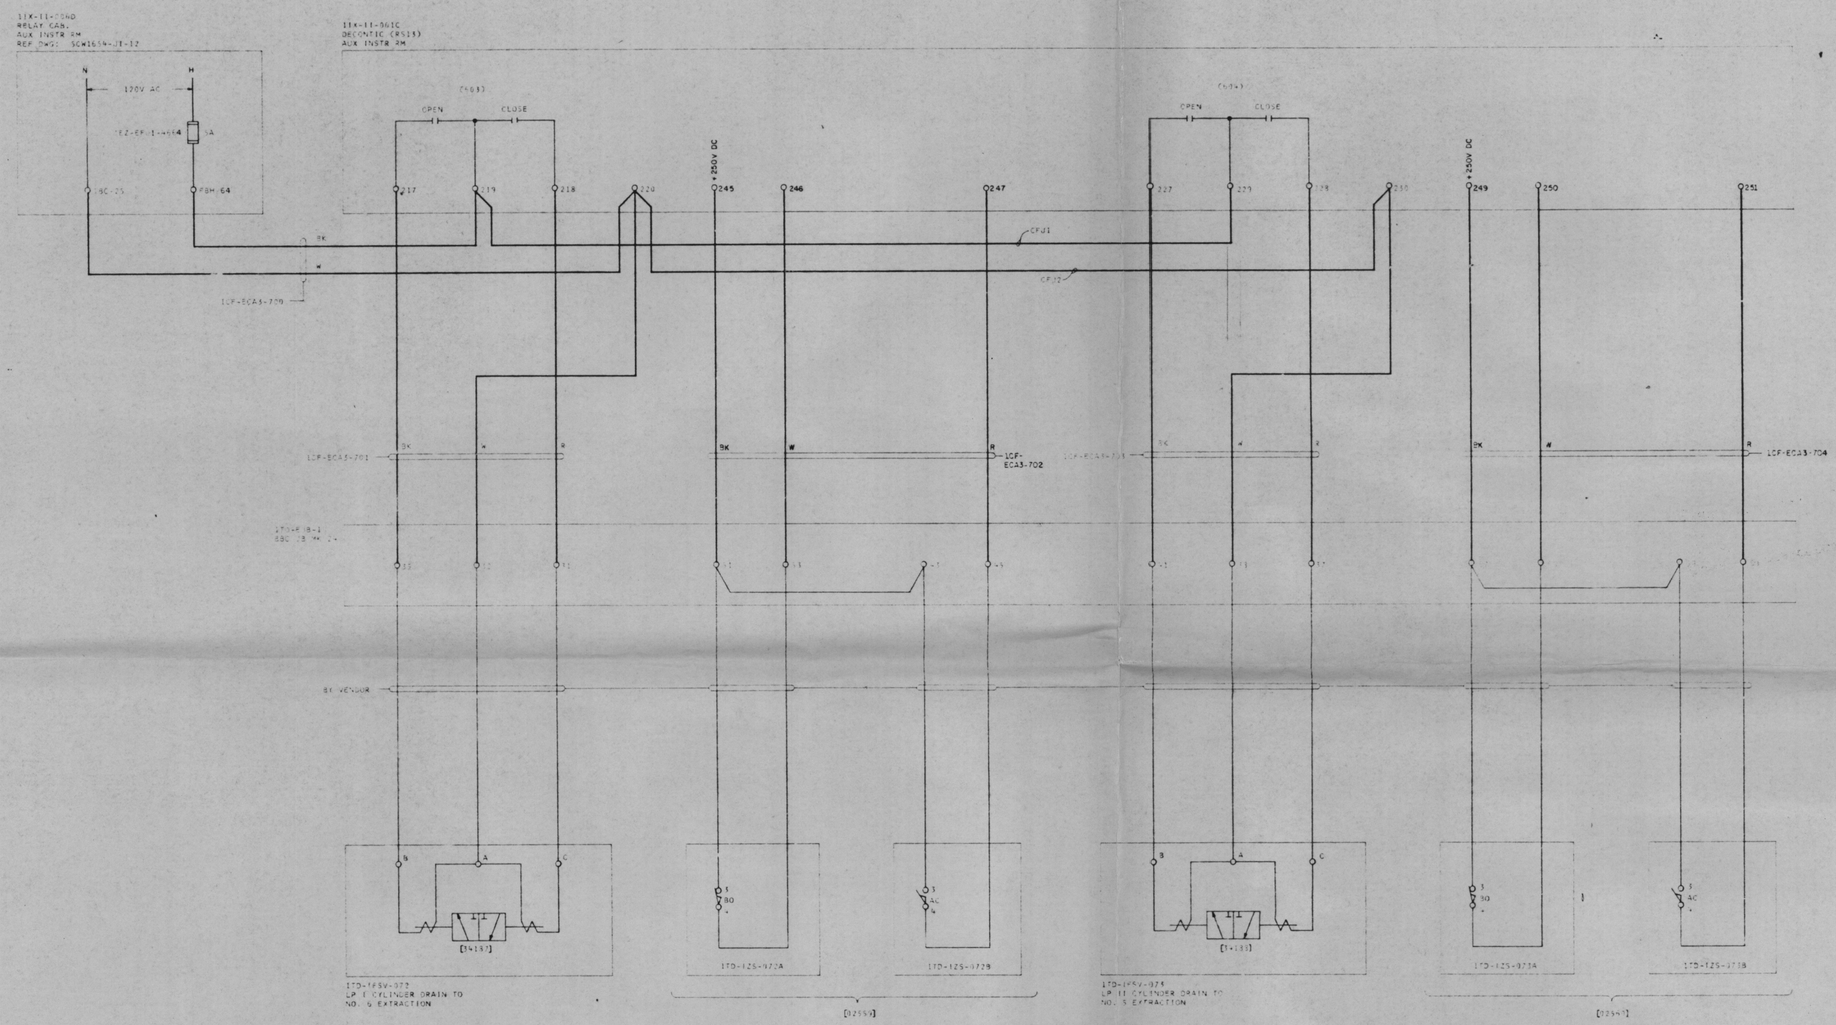

Docket # 50-438
Control # 9804050536
Date 3-25-83 of Document:
REGULATORY DOCKET FILE

Docket #
Control #
Date of Documents
REGULATORY DOCKET FILE

PRC APERTURE CARD

RO RELEASED FOR ECN 1386

REV NO.	ECN NO.	DATE	DSGN	DRWN	CHK	SUPV	ENGR	INSP	SUBM	RECM	APPD

DSGN B.A. Mize
DRWN L.A. Deb
CHKD
SUPV
INSP
ENGINEER M. Lawson

SCALE NTS — EXCEPT AS NOTED

GENERAL
UNIT 1

SCHEMATIC DIAGRAM
FEEDWATER SYSTEM

BELLEFONTE NUCLEAR PLANT
TENNESSEE VALLEY AUTHORITY
DIVISION OF ENGINEERING DESIGN

N

SUBMITTED M. W. Harwood
RECOMMENDED
APPROVED R. M. Hodges

KNOXVILLE 1-9-82 | 88 | E | SGW1640-CF-42 | RO

RECORD DRAWING AS CONSTRUCTED

INSPECTED AND APPROVED FOR ISSUE

PRINT
SIZE
BR IN PROJ. ME EE CE AD CD ES MC IN BL TA
PRINTS REQD.