Docket # 50-390/391
Control # 8304290238
Date 3-25-83
of Document
REGULATORY DOCKET FILE

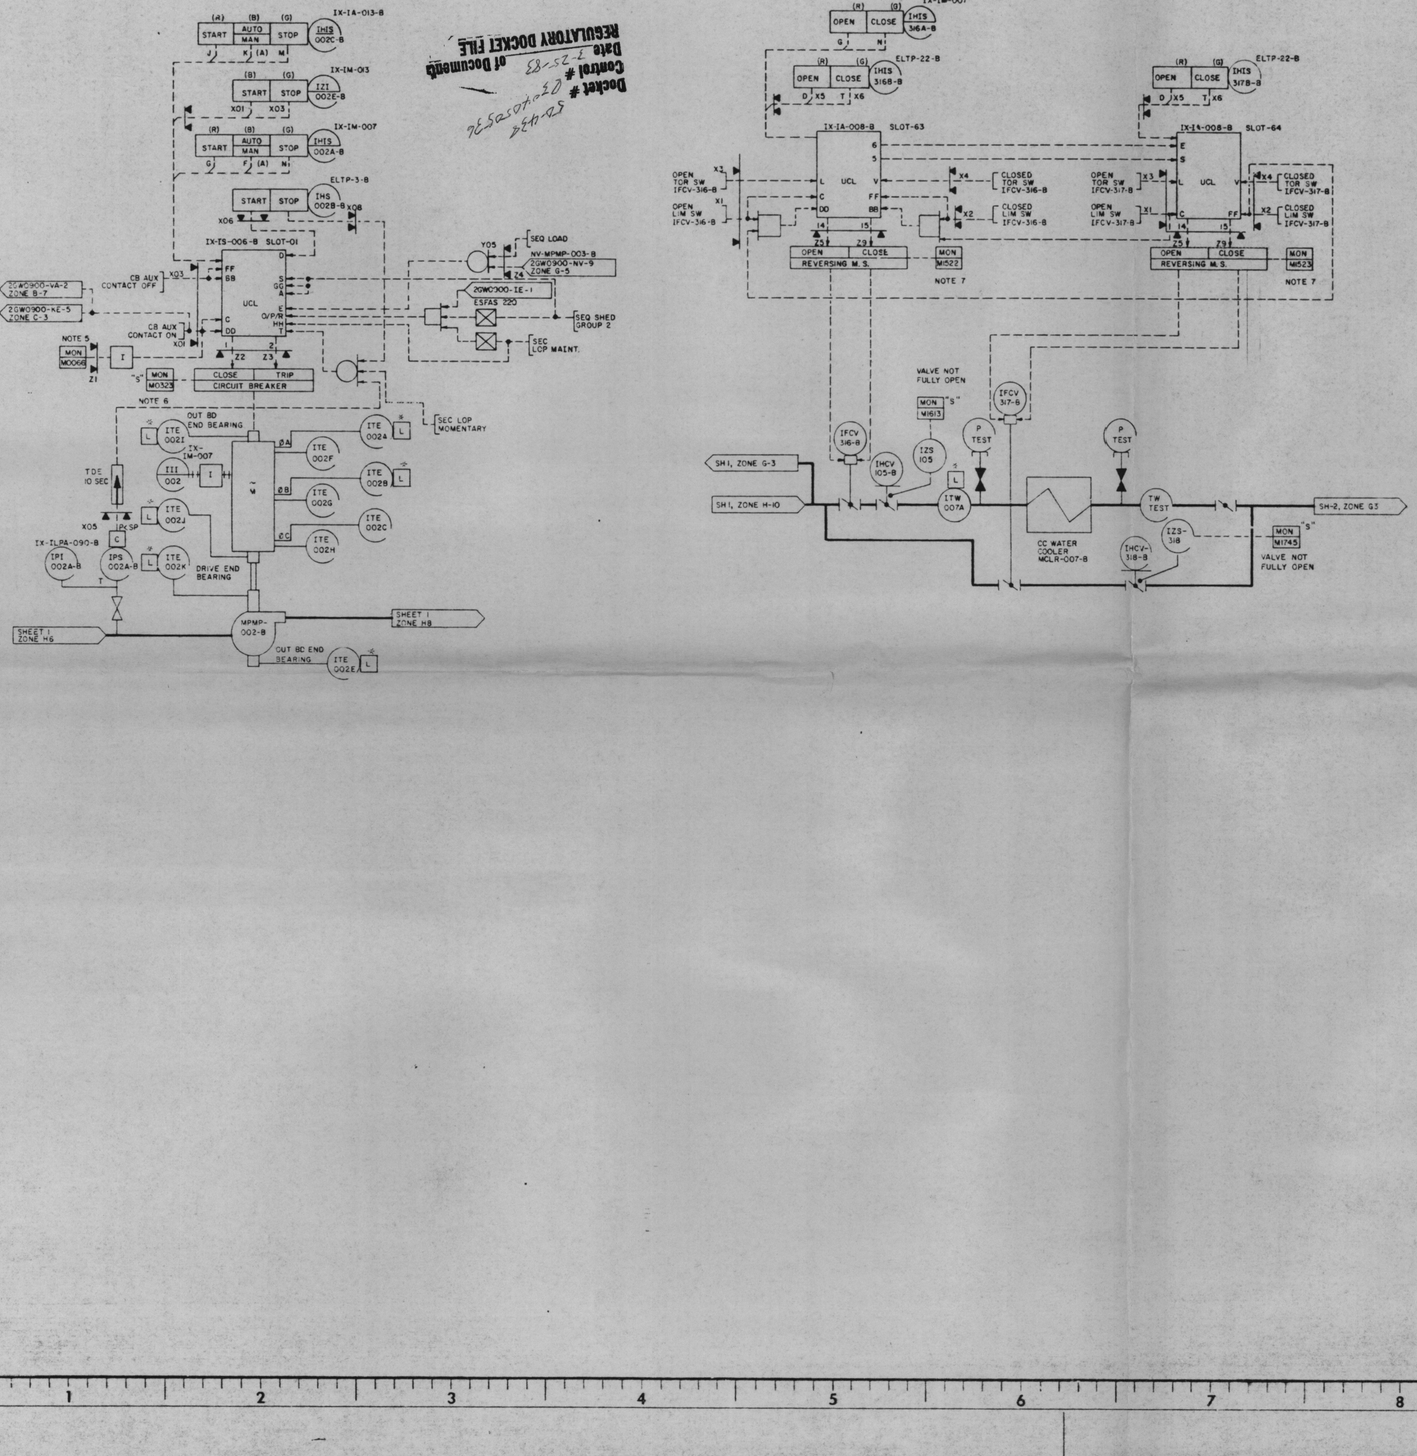

SEE SHEET 3 FOR NOTES

PRC APERTURE CARD

REV NO	ECN NO	DATE	DSGN	DRWN	CHK	SUPV	ENGR	INSP'G	MNTNCE	APPD
			T.R. Greene	ROGER LIEBKE	D.W. Pfaller	W.B. Tatum				

SCALE: NONE EXCEPT AS NOTED

GENERAL
UNITS 1 & 2

FUNCTIONAL CONTROL LOGIC DIAG COMPONENT COOLING WATER SYS

BELEFONTE NUCLEAR PLANT
TENNESSEE VALLEY AUTHORITY
DIVISION OF ENGINEERING DESIGN

Q

SUBMITTED	RECOMMENDED	APPROVED

KNOXVILLE 6-23-82 88 E 2GW0900-KC-8 R0

RECORD DRAWING AS CONSTRUCTED

FIRST ISSUE FOR ECN 1429

FURTHER REVIEW
CEB N.A.
EEB F.W. Standerfer
MEB N.A.
NEB N.A.
INSPECTED AND APPROVED FOR ISSUE

FSAR FIG 9.2.2-12A