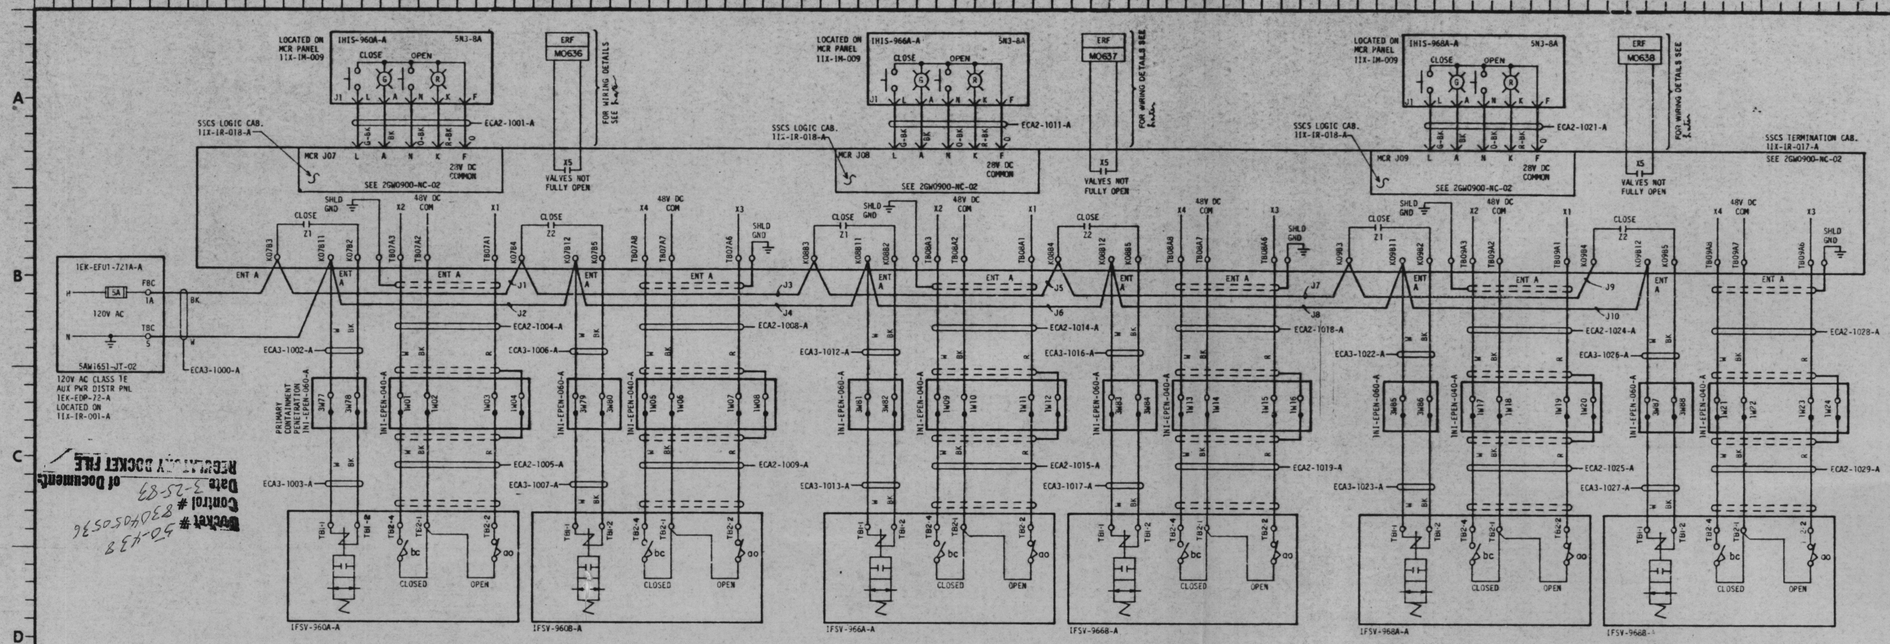

ILT-004A-D PRIMARY CONTAINMENT INSTRUMENTATION LINES ISOLATION VALVES

ILT-004C-F PRI CNTMT INSTR LINES ISOLATION VALVES

ILT-004E-A PRI CNTMT INSTR LINES ISOLATION VALVES

NOTES:

1. FOR GENERAL NOTES SEE SHEET 01.

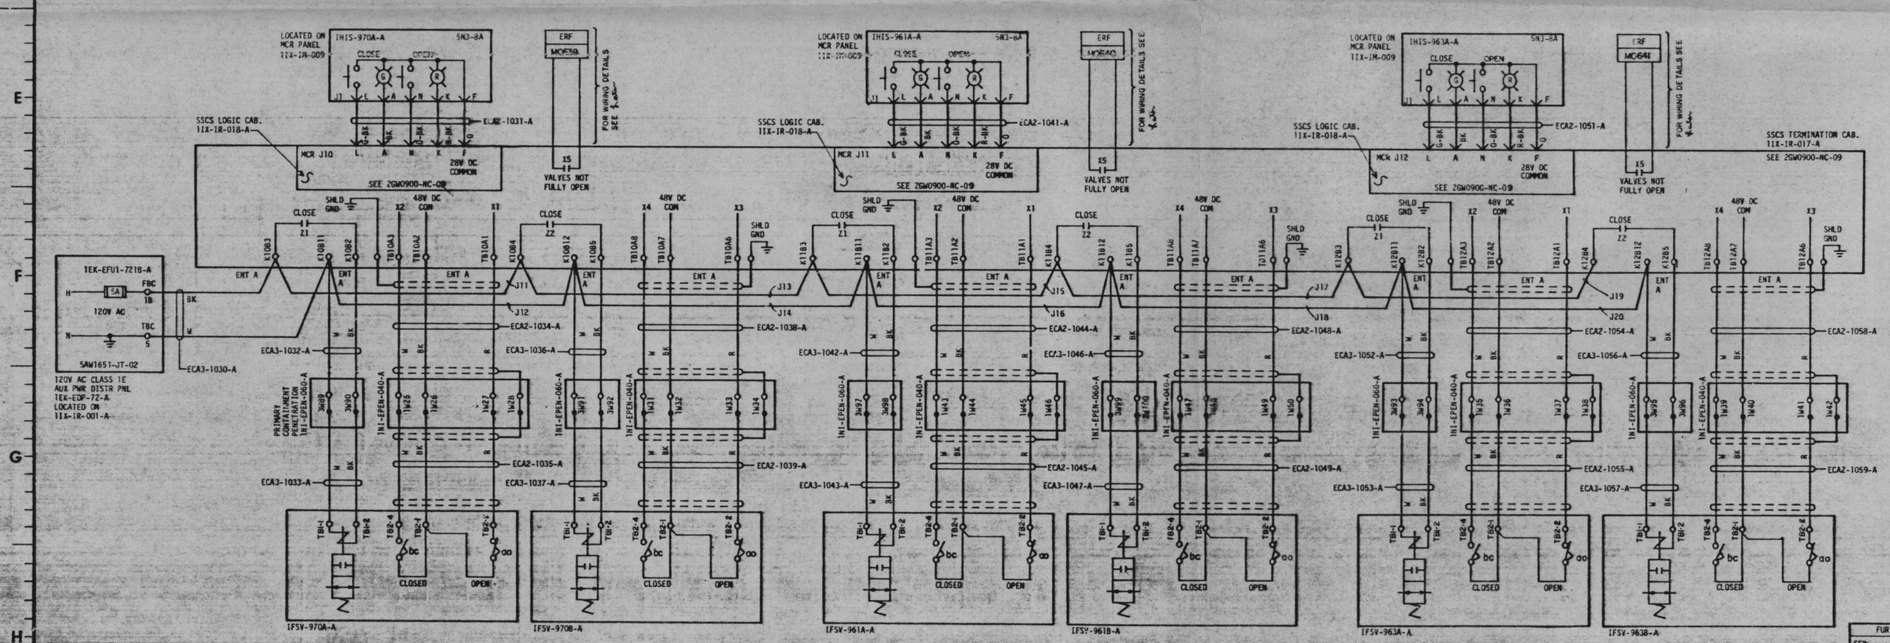

ILT-001A-A PRI CNTMT INSTR LINES ISOLATION VALVES

ILT-951-A PRI CNTMT INSTR LINES ISOLATION VALVES

ILT-953-A PRI CNTMT INSTR LINES ISOLATION VALVES

FIRST ISSUE FOR ECN 1027

PRC APERTURE CARD

REV NO.	ECN NO.	DATE	DSGN	DRWN	CHKD	SUPV	CHKR	MGR	CLR	MGR	APPD

DSGN: [illegible] INSP:
DRWN: [illegible] ENGINEER: [illegible]
CHKD: [illegible]
SUPV: [illegible]

SCALE: NTS EXCEPT AS NOTED

GENERAL
UNIT 1

SYSTEM SCHEMATIC
REACTOR COOLANT SYS (NC)

BELLEFONTE NUCLEAR PLANT
TENNESSEE VALLEY AUTHORITY
DIVISION OF ENGINEERING DESIGN

Q

SUBMITTED: [illegible] RECOMMENDED: [illegible] APPROVED: [illegible]

KNOXVILLE 8-23-82 | 00 | E | 5GW1740-NC-32 | RD

RECORD DRAWING AS CONSTRUCTED

FURTHER REVIEWED
EEB N/A
CEB N/A
MEB N/A
NEB N/A

INSPECTED AND APPROVED FOR ISSUE

PRINT
SIZE
BR OR PROJ ME EE CE AD CD EO MO SW BL PA
PRINTS REQD-R

