NOTES:
1. FOR GENERAL NOTES SEE SHEET 01.

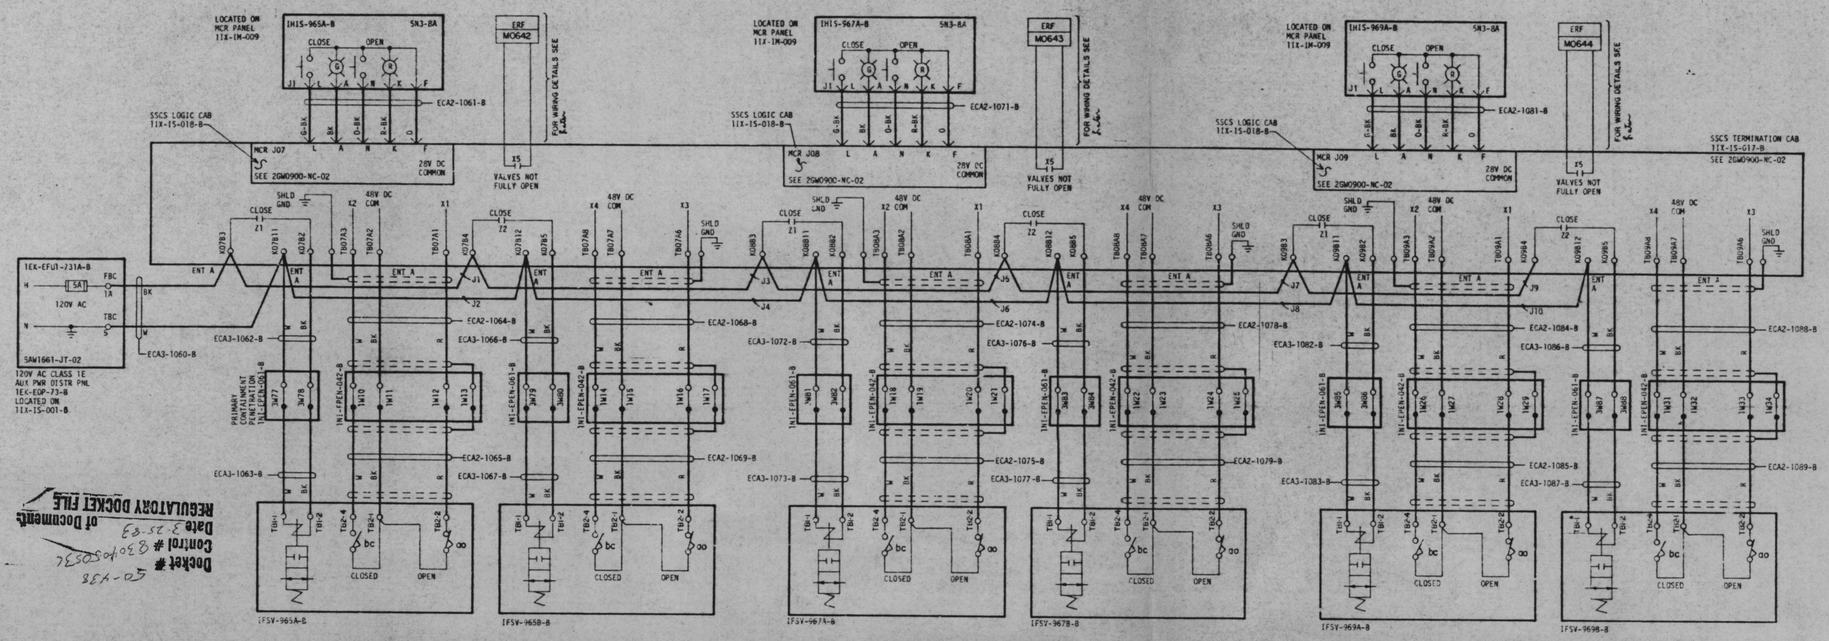

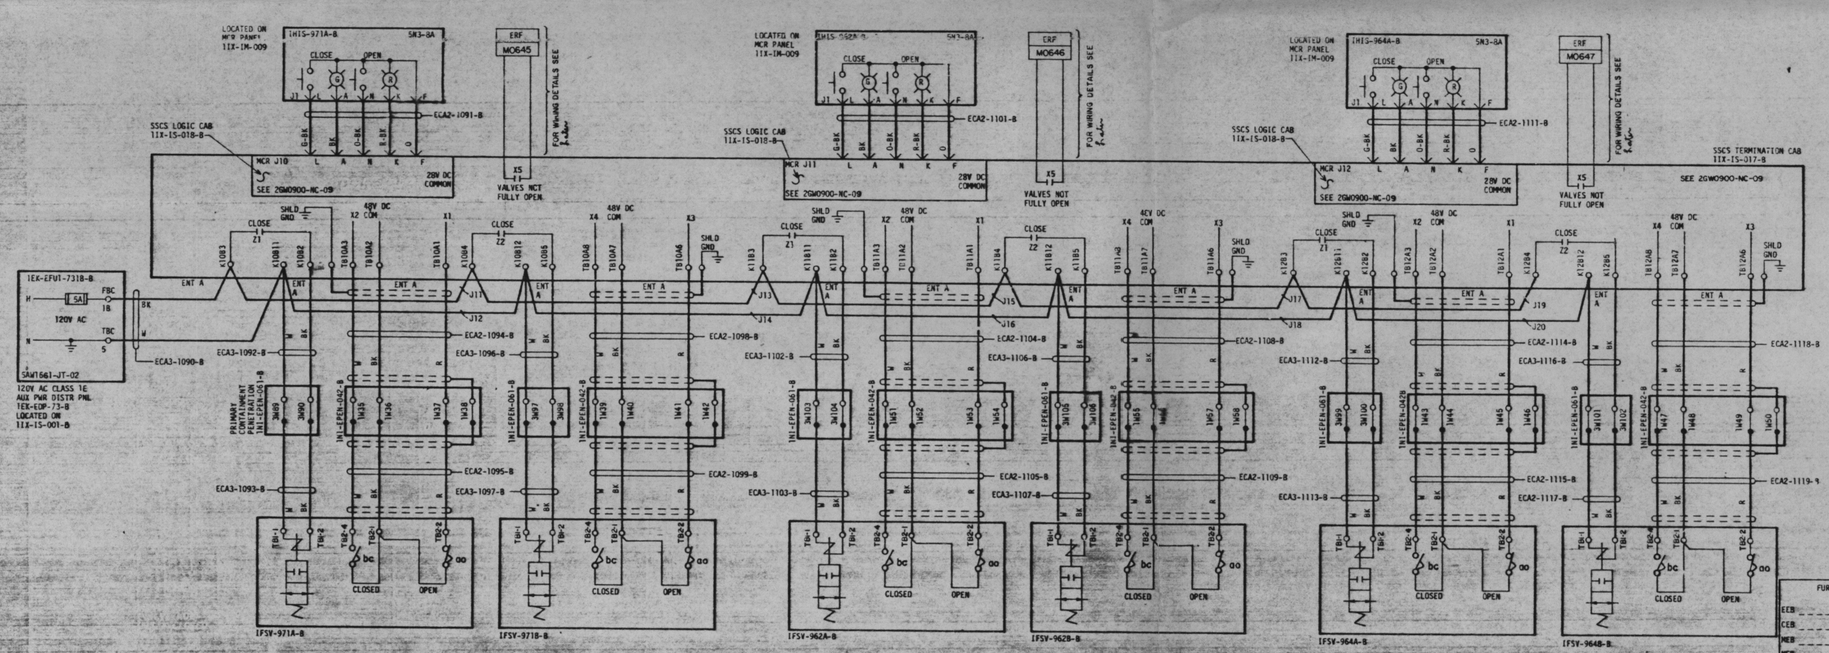

FIRST ISSUE FOR ECN 1027

PRC APERTURE CARD

REV NO.	ECN NO.	DATE	DSGN	DRWN	CHKD	SUPV	CHIEF	DISP	SUBR	MECH	APPD
DSGN	J. Henry Bynum						DISP				
DRWN	J. Scott Duty						ENGINEER				
CHKD	J.D. Nelle										
SUPV	E.M. Marsing										

SCALE: NTS EXCEPT AS NOTED

GENERAL
UNIT 1

SYSTEM SCHEMATIC
REACTOR COOLANT SYS (NC)

BELLEFONTE NUCLEAR PLANT
TENNESSEE VALLEY AUTHORITY
DIVISION OF ENGINEERING DESIGN

Q

SUBMITTED: J.D. Nelle
RECOMMENDED: [illegible]
APPROVED: E.M. Marsing

KNOXVILLE 8-23-82 88 E 5GW1740-NC-33 R0

RECORD DRAWING AS CONSTRUCTED

FURTHER REVIEWED
ECB N/A
CEB N/A
MEB N/A
NEB N/A

INSPECTED AND APPROVED FOR ISSUE

PRINT
SIZE

MF
RD

DOCKET # 50-438
CONTROL # 8304050032
DATE 3-25-83
REGULATORY DOCKET FILE
of Documents