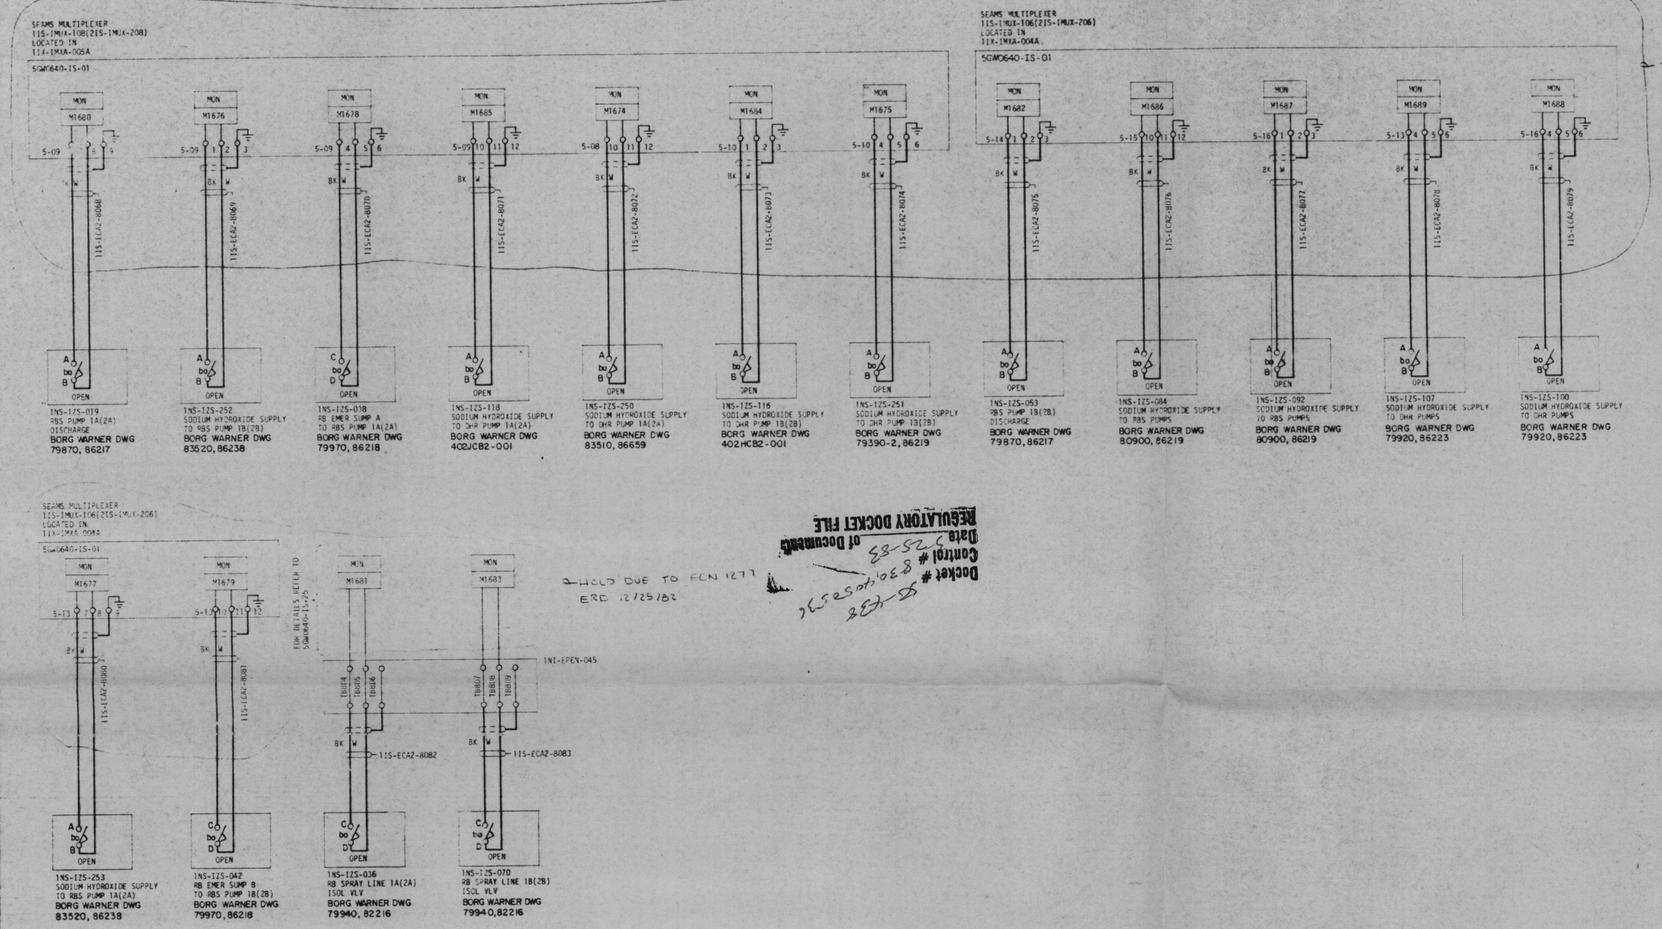

HOLD DUE TO ECN 1277
ERD 12/20/82

HOLD DUE TO ECN 1277
ERD 12/20/82

NOTES:

1. FOR GENERAL NOTES AND REFERENCES SEE 5GW0640-NS-01.
2. ALL LIMIT SWITCHES ARE SHOWN FOR VALVE IN FULLY OPEN POSITION. ALARM NOT-FULLY-OPEN.

PRC APERTURE CARD

Docket # 50-438
Control # 8301050537
Date 1-25-83
of Document
REGULATORY DOCKET FILE

ISSUED FOR ECN 898

REV NO	ECN NO.	DATE	DSGN	DRWN	CHKD	SUPV	ENGR	INSP	SUBM	RECM	APPD

DSGN G. Gibson
DRWN Lynda K. Weber
CHKD L. Fisher
SUPV D.L. Goodson
INSP
ENGINEER M.W. Stewart

SCALE: NTS — XCEPT AS NOTED

GENERAL
UNITS 1 & 2

SCHEMATIC DIAGRAM
REACTOR BLDG SPRAY SYSTEM

BELLEFONTE NUCLEAR PLANT
TENNESSEE VALLEY AUTHORITY
DIVISION OF ENGINEERING DESIGN

N

SUBMITTED M.W. Stewart
RECOMMENDED L. Springer-Lock
APPROVED R.M. Hedgepeth

KNOXVILLE | 1-20-82 | 88 | E | 5GW0640-NS-13 | R0

RECORD DRAWING: AS CONSTRUCTED

INSPECTED AND APPROVED FOR ISSUE

PRINT N
SIZE F
BR OR PROJ ME EE CE AD CO ED MD SW BL PA
PRINTS REQD-R ____