NOTES:
1. FOR GENERAL NOTES AND REFERENCES REFER TO 5GW0640-NO-01.
2. FIELD TO PROVIDE AND INSTALL TERMINAL DESIGNATIONS A,B & C TO MAGNETIC CONTACTOR M.

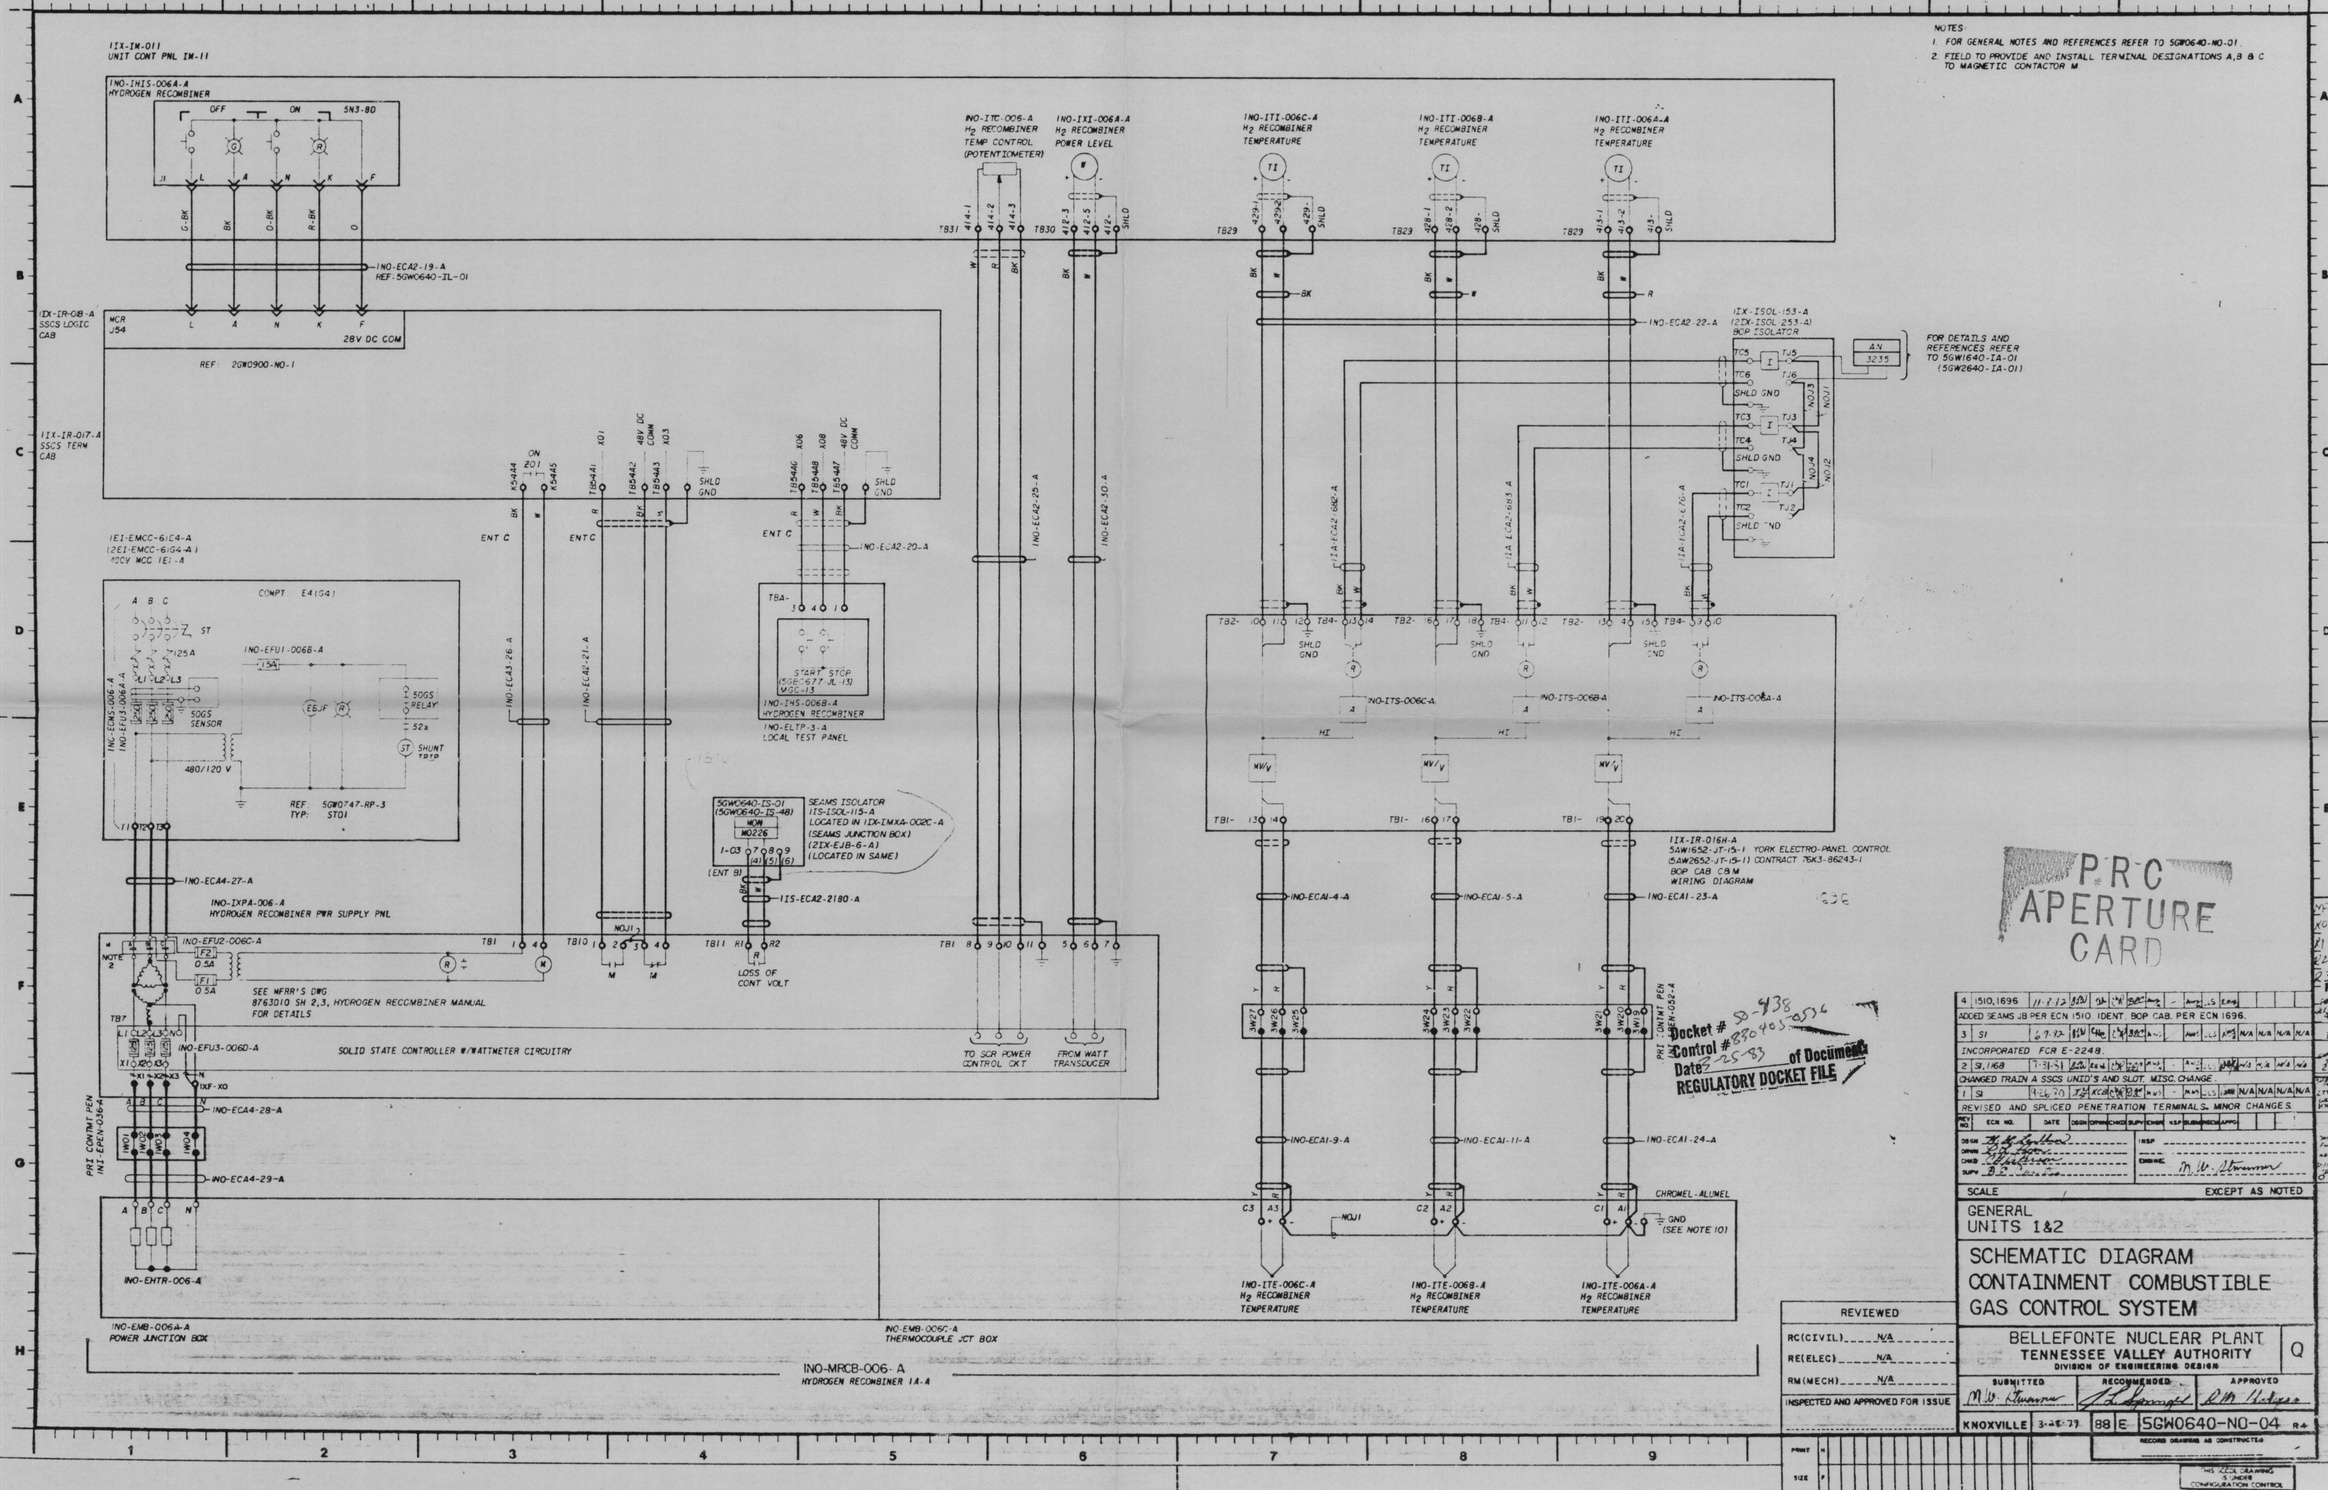

PRC APERTURE CARD

REV	ECN NO.	DATE	DSGN	DFTMN	CHKD	SUPV	ENGR	ASP	RUBN	REC	APPD			
4	1510, 1696	11-2-83												
ADDED SEAMS JB PER ECN 1510 IDENT. BOP CAB. PER ECN 1696.														
3	SI	6-7-82										N/A	N/A	N/A
INCORPORATED FCR E-2249.														
2	SI, 1168	7-31-81										N/A	N/A	N/A
CHANGED TRAIN A SSCS UNID'S AND SLOT. MISC. CHANGE.														
1	SI	12-2-80										N/A	N/A	N/A
REVISED AND SPLICED PENETRATION TERMINALS. MINOR CHANGES.														

DSGN M. W. Lathon
DFTMN D. H. Jackson
CHKD J. Blackburn
SUPV B. J. Davis
INSP
ENGINEER M. W. Stamm

SCALE / EXCEPT AS NOTED

GENERAL
UNITS 1&2

SCHEMATIC DIAGRAM CONTAINMENT COMBUSTIBLE GAS CONTROL SYSTEM

BELLEFONTE NUCLEAR PLANT
TENNESSEE VALLEY AUTHORITY
DIVISION OF ENGINEERING DESIGN

Q

SUBMITTED	RECOMMENDED	APPROVED
M. W. Stamm	J. L. Spangler	R. M. Hodges

KNOXVILLE 3-25-77 | 88 | E | 5GW0640-NO-04 | R4

RECORD DRAWING AS CONSTRUCTED

REVIEWED
RC(CIVIL) N/A
RE(ELEC) N/A
RM(MECH) N/A
INSPECTED AND APPROVED FOR ISSUE

PRINT
SIZE

THIS ICCL DRAWING IS UNDER CONFIGURATION CONTROL

Docket # 50-438
Control # 830405-0516
Date 2-25-83
of Document
REGULATORY DOCKET FILE