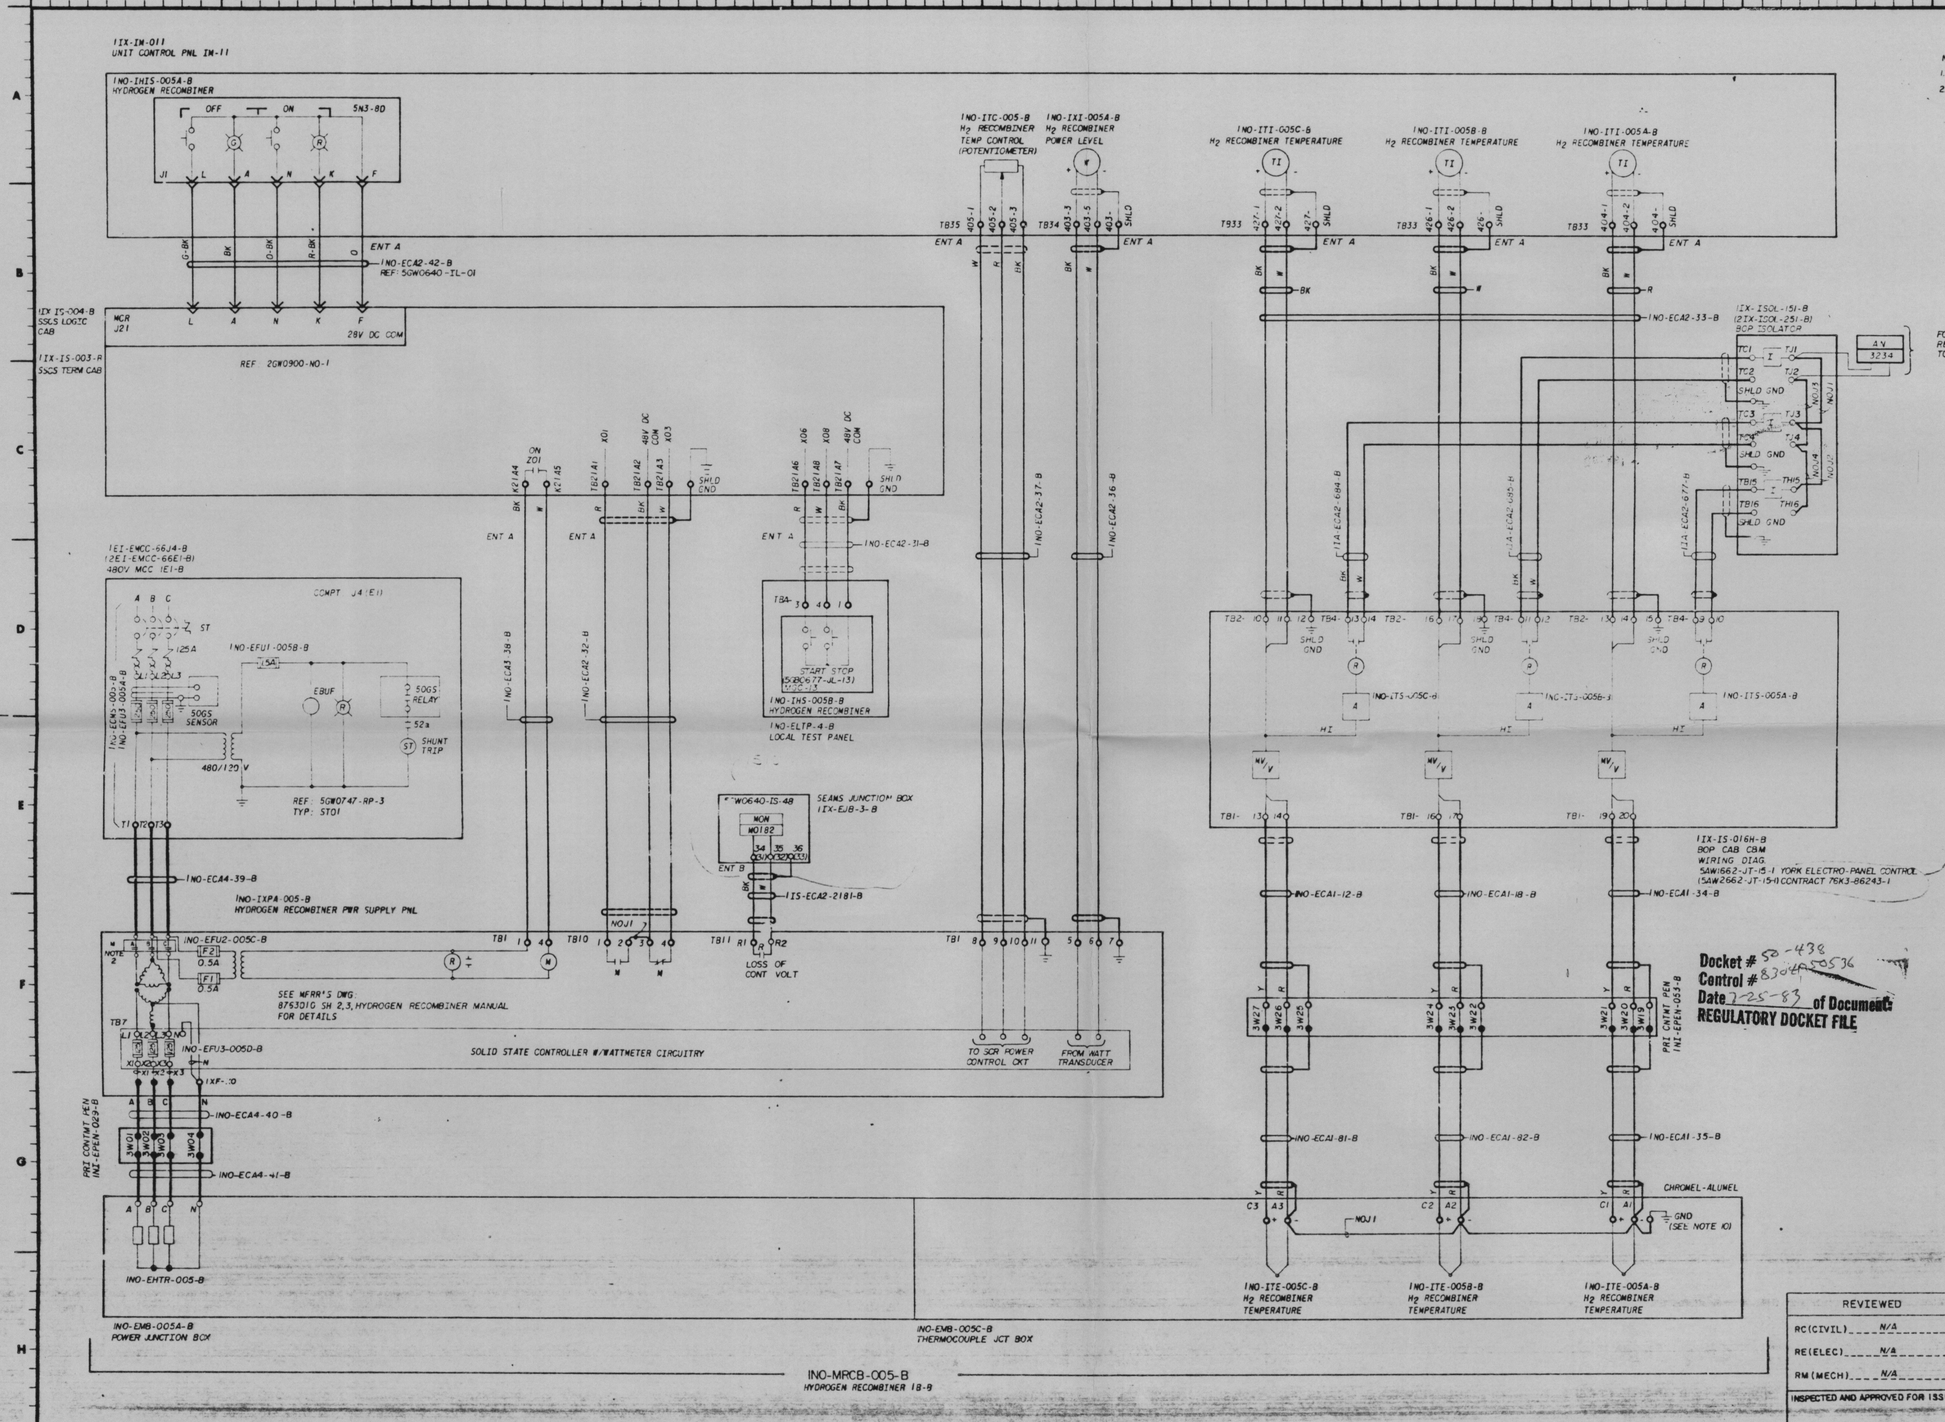

NOTES:
1. FOR GENERAL NOTES AND REFERENCES REFER TO 5GW0640-NO-01
2. FIELD TO PROVIDE AND INSTALL TERMINAL DESIGNATIONS A,B & C TO MAGNETIC CONTACTOR M.

PRC APERTURE CARD

Docket # 50-438
Control # 8304050536
Date 7-25-83 of Document:
REGULATORY DOCKET FILE

REV NO.	ECN NO.	DATE	DSGN	DRWN	CHKD	SUPV	ENGR	INSP	SUBM	RECM	APPD
4	1510,1696	11-2-82									
ADDED SEAMS JB PER ECN 1510. IDENT. BOP CAB. PER ECN 1696.											
3	SI	6-7-82									
INCORPORATED FOR E-2248.											
2	SI	7-31-81									
MISC. CHANGE.											
1	SI	9-26-80									
REVISED AND SPLICED PENETRATION TERMINALS, MINOR CHANGES.											

DSGN
DRWN
CHKD
SUPV
INSP
ENGR

SCALE EXCEPT AS NOTED

GENERAL
UNITS 1&2

SCHEMATIC DIAGRAM
CONTAINMENT COMBUSTIBLE
GAS CONTROL SYSTEM

BELLEFONTE NUCLEAR PLANT
TENNESSEE VALLEY AUTHORITY
DIVISION OF ENGINEERING DESIGN

Q

SUBMITTED | RECOMMENDED | APPROVED

KNOXVILLE 3-28-79 88 E 5GW0640-NO-05 R4

RECORD DRAWING AS CONSTRUCTED

THIS SCCDL DRAWING IS UNDER CONFIGURATION CONTROL

REVIEWED
RC(CIVIL) N/A
RE(ELEC) N/A
RM(MECH) N/A
INSPECTED AND APPROVED FOR ISSUE

PRINT
SIZE
PRINTS REQD-R