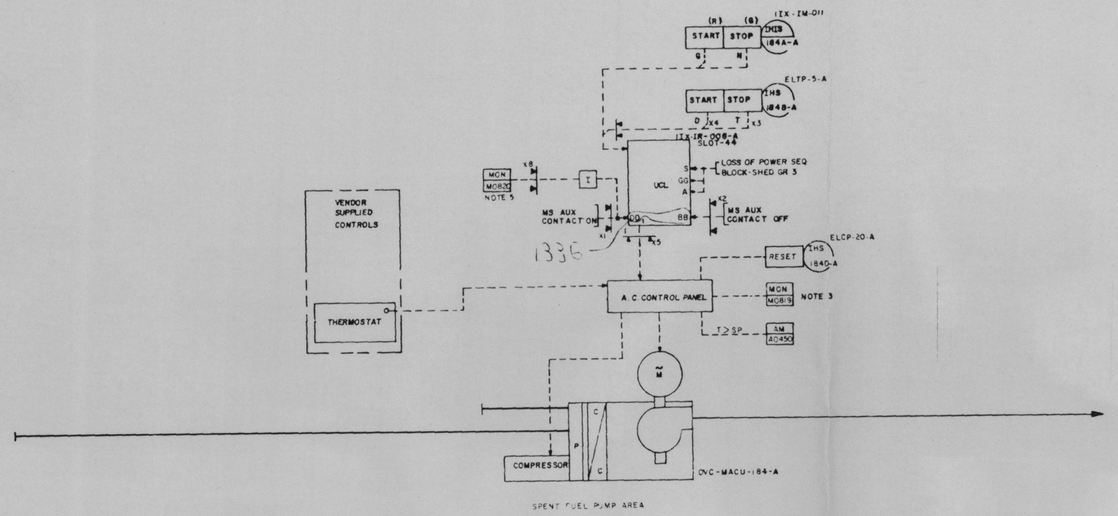

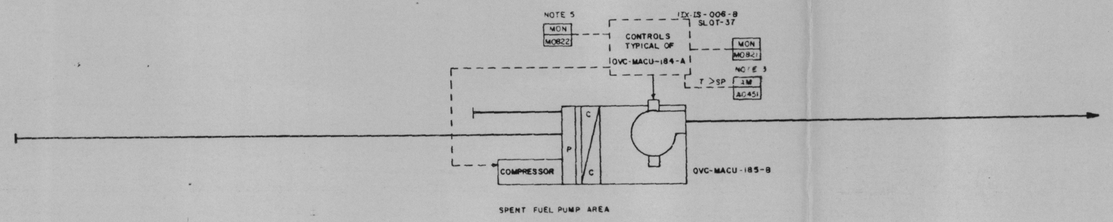

SEE SHEET ONE FOR NOTES AND REFERENCES

Docket # 50-438
Control # 8306050536
Date 5-25-83 of Document:
REGULATORY DOCKET FILE

PRC
APERTURE
CARD

REV NO.	ECN NO.	DATE	DSGN	DRWN	CHKD	J.PT	ENGR	INSP	QUAL REQ'D	APPR	L.A.	STD	MED
3	1336	5-4-82	GDW	IRL	RJH	MF	WEL	WEL	LCS	MF	MF		
CHANGED UCL CARD													
2	31	12-31-51	MF	-	RJH	JS	WEL	WEL	LCS	MF	MF		
MINOR CHANGES													
1	ECN 757, 51	4-5-79	MF	DB	RJH	WEL	LCS	MF	MF				
ADDED SEAMS INPUT * 757													

DSGN A. DIRIKIAN
DRWN J. K. SEIGER
CHKD J. W. HATCHER
SUPV N. H. CANDY
INSP
ENGINEER L. D. Perry

POWERHOUSE
COMMON EQUIPMENT

FUNCTIONAL CONTROL LOGIC DIAGRAM AUX. BLDG. COMMON ZONE HEATING & VENTILATION SYSTEM

BELLEFONTE NUCLEAR PLANT
TENNESSEE VALLEY AUTHORITY
DIVISION OF ENGINEERING DESIGN

Q

SUBMITTED	RECOMMENDED	APPROVED
J. E. Grant	K. W. Cotton	[illegible]

FSAR FIG. 9.4.3-6A

INSPECTED AND APPROVED FOR ISSUE
R. M. Hodges

KNOXVILLE 5-16-77 | 88 E 2GW0900-VC-3 R3

RECORD DRAWING AS CONSTRUCTED

PRINTS REQ'D — DR'G PROJ

DWG SIZE	F	H
WE		3
EE		
CE		
AD		
CD		
ED		
MD		
RF		
SW		
BL		2
PA		