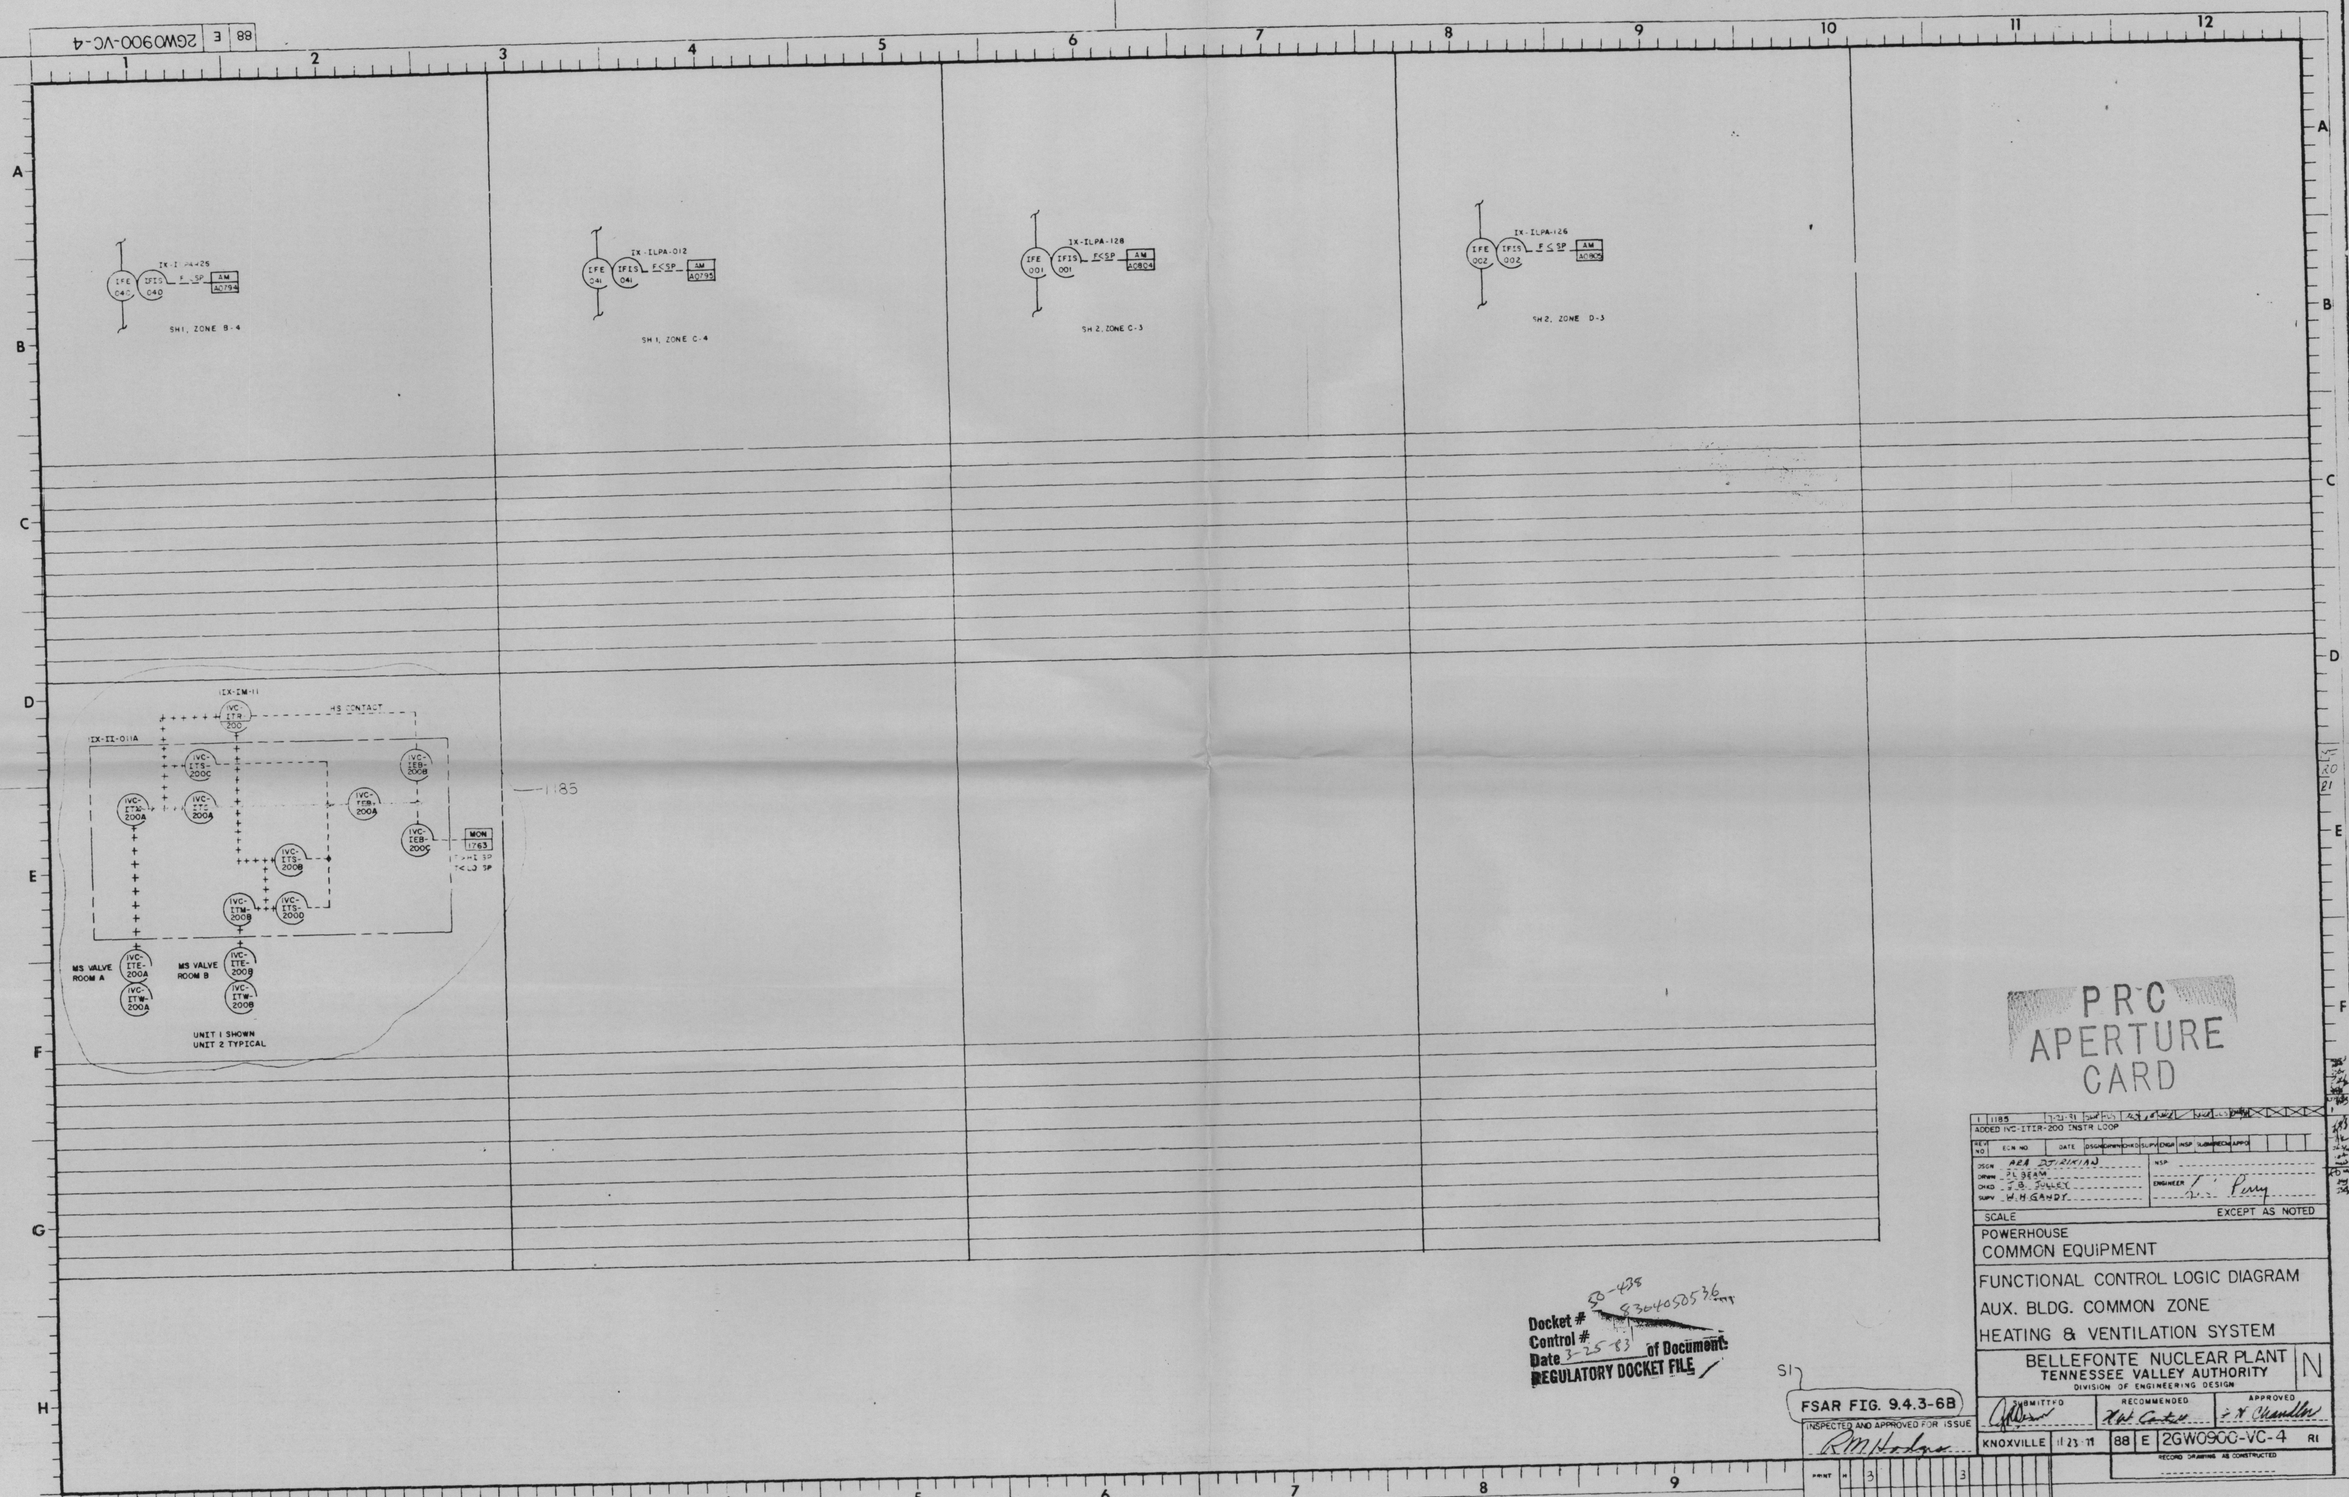

PRC APERTURE CARD

REV NO	ECN NO	DATE	DSGN	DRWN	CHKD	SUPV	ENGR	INSP	SUBM	RECM	APPD
1	1185	7-21-81									

ADDED IVC-ITIR-200 INSTR LOOP

DSGN ARA DJIRIKIAN
DRWN P.L. BEAM
CHKD J.B. JULLEY
SUPV W.H. GANDY
INSP
ENGINEER [signature] Perry

SCALE EXCEPT AS NOTED

POWERHOUSE
COMMON EQUIPMENT

FUNCTIONAL CONTROL LOGIC DIAGRAM
AUX. BLDG. COMMON ZONE
HEATING & VENTILATION SYSTEM

BELLEFONTE NUCLEAR PLANT
TENNESSEE VALLEY AUTHORITY
DIVISION OF ENGINEERING DESIGN

N

SUBMITTED [signature] RECOMMENDED [signature] APPROVED [signature]

KNOXVILLE 11-23-81 88 E 2GW0900-VC-4 R1

RECORD DRAWING AS CONSTRUCTED

Docket # 50-438
Control # 8304050536
Date 3-25-83 of Document
REGULATORY DOCKET FILE

S1

FSAR FIG. 9.4.3-6B

INSPECTED AND APPROVED FOR ISSUE
R M Hodges

PRINT H 3 3
SIZE F