NOTES:
1. FOR GENERAL NOTES AND SYMBOLS SEE SHEET 01.
2. MOTOR TERMINALS ARE MARKED AS SHOWN, FIELD TO MARK DISCONNECT TERMINALS AS SHOWN.

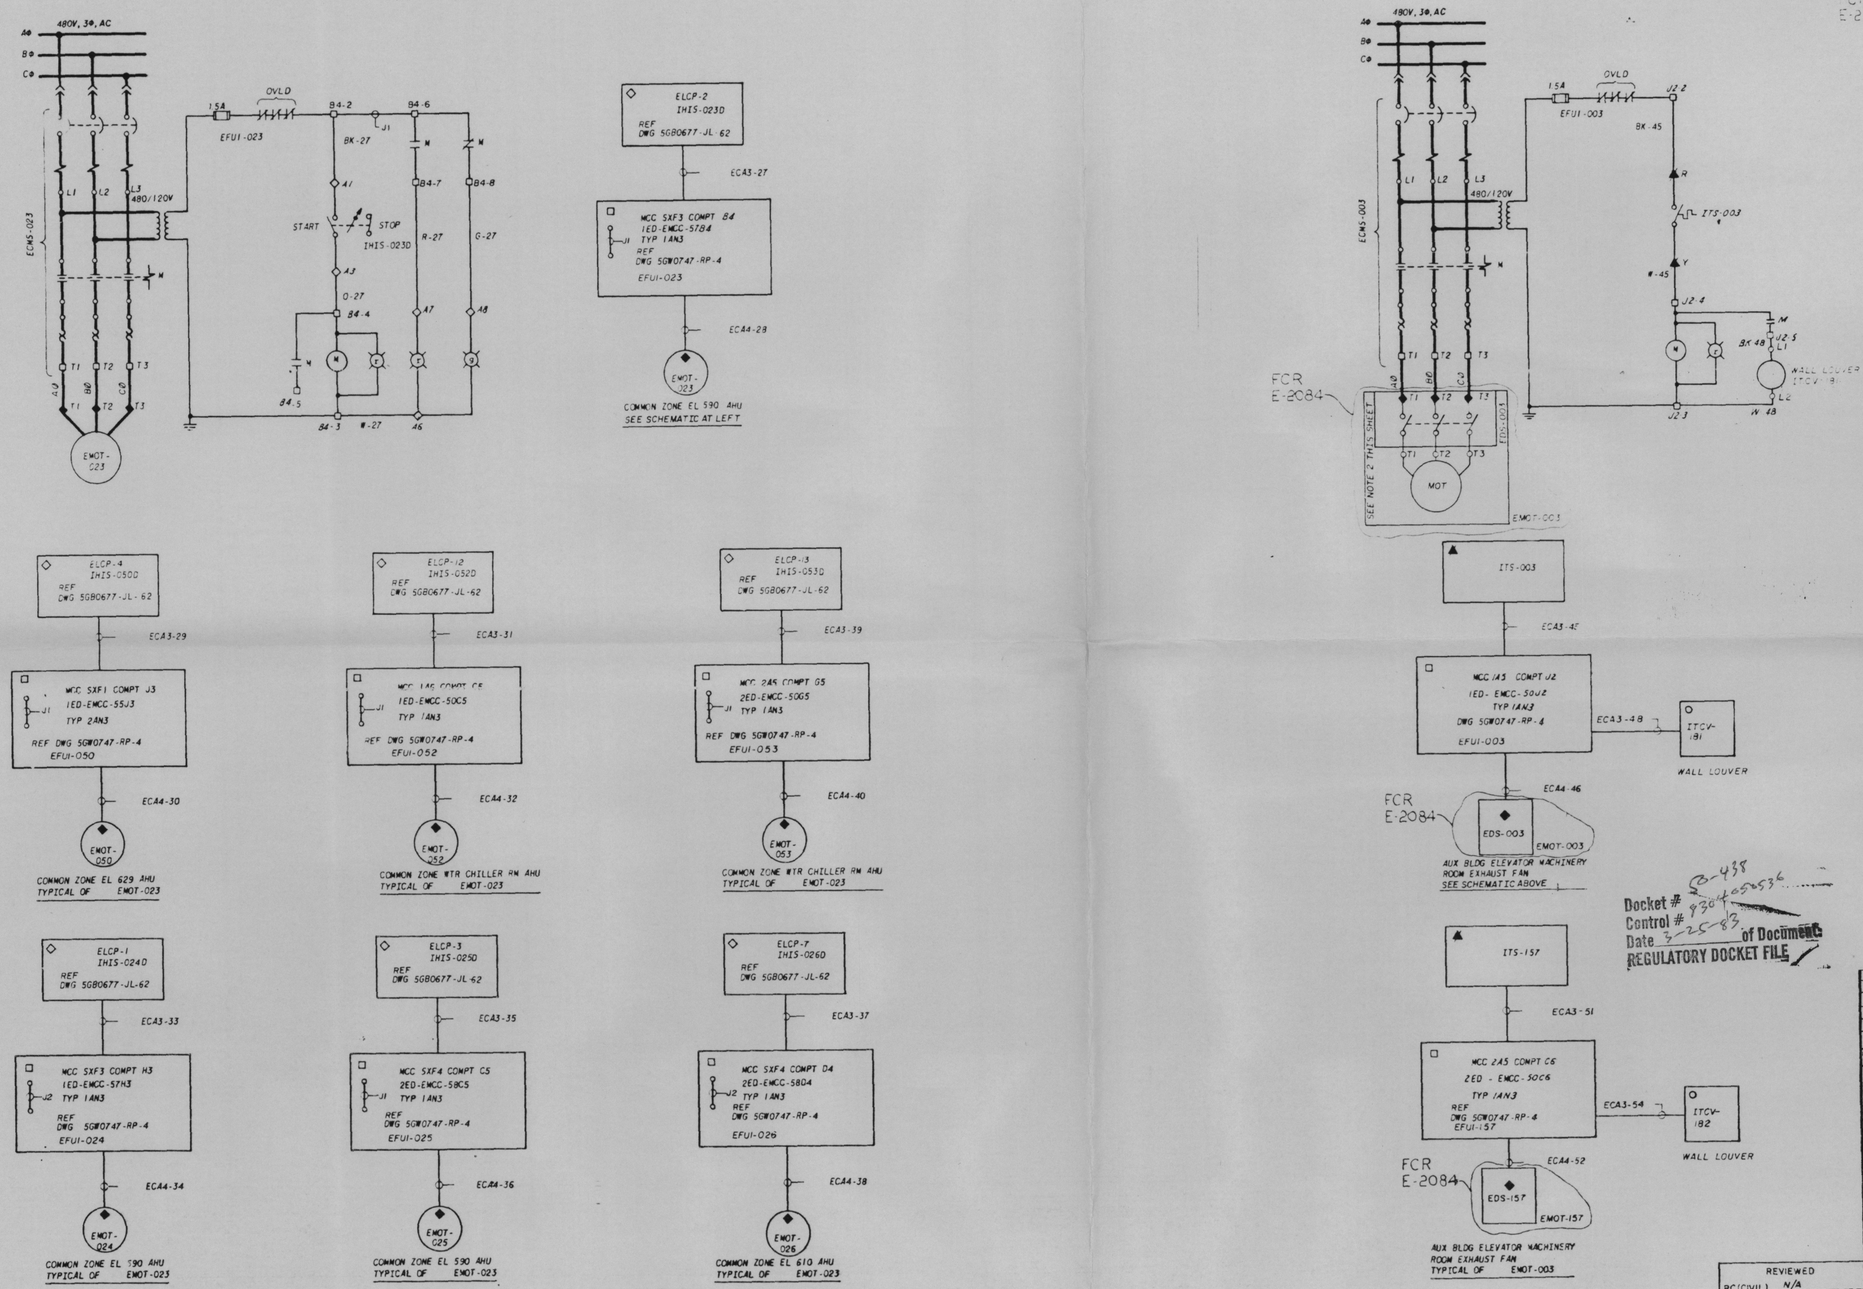

Docket # 50-438 50-439
Control # 930405536
Date 3-25-93 of Document
REGULATORY DOCKET FILE

PRC APERTURE CARD

REV			
3	S1	INCORPORATED FCR E-2084	
2	S1	REMOVED HOLD CIRCLES AND REMOVED EL AND COL	
1	518 S1	CHANGED MCC CONT PWR FUSES AND MINOR CHANGES.	

REV NO	ECN NO	DATE	DSGN	DRWN	CHKD	SUPV	ENGR	INSP	SUBMIT	RECM	APPD

DSGN J.D. Hulse
DRWN F.L. Robertson
CHKD
SUPV
INSP
ENGINEER

SCALE: EXCEPT AS NOTED

GENERAL
UNITS 1&2

SYSTEM SCHEMATIC
AUX BLDG COMMON AREA
ENVIRONMENTAL CONT SYS

BELLEFONTE NUCLEAR PLANT
TENNESSEE VALLEY AUTHORITY
DIVISION OF ENGINEERING DESIGN

Q

SUBMITTED | RECOMMENDED | APPROVED

KNOXVILLE 4-23-7

5GW0740-VC-04 R3

RECORD DRAWING AS CONSTRUCTED

REVIEWED
RC(CIVIL) N/A
RE(ELEC) N/A
RM(MECH) N/A

INSPECTED AND APPROVED FOR ISSUE