NOTES:
1. FOR GENERAL NOTES AND SYMBOLS SEE SHEET 01.
2. ALL UNIDS ON THIS SHEET ARE PRECEDED BY 1VC UNLESS OTHERWISE NOTED.
3. BREAKS ON POSITIVE OFF, OTHERWISE THERMALLY ACTIVATED - BREAKS ON TEMPERATURE RISE, MAKES ON TEMPERATURE FALL.

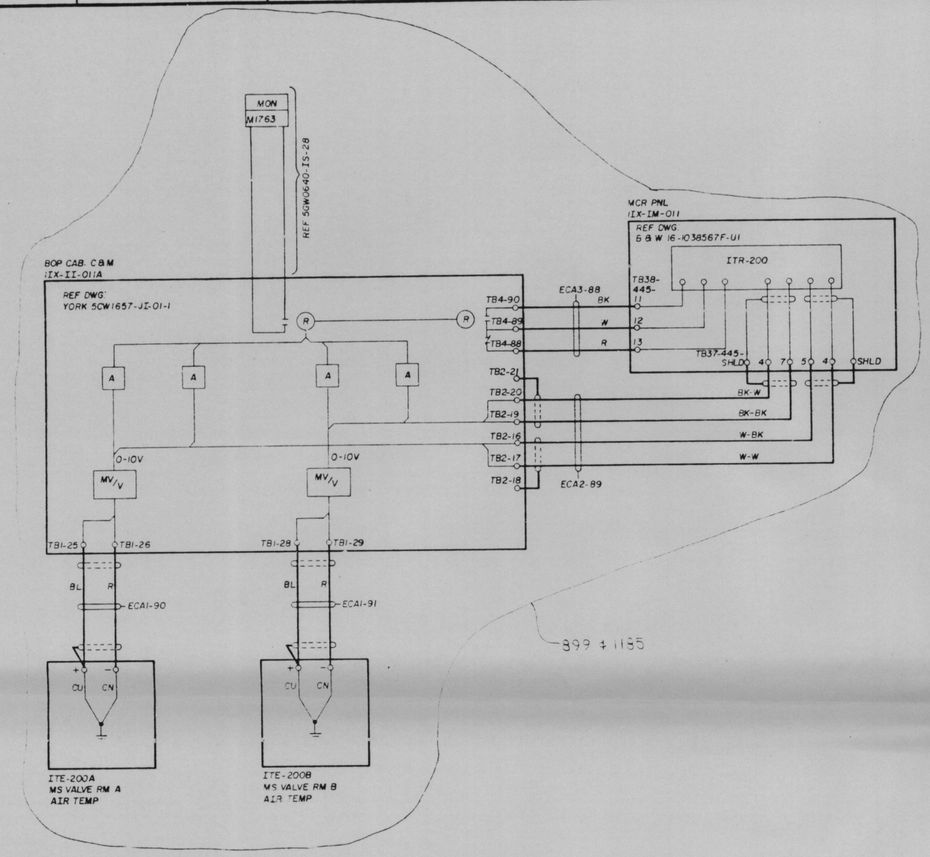

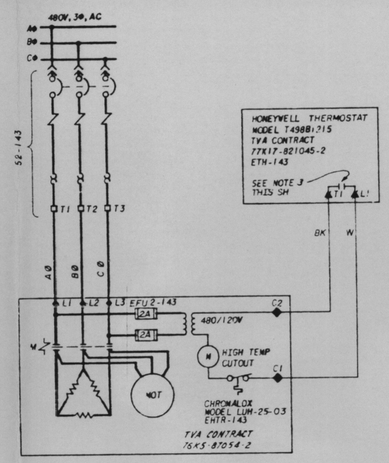

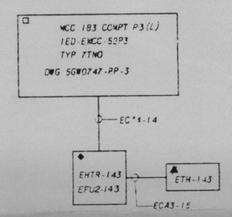

EL 649 MAIN STEAM SAFETY VALVE
ROOM 1B UNIT HEATER
SEE SCHEMATIC ABOVE

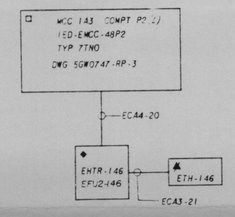

EL 649 MAIN STEAM SAFETY VALVE
ROOM 1A UNIT HEATER
TYPICAL OF EHTR-143

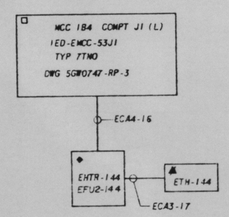

EL 649 MAIN STEAM SAFETY VALVE
ROOM 1B UNIT HEATER
TYPICAL OF EHTR-143

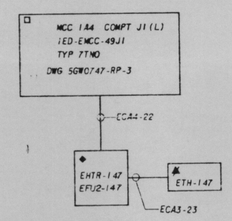

EL 649 MAIN STEAM SAFETY VALVE
ROOM 1A UNIT HEATER
TYPICAL OF EHTR-143

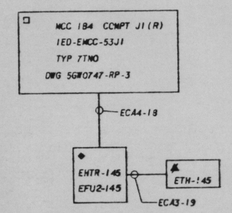

EL 649 MAIN STEAM SAFETY VALVE
ROOM 1B UNIT HEATER
TYPICAL OF EHTR-143

PRC APERTURE CARD

Docket # 50-438
Control # 8304050836
Date 3-25-83 of Document:
REGULATORY DOCKET FILE

REV NO.	ECN NO.	DATE	DSGN	DRWN	CHKD	SUPV	ENGR	INSP	SUBMR	RECM	APPR
3	899, 1185, S1	1-17-83	DWF	JCS	RDS	MWF	MCB	—	MCB	RL	WMS
DELETED MS VALVE RM FANS AND ADDED VALVE RM TEMP MONITOR. MINOR CHG.											
2	S1	5-11-82	RDS	JCS	DWF	MWF	WHB	—	WHB	RLS	WMS
REMOVED HOLD CIRCLES, DELETED EL AND COL, AND MADE MINOR CHANGES.											
1	518, S1	7-23-79	RDS	JCS	DWF	JCS	RDS	—	RDS	RLS	WMS
CHANGED MCC CONT PWR FUSE AND MINOR CHANGES.											

DSGN W. W. Pharden
DRWN R. D. Sanders
CHKD R. D. Sanders
SUPV W. W. Pharden
INSP
SUPER. W. W. Pharden

GENERAL
UNIT 1

SYSTEM SCHEMATIC
AUX BLDG COMMON AREA
ENVIRONMENTAL CONT SYS

BELLEFONTE NUCLEAR PLANT
TENNESSEE VALLEY AUTHORITY
DIVISION OF ENGINEERING DESIGN

SUBMITTED: W. W. Pharden
RECOMMENDED: A. L. Spangler
APPROVED: R. M. Hodges

KNOXVILLE 6-23-78

88 | E | 5GW0740-VC-05 | R3

RECORD DRAWING AS CONSTRUCTED

INSPECTED AND APPROVED FOR ISSUE

THIS RECORD DRAWING IS UNDER CONFIGURATION CONTROL

PRINTS REQD-R
BR w/
PROJ DWG SIZE F H
NE
EE
CE
AD
CO
EQ
UO
DF
SW
BL
PA