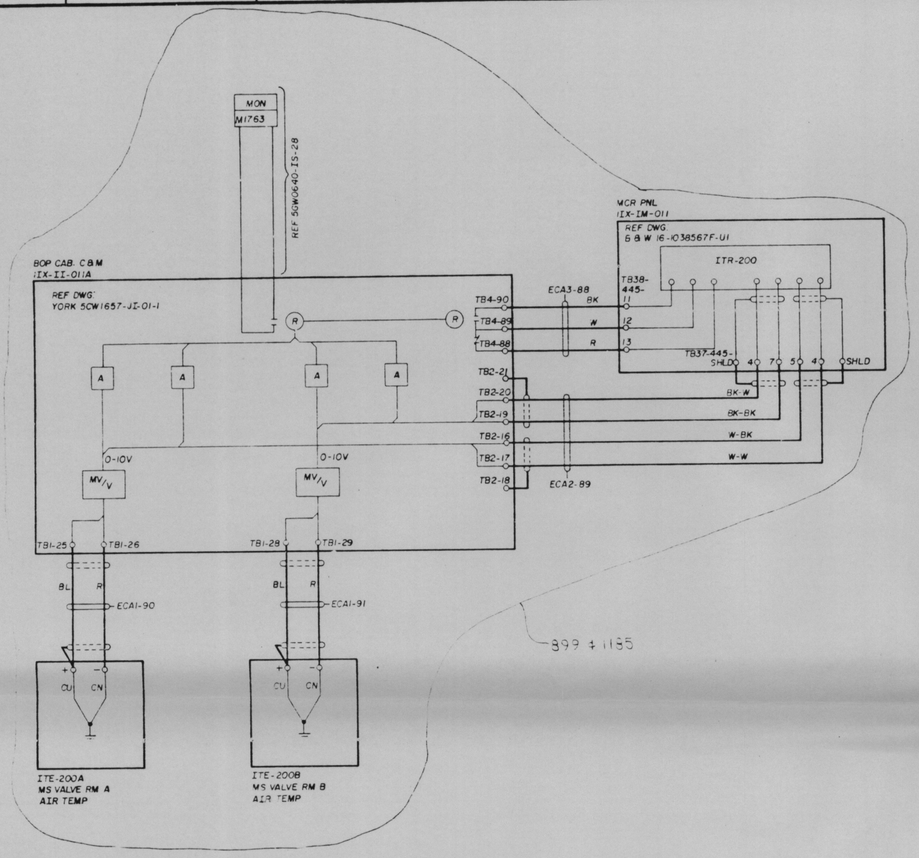

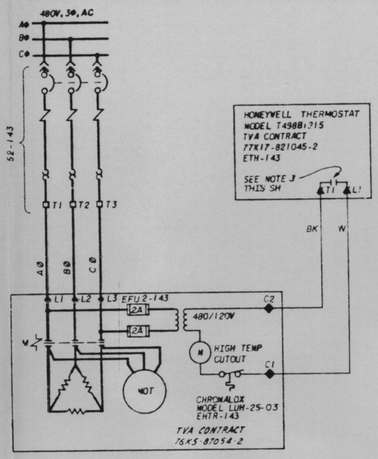

NOTES:
1. FOR GENERAL NOTES AND SYMBOLS SEE SHEET 01.
2. ALL UNIDS ON THIS SHEET ARE PRECEDED BY 1VC UNLESS OTHERWISE NOTED.
3. BREAKS ON POSITIVE OFF, OTHERWISE THERMALLY ACTIVATED - BREAKS ON TEMPERATURE RISE, MAKES ON TEMPERATURE FALL.

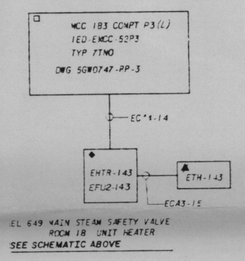

EL 649 MAIN STEAM SAFETY VALVE
ROOM 1B UNIT HEATER
SEE SCHEMATIC ABOVE

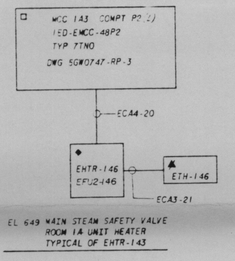

EL 649 MAIN STEAM SAFETY VALVE
ROOM 1A UNIT HEATER
TYPICAL OF EHTR-143

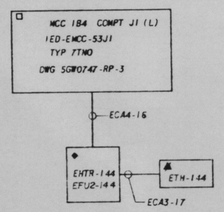

EL 649 MAIN STEAM SAFETY VALVE
ROOM 1B UNIT HEATER
TYPICAL OF EHTR-143

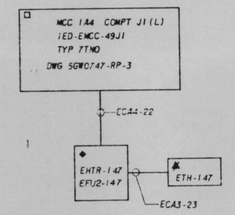

EL 649 MAIN STEAM SAFETY VALVE
ROOM 1A UNIT HEATER
TYPICAL OF EHTR-143

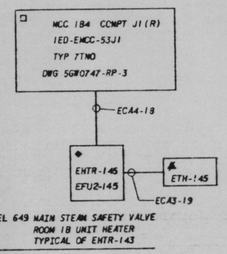

EL 649 MAIN STEAM SAFETY VALVE
ROOM 1B UNIT HEATER
TYPICAL OF EHTR-143

PRC APERTURE CARD

Docket # 50-438
Control # 8304050536
Date 3-25-83 of Document:
REGULATORY DOCKET FILE

INSPECTED AND APPROVED FOR ISSUE

NO.	ECN NO.	DATE	DSGN	DRWN	CHKD	SUPV	ENGR	INSP	SUBMITTED	RECOM	APPR
3	899, 1185, S1	7-17-82									
DELETED MS VALVE RM FANS AND ADDED VALVE RM TEMP MONITOR. MINOR CHG.											
2	S1	5-13-82									
REMOVED HOLD CIRCLES, DELETED EL AND COL, AND MADE MINOR CHANGES.											
1	518, S1	1-29-82									
CHANGED MCC CONT PWR FUSE AND MINOR CHANGES.											

DSGN W. P. Hayden
DRWN
CHKD
SUPV
INSP
SUBMITTED
RECOM
APPR

GENERAL
UNIT 1

SYSTEM SCHEMATIC
AUX BLDG COMMON AREA
ENVIRONMENTAL CONT SYS

BELLEFONTE NUCLEAR PLANT
TENNESSEE VALLEY AUTHORITY
DIVISION OF ENGINEERING DESIGN

SUBMITTED W. P. Hayden
RECOMMENDED
APPROVED R. M. Hodges

KNOXVILLE 6-23-78 | 88 | E | 5GW0740-VC-05 | R3

RECORD DRAWING AS CONSTRUCTED

THIS SCOL DRAWING IS UNDER CONFIGURATION CONTROL

PRINTS REQD-B
BR wt
PROJ

	DWG SIZE F	H
ME		
EE		
CE		
AD		
CO		
EQ		
VO		
DP		
SW		
BL		
PA		