NOTES:
1. FOR GENERAL NOTES AND SYMBOLS SEE SHEET 01
2. FIELD TO IDENTIFY WITH TVA UNID NO.

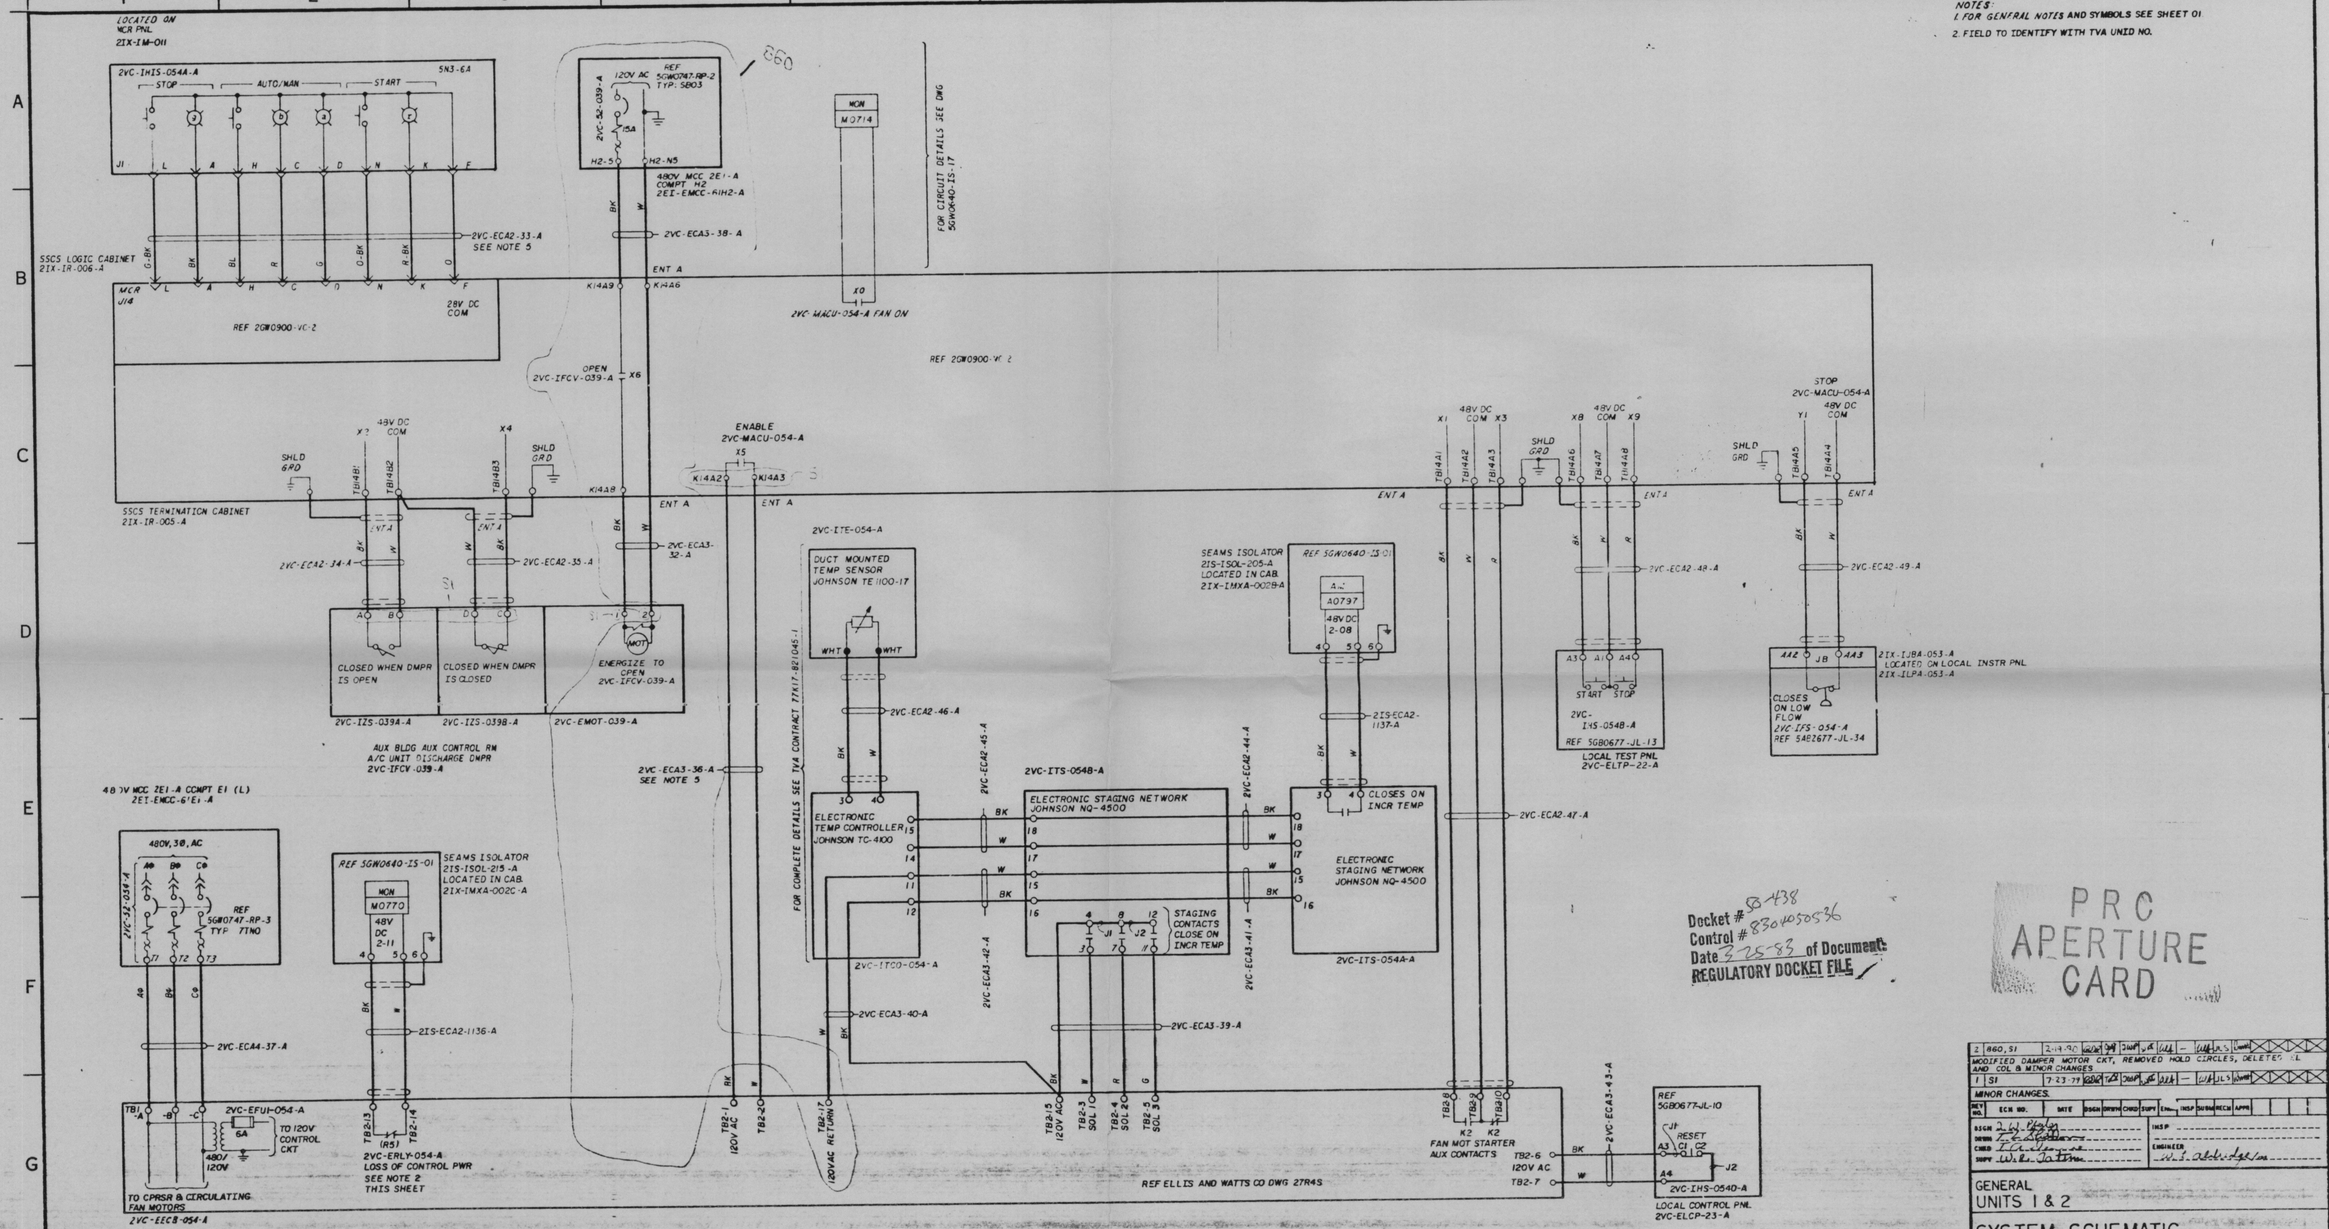

Docket # 50-438
Control # 8304050536
Date 3-25-83 of Document
REGULATORY DOCKET FILE

PRC APERTURE CARD

REV NO.	ECN NO.	DATE	DSGN	DRWN	CHKD	SUPV	ENG	INSP	SUBM	RECM	APPR
2	860,51	2-14-90									
MODIFIED DAMPER MOTOR CKT, REMOVED HOLD CIRCLES, DELETED SL AND COL & MINOR CHANGES											
1	51	7-23-79									
MINOR CHANGES.											

DSGN
DRWN
CHKD
SUPV
INSP
ENGINEER

GENERAL
UNITS 1 & 2

SYSTEM SCHEMATIC
AUX BLDG COMMON AREA
ENVIRONMENTAL CONTROL SYSTEM

BELLEFONTE NUCLEAR PLANT
TENNESSEE VALLEY AUTHORITY
DIVISION OF ENGINEERING DESIGN

Q

SUBMITTED | RECOMMENDED | APPROVED

KNOXVILLE 4-23-79 | 88 E 5GW0740-VC-08 R2

RECORD DRAWING AS CONSTRUCTED

REVIEWED
RC(CIVIL) N/A
RE(ELEC) N/A
RM(MECH) N/A

INSPECTED AND APPROVED FOR ISSUE

PRINTS REQD-R
BR ref
PROJ DWG SIZE
F H
ME
EE
CE
AD
CO
ED
MD
BF
SW
BL
PA