NOTES
1. FOR GENERAL NOTES AND SYMBOLS SEE SHEET 01.
2. FIELD TO IDENTIFY WITH TVA UNID NO.

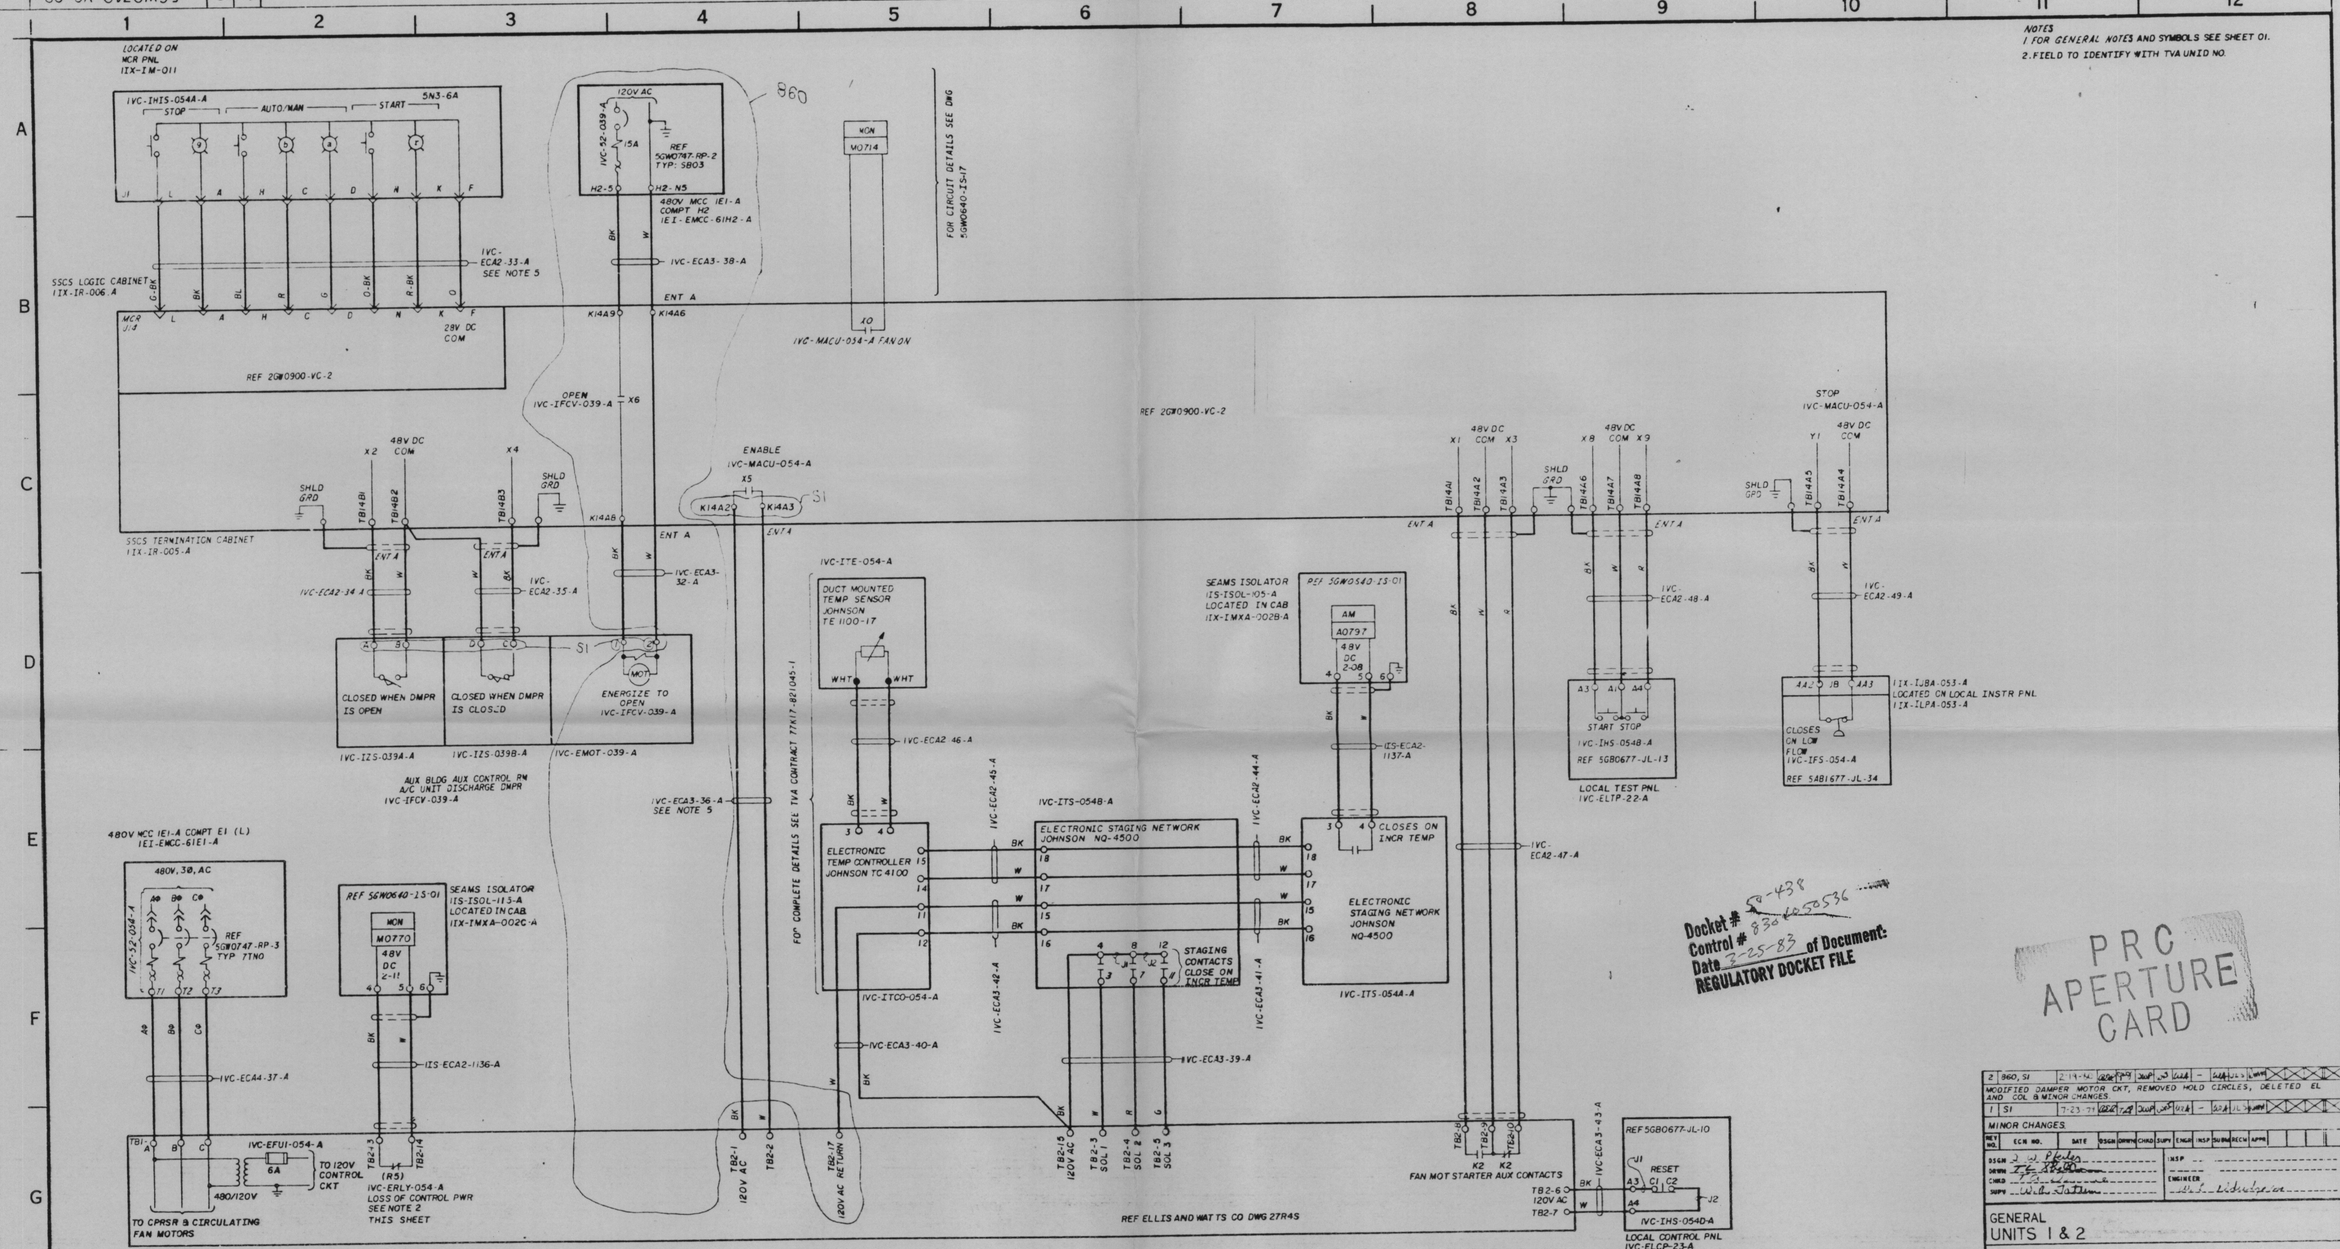

AUXILIARY CONTROL ROOM AC UNIT IVC-MACU-054-A

Docket # 50-438
Control # 830625036
Date 3-25-83 of Document:
REGULATORY DOCKET FILE

PRC APERTURE CARD

REV NO.	ECN NO.	DATE	DSGN	DRWN	CHKD	SUPV	ENGR	INSP	SUPINSP	DECN	APPR
2	860, SI	2-19-86									
	MODIFIED DAMPER MOTOR CKT, REMOVED HOLD CIRCLES, DELETED EL AND COL & MINOR CHANGES										
1	SI	7-23-79									

MINOR CHANGES

DSGN J. J. Pleta
DRWN
CHKD
SUPV
INSP
ENGINEER

GENERAL
UNITS 1 & 2

SYSTEM SCHEMATIC
AUX BLDG COMMON AREA
ENVIRONMENTAL CONTROL SYSTEM

BELLEFONTE NUCLEAR PLANT
TENNESSEE VALLEY AUTHORITY
DIVISION OF ENGINEERING DESIGN

Q

SUBMITTED	RECOMMENDED	APPROVED
		R M Hodges

KNOXVILLE 6-23-78 83 E 5GW0740-VC-09 R2

RECORD DRAWING AS CONSTRUCTED

REVIEWED
RC(CIVIL) N/A
RE(ELEC) N/A
RM(MECH) N/A

INSPECTED AND APPROVED FOR ISSUE

PRINTS REQD-R
BR-W
PROJ
DWG SIZE F H
ME
EE
CE
AD
CD
ED
MD
BF
SW
RL
PA