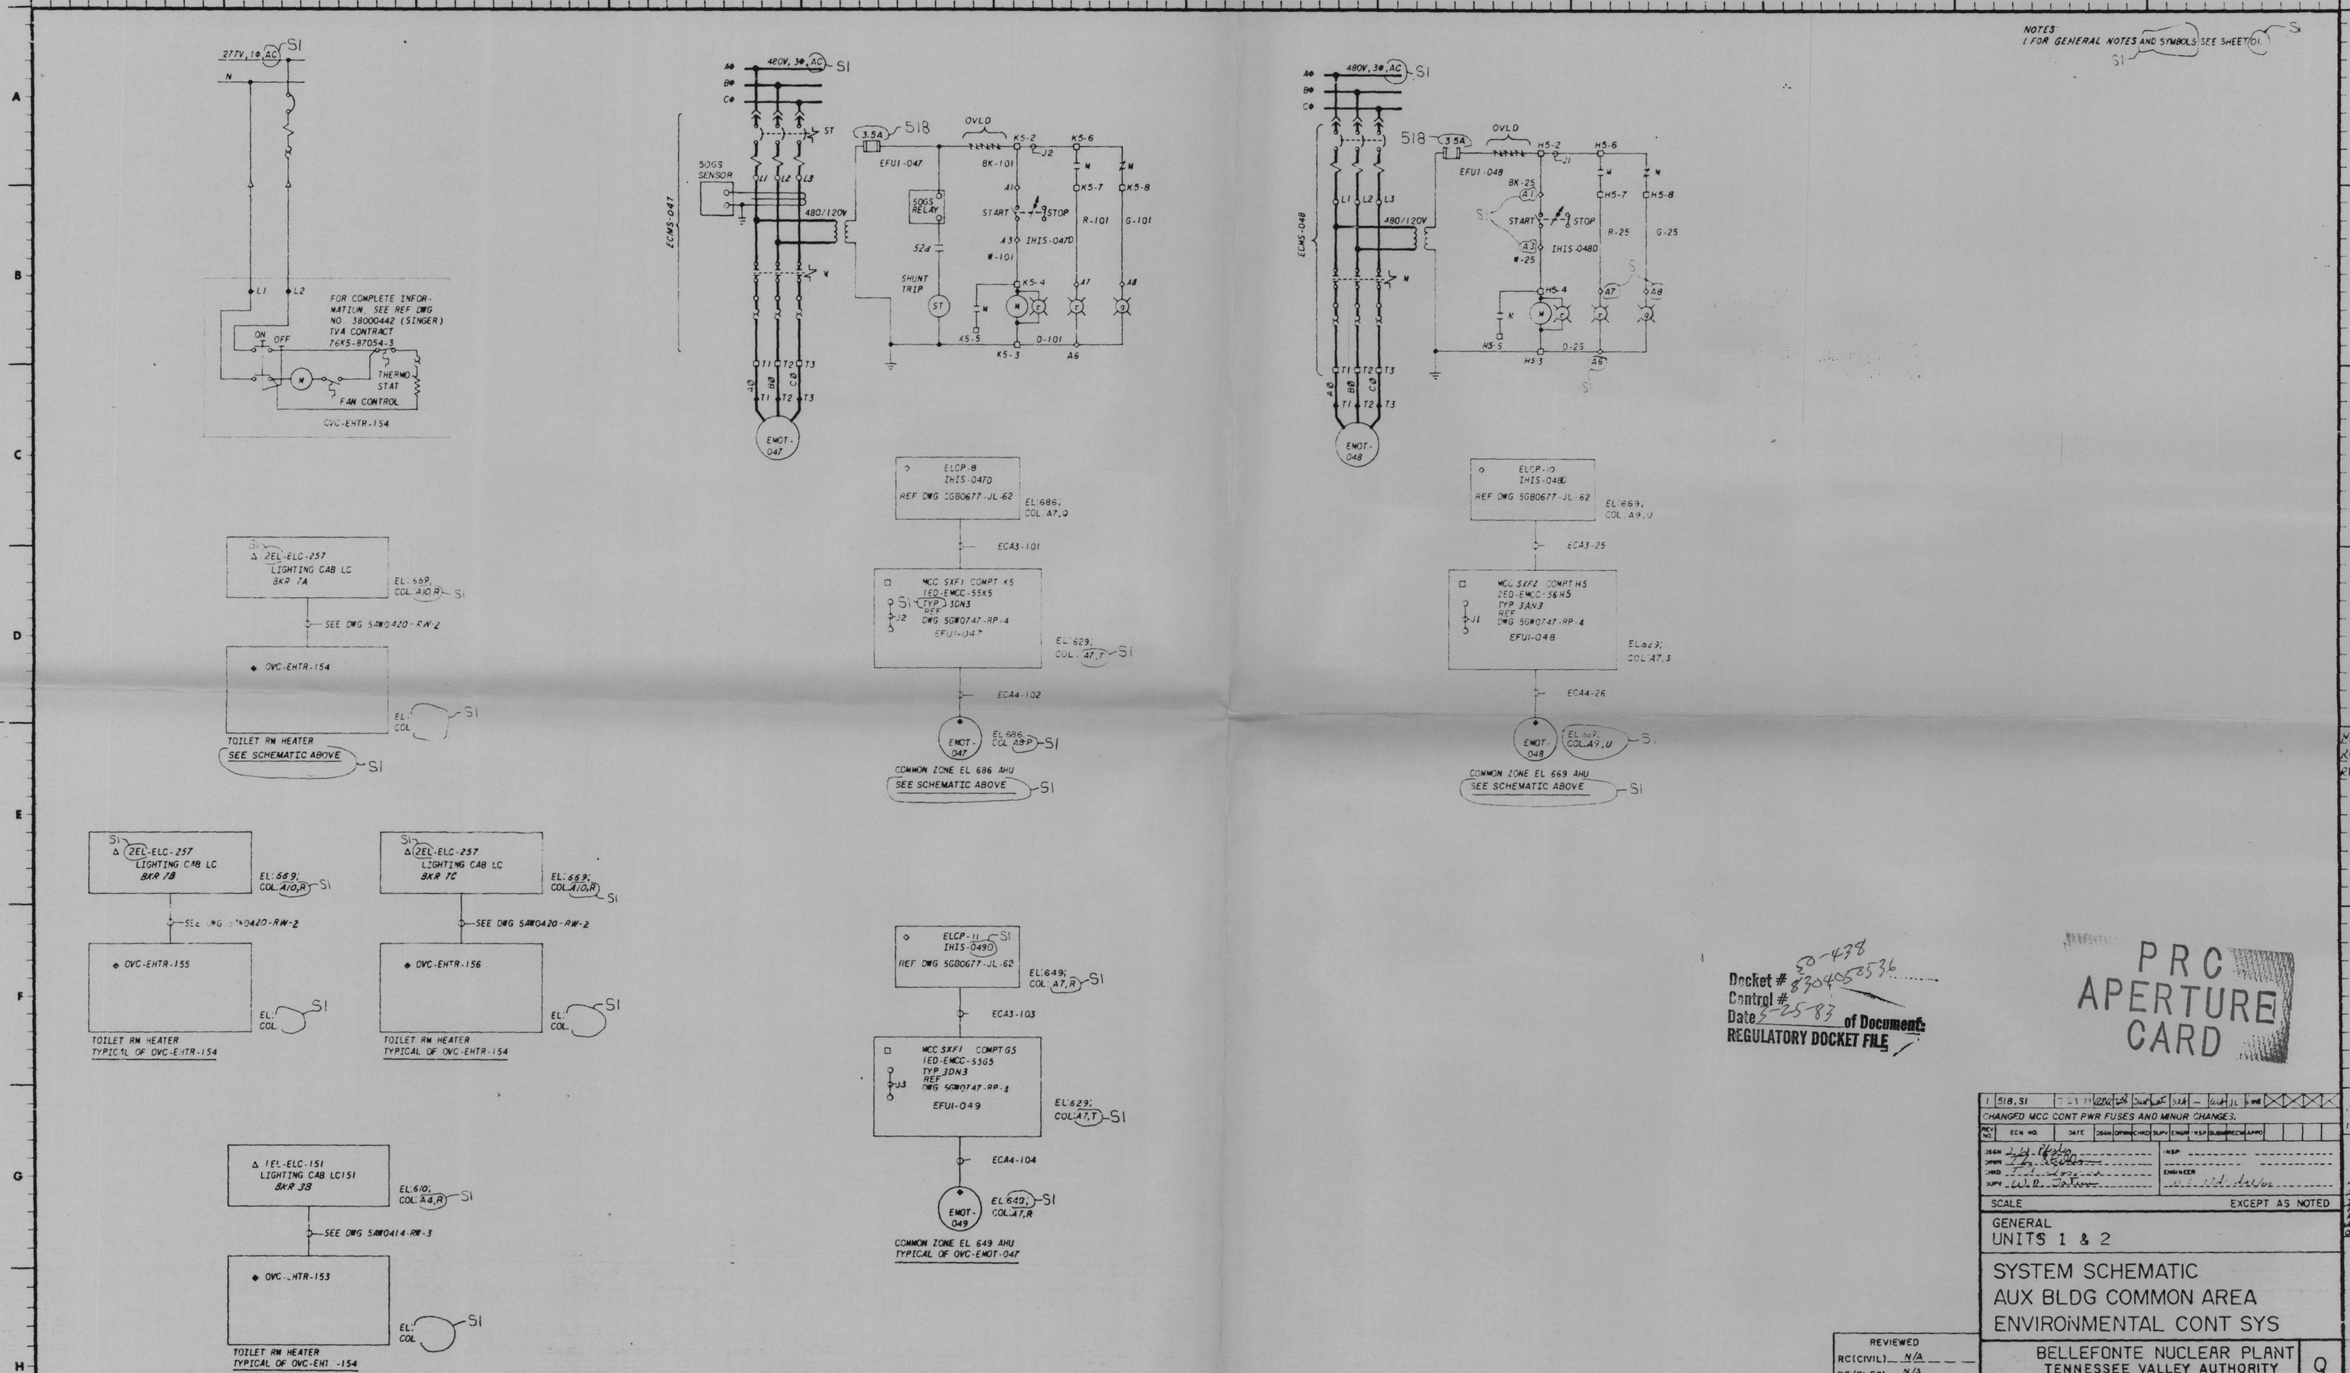

Docket # 50-438
Control # 8304050536
Date 5-25-83 of Document:
REGULATORY DOCKET FILE

PRC APERTURE CARD

REV NO.	ECN NO.	DATE	DSGN	DRWN	CHKD	SUPV	ENGR	INSP	SUBM	RECM	APPD
1	518, S1	7-23-79	[illegible]	[illegible]	[illegible]	[illegible]	—	[illegible]	[illegible]	[illegible]	

CHANGED MCC CONT PWR FUSES AND MINOR CHANGES.

DSGN [illegible] INSP
DRWN [illegible] ENGINEER
CHKD [illegible]
SUPV W. R. [illegible]

SCALE EXCEPT AS NOTED

GENERAL
UNITS 1 & 2

SYSTEM SCHEMATIC
AUX BLDG COMMON AREA
ENVIRONMENTAL CONT SYS

REVIEWED
RC(CIVIL) N/A
RE(ELEC) N/A
RM(MECH) N/A

INSPECTED AND APPROVED FOR ISSUE

BELLEFONTE NUCLEAR PLANT
TENNESSEE VALLEY AUTHORITY
DIVISION OF ENGINEERING DESIGN

Q

SUBMITTED [illegible] RECOMMENDED [illegible] APPROVED [illegible]

KNOXVILLE 6-23-78 88 E 5GW0740-VC-12 R1

RECORD DRAWING AS CONSTRUCTED

88 E 5GW0740-VC-12