NOTES:
1 FOR GENERAL NOTES AND SYMBOLS SEE SHEET 01

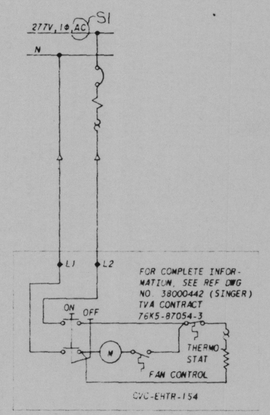

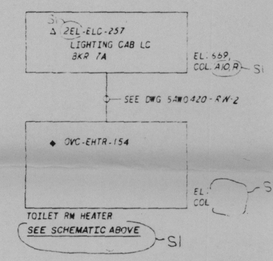

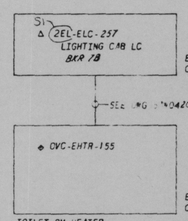

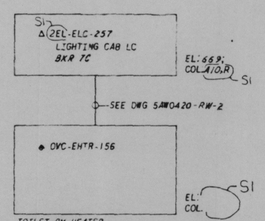

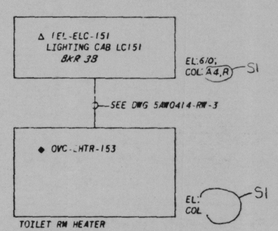

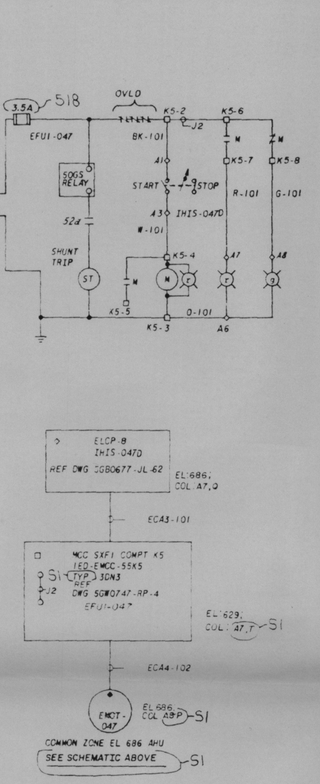

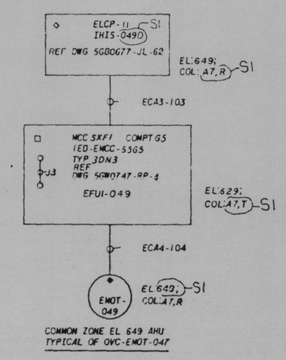

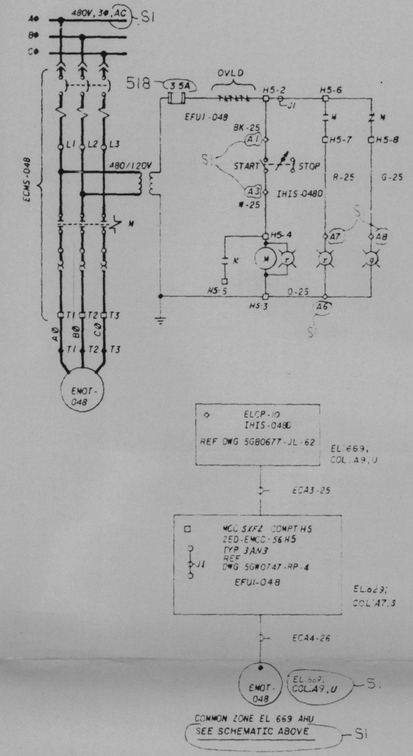

Docket # 50-438
Control # 8304050536
Date 3-25-83 of Document:
REGULATORY DOCKET FILE

PRC APERTURE CARD

REV NO.	ECN NO.	DATE	DSGN	DFTMN	CHKD	SUPV	ENGR	INSP	SUBMR	RECM	APPD
1	518, S1	7-23-79	GHC	LB	SWB	WJF	DAB	—	WJH	JL	JHB

CHANGED MCC CONT PWR FUSES AND MINOR CHANGES.

DSGN GHC; DFTMN LB; CHKD SWB; SUPV WJF; INSP —; ENGINEER DAB

SCALE EXCEPT AS NOTED

GENERAL
UNITS 1 & 2

SYSTEM SCHEMATIC
AUX BLDG COMMON AREA
ENVIRONMENTAL CONT SYS

BELLEFONTE NUCLEAR PLANT
TENNESSEE VALLEY AUTHORITY
DIVISION OF ENGINEERING DESIGN

Q

SUBMITTED: W. L. Vidrine | RECOMMENDED: J. P. Lynn | APPROVED: R. M. Hodge

KNOXVILLE 6-23-78 | 88 | E | 5GW0740-VC-12 R1

RECORD DRAWING AS CONSTRUCTED

REVIEWED
RC(CIVIL) N/A
RE(ELEC) N/A
RM(MECH) N/A

INSPECTED AND APPROVED FOR ISSUE

PRINT
SIZE