NOTES:
1. FOR GENERAL NOTES AND SYMBOLS SEE SHEET 01.
2. ALL UNIDS SHOWN ON THIS SHEET ARE PRECEDED BY IVC-UNLESS OTHERWISE NOTED.

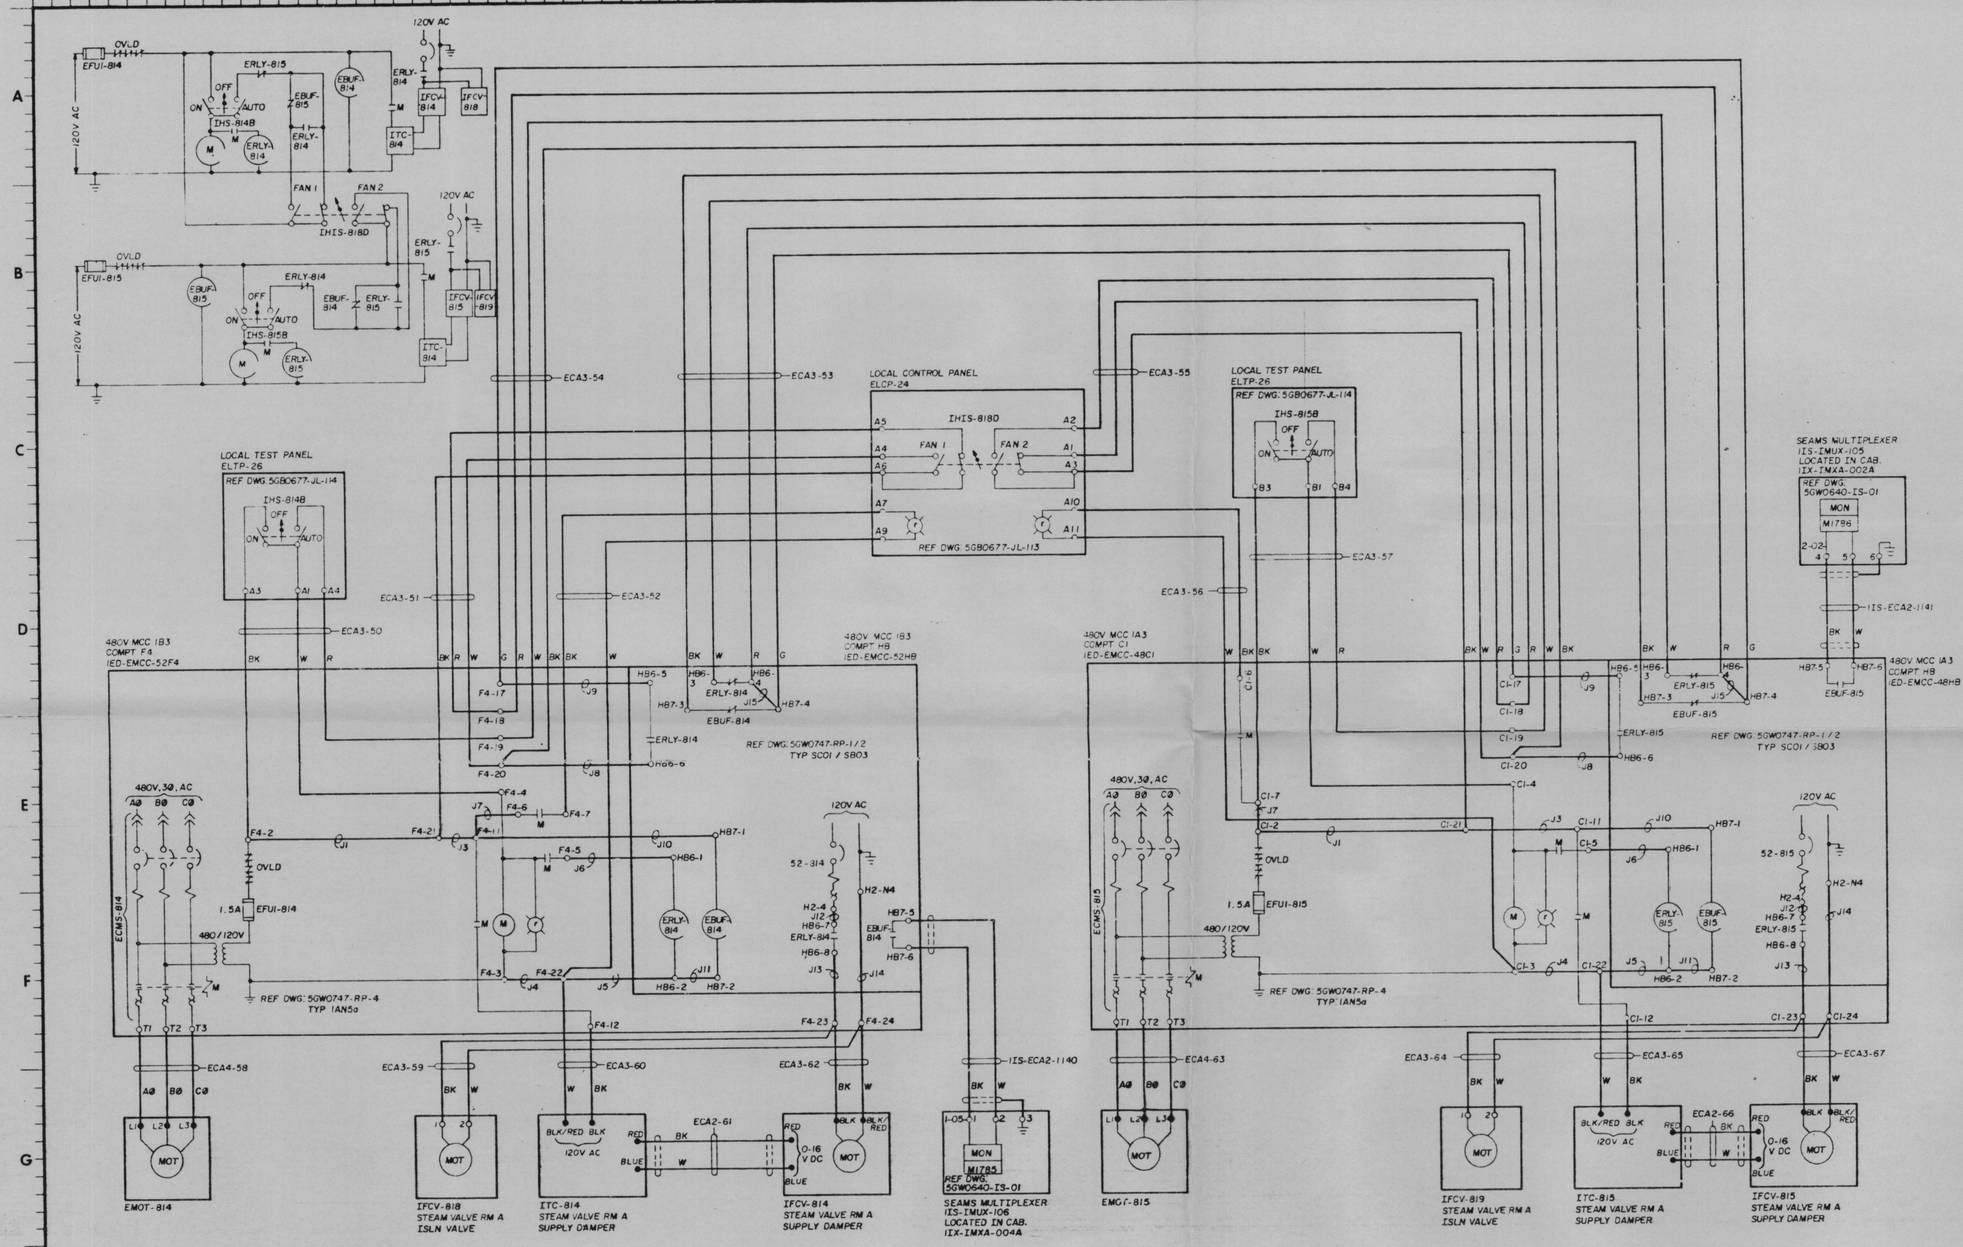

STEAM VALVE ROOM A SUPPLY FANS
MFAN-814 & MFAN-815

RO ISSUE FOR ECN 8998 1185

Docket # 50-438
Control # 8304050536
Date 3-25-83 of Document:
REGULATORY DOCKET FILE

PRC APERTURE CARD

REV NO	ECN NO	DATE	DSGN	DRWN	CHKD	SUPV	ENGR	NSP	SUBMITTED	RECOMMENDED	APPROVED

DSGN J. W. Phelps
DRWN J. L. Robinson
CHKD F. D. Clements
SUPV W. H. Williams
NSP
ENGINEER W. S. Rustle Jr.

SCALE: EXCEPT AS NOTED

GENERAL
UNITS 1 & 2

SYSTEM SCHEMATIC
AUX BLDG COMMON AREA
ENVIRONMENTAL CONTROL SYS

BELLEFONTE NUCLEAR PLANT
TENNESSEE VALLEY AUTHORITY
DIVISION OF ENGINEERING DESIGN

N

SUBMITTED W. S. Rustle Jr.
RECOMMENDED R. L. Spangler
APPROVED S. M. Halpern

KNOXVILLE 8-19-82 | 88 | E | 5GW0740-VC-17 | RO

RECORD DRAWING AS CONSTRUCTED

INSPECTED AND APPROVED FOR ISSUE

PRINT
SIZE

BR OR PROJ
PRINTS REQD

RIVER GRAPHICS
88603