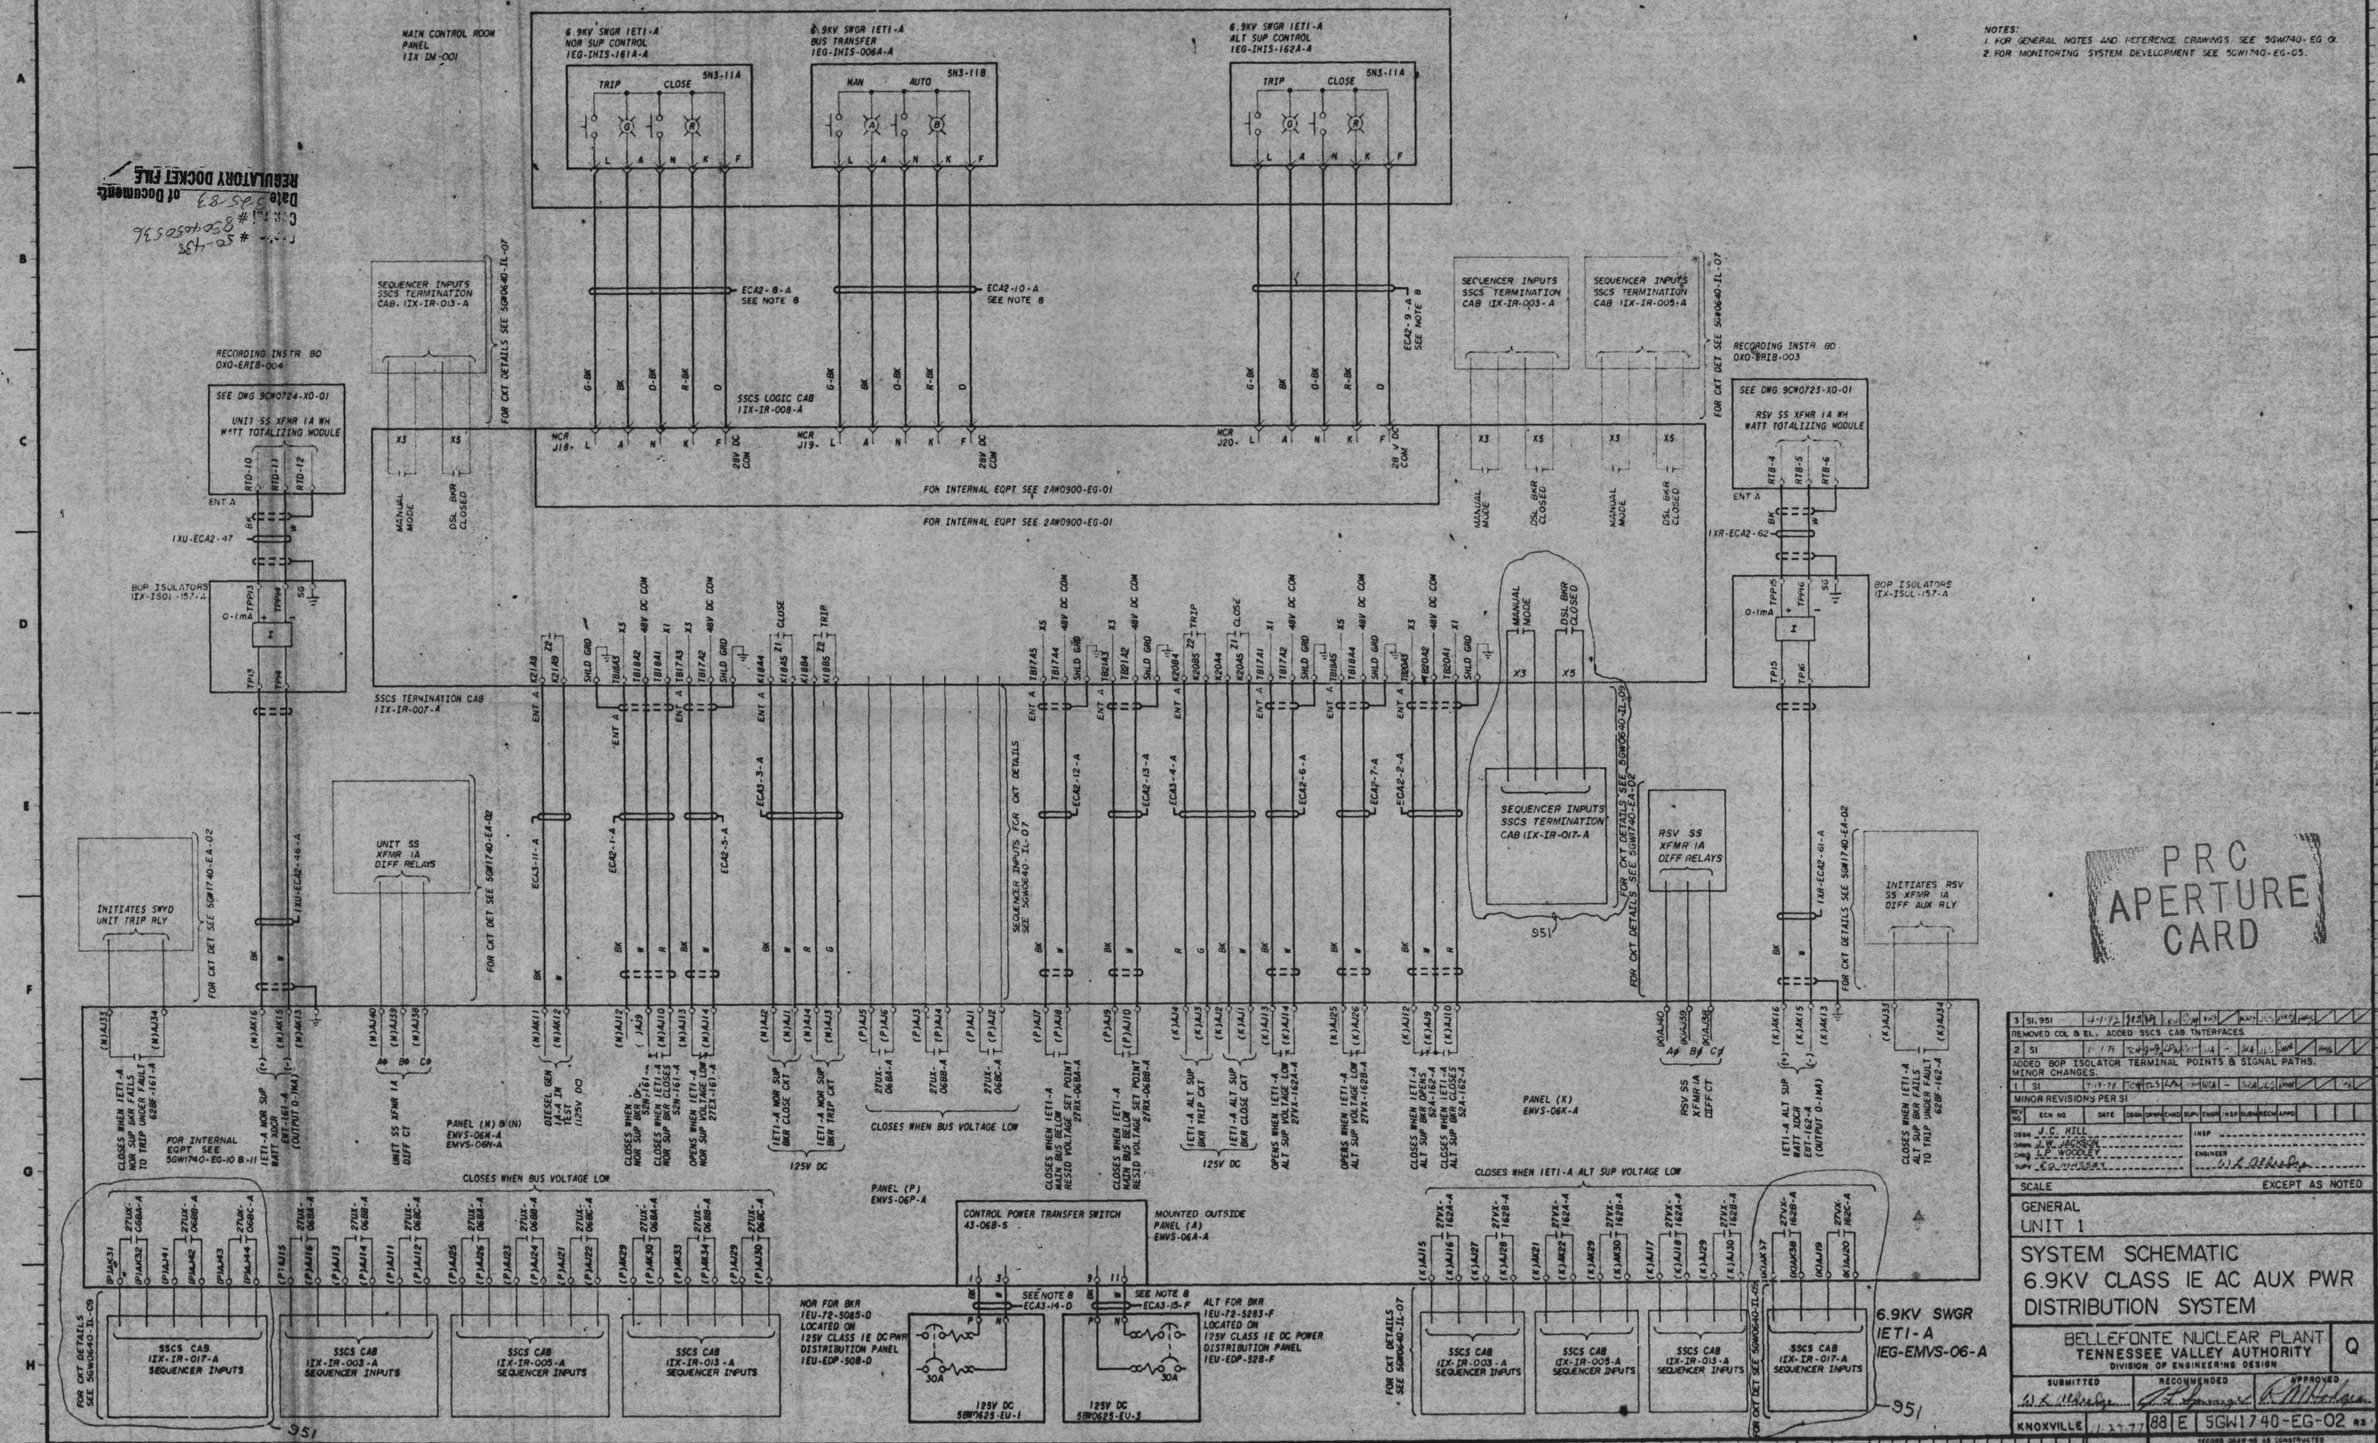

PRC APERTURE CARD

REV	ECN NO	DATE	DSGN	DRWN	CHKD	SUPV	ENGR	INSP	SUBM	RECM	APPD
3	SI, 951	4-1-77	JCH	JWJ	LCW	WMT					
	REMOVED COL & EL. ADDED SSCS CAB. INTERFACES.										
2	SI	1-1-74	CWG-B	LPW							
	ADDED BOP ISOLATOR TERMINAL POINTS & SIGNAL PATHS. MINOR CHANGES.										
1	SI	7-17-72									
	MINOR REVISIONS PER SI										

DSGN J. C. HILL
DRWN J. W. JACKSON
CHKG L. P. WOODLEY
SUPV

INSP
ENGINEER

SCALE EXCEPT AS NOTED

GENERAL
UNIT 1

SYSTEM SCHEMATIC 6.9KV CLASS IE AC AUX PWR DISTRIBUTION SYSTEM

BELLEFONTE NUCLEAR PLANT
TENNESSEE VALLEY AUTHORITY
DIVISION OF ENGINEERING DESIGN

Q

SUBMITTED | RECOMMENDED | APPROVED

KNOXVILLE 1-27-77 | 88 | E | 5GW1740-EG-02 | R3

RECORD DRAWING AS CONSTRUCTED

THIS DRAWING IS UNDER CONFIGURATION CONTROL

REGULATORY DOCKET FILE
Date 5-25-83
Contents of Documents