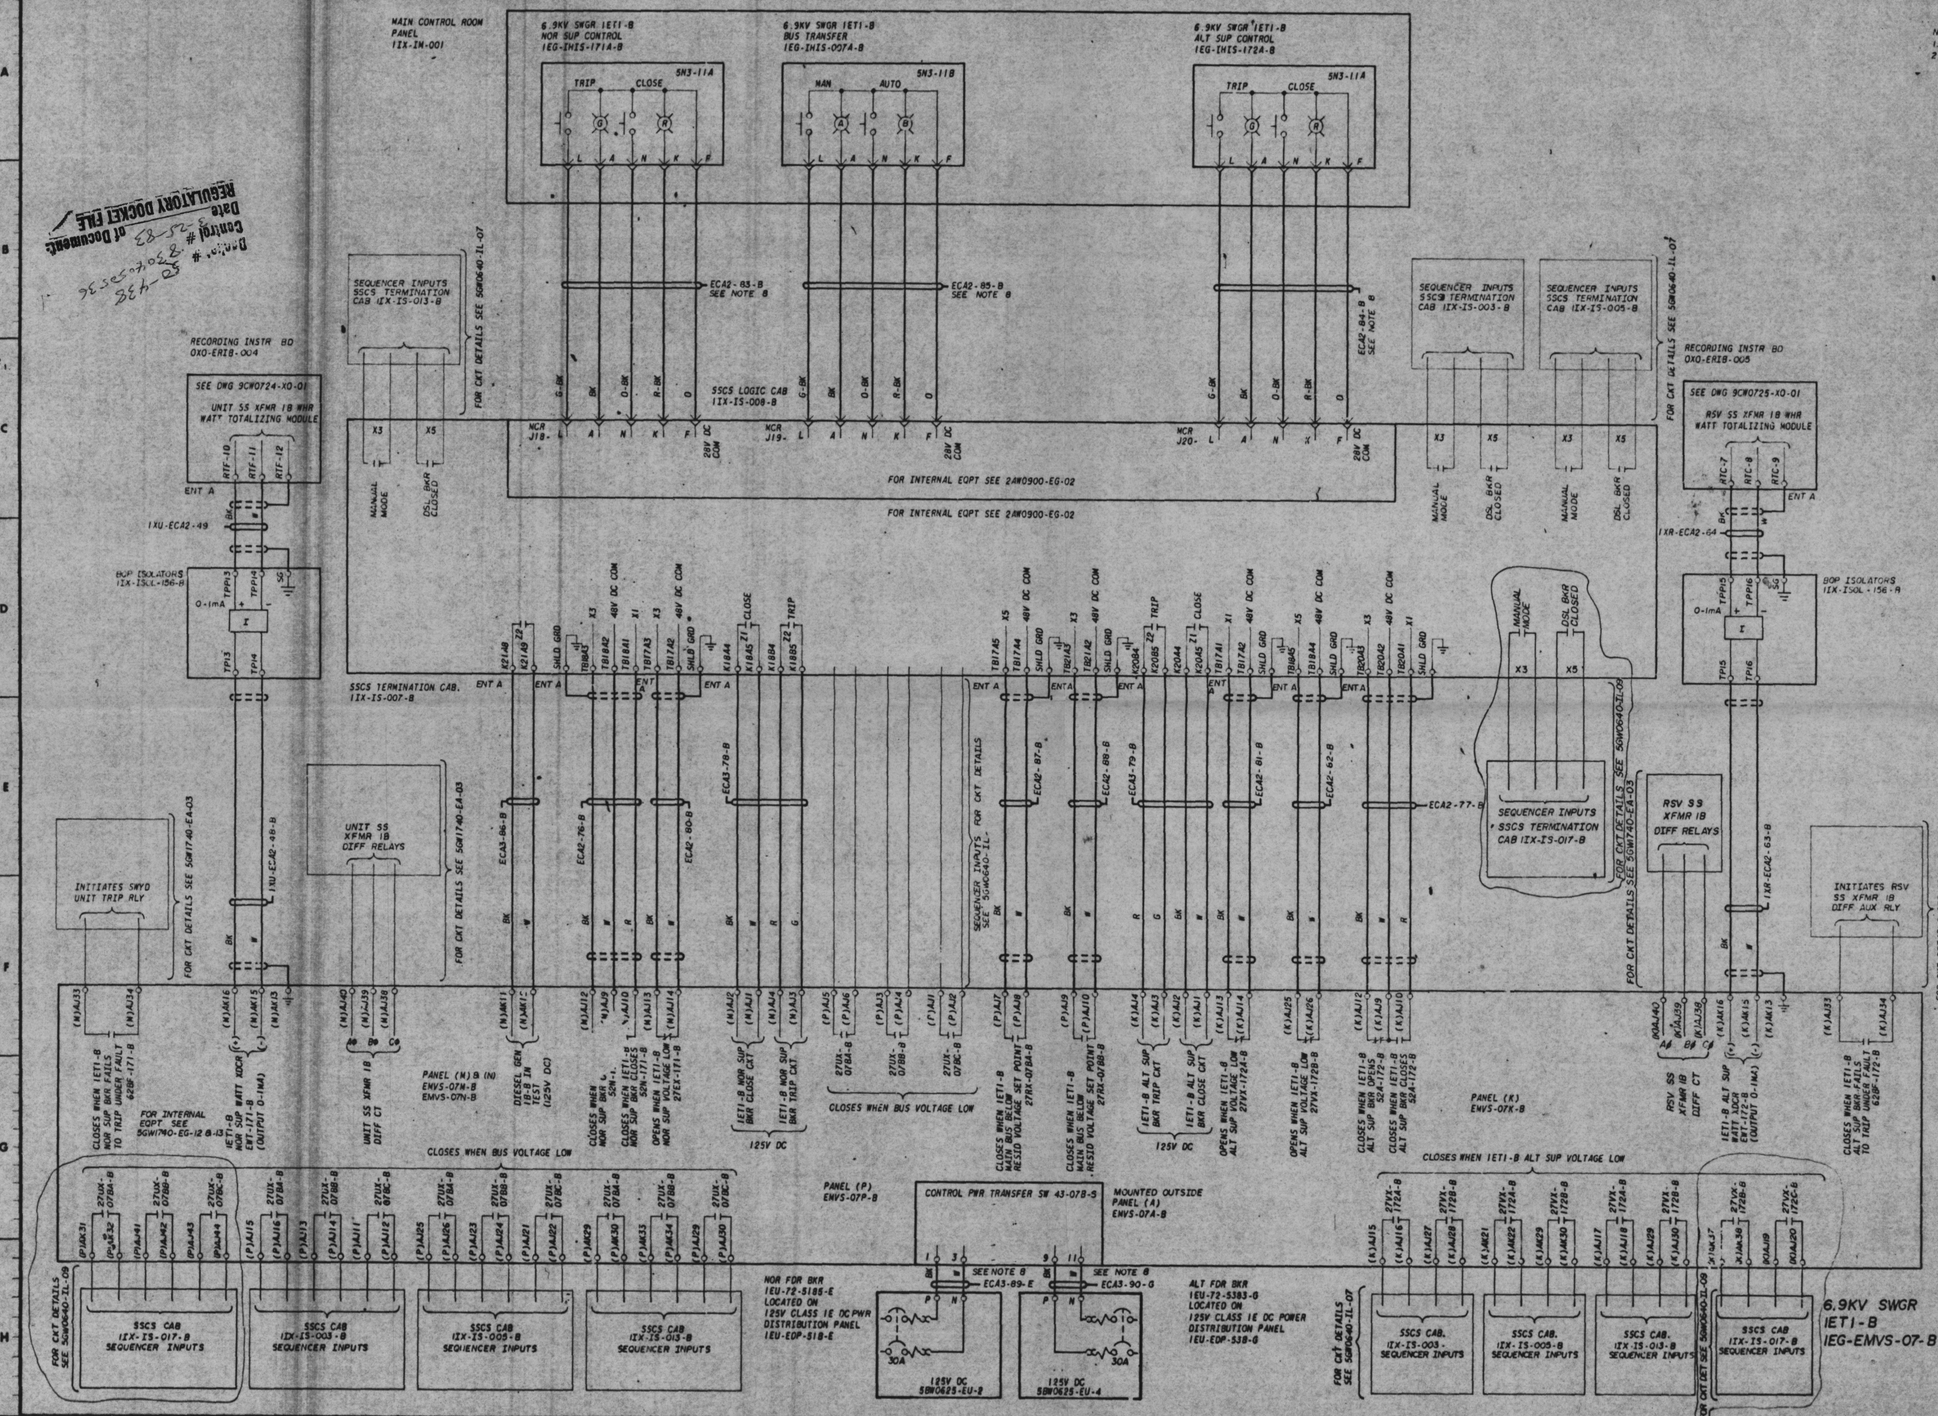

NOTES:
1. FOR GENERAL NOTES AND REFERENCE DRAWINGS SEE 5GW1740-EG-01
2. FOR MONITORING SYSTEMS DEVELOPMENT SEE 5GW1740-EG-09

PRC APERTURE CARD

REGULATORY DOCKET FILE
Control # 8304050036
Date 4-25-83
Docket # 50-438
Part of Document

3	951	4-1-77									
ADDED SSCS CAB INTERFACES.											
2	S1	1-31-77									
ADDED BOP ISOLATOR TERMINAL POINTS & SIGNAL PATHS. REMOVED COL. & EL. MINOR CHANGES.											
1	S1	7-11-74									
MINOR REVISIONS PER S1											
REV NO.	ECN NO.	DATE	DSGN	DRFN	CHKD	SUPV	ENGR	NSP	SUBM	RECM	APPD

DSGN J.C. HILL
DRFN J.W. JACKSON
CHKD L.P. WOODSON
SUPV
INSP
ENGINEER

SCALE EXCEPT AS NOTED

GENERAL
UNIT 1

SYSTEM SCHEMATIC 6.9KV CLASS 1E AC AUX POWER DISTRIBUTION SYSTEM

BELLEFONTE NUCLEAR PLANT
TENNESSEE VALLEY AUTHORITY
DIVISION OF ENGINEERING DESIGN

Q

SUBMITTED	RECOMMENDED	APPROVED

KNOXVILLE 1-17-77 88 E 5GW1740-EG-06 R3

RECORD DRAWING AS CONSTRUCTED

THIS DRAWING IS UNDER CONFIGURATION CONTROL