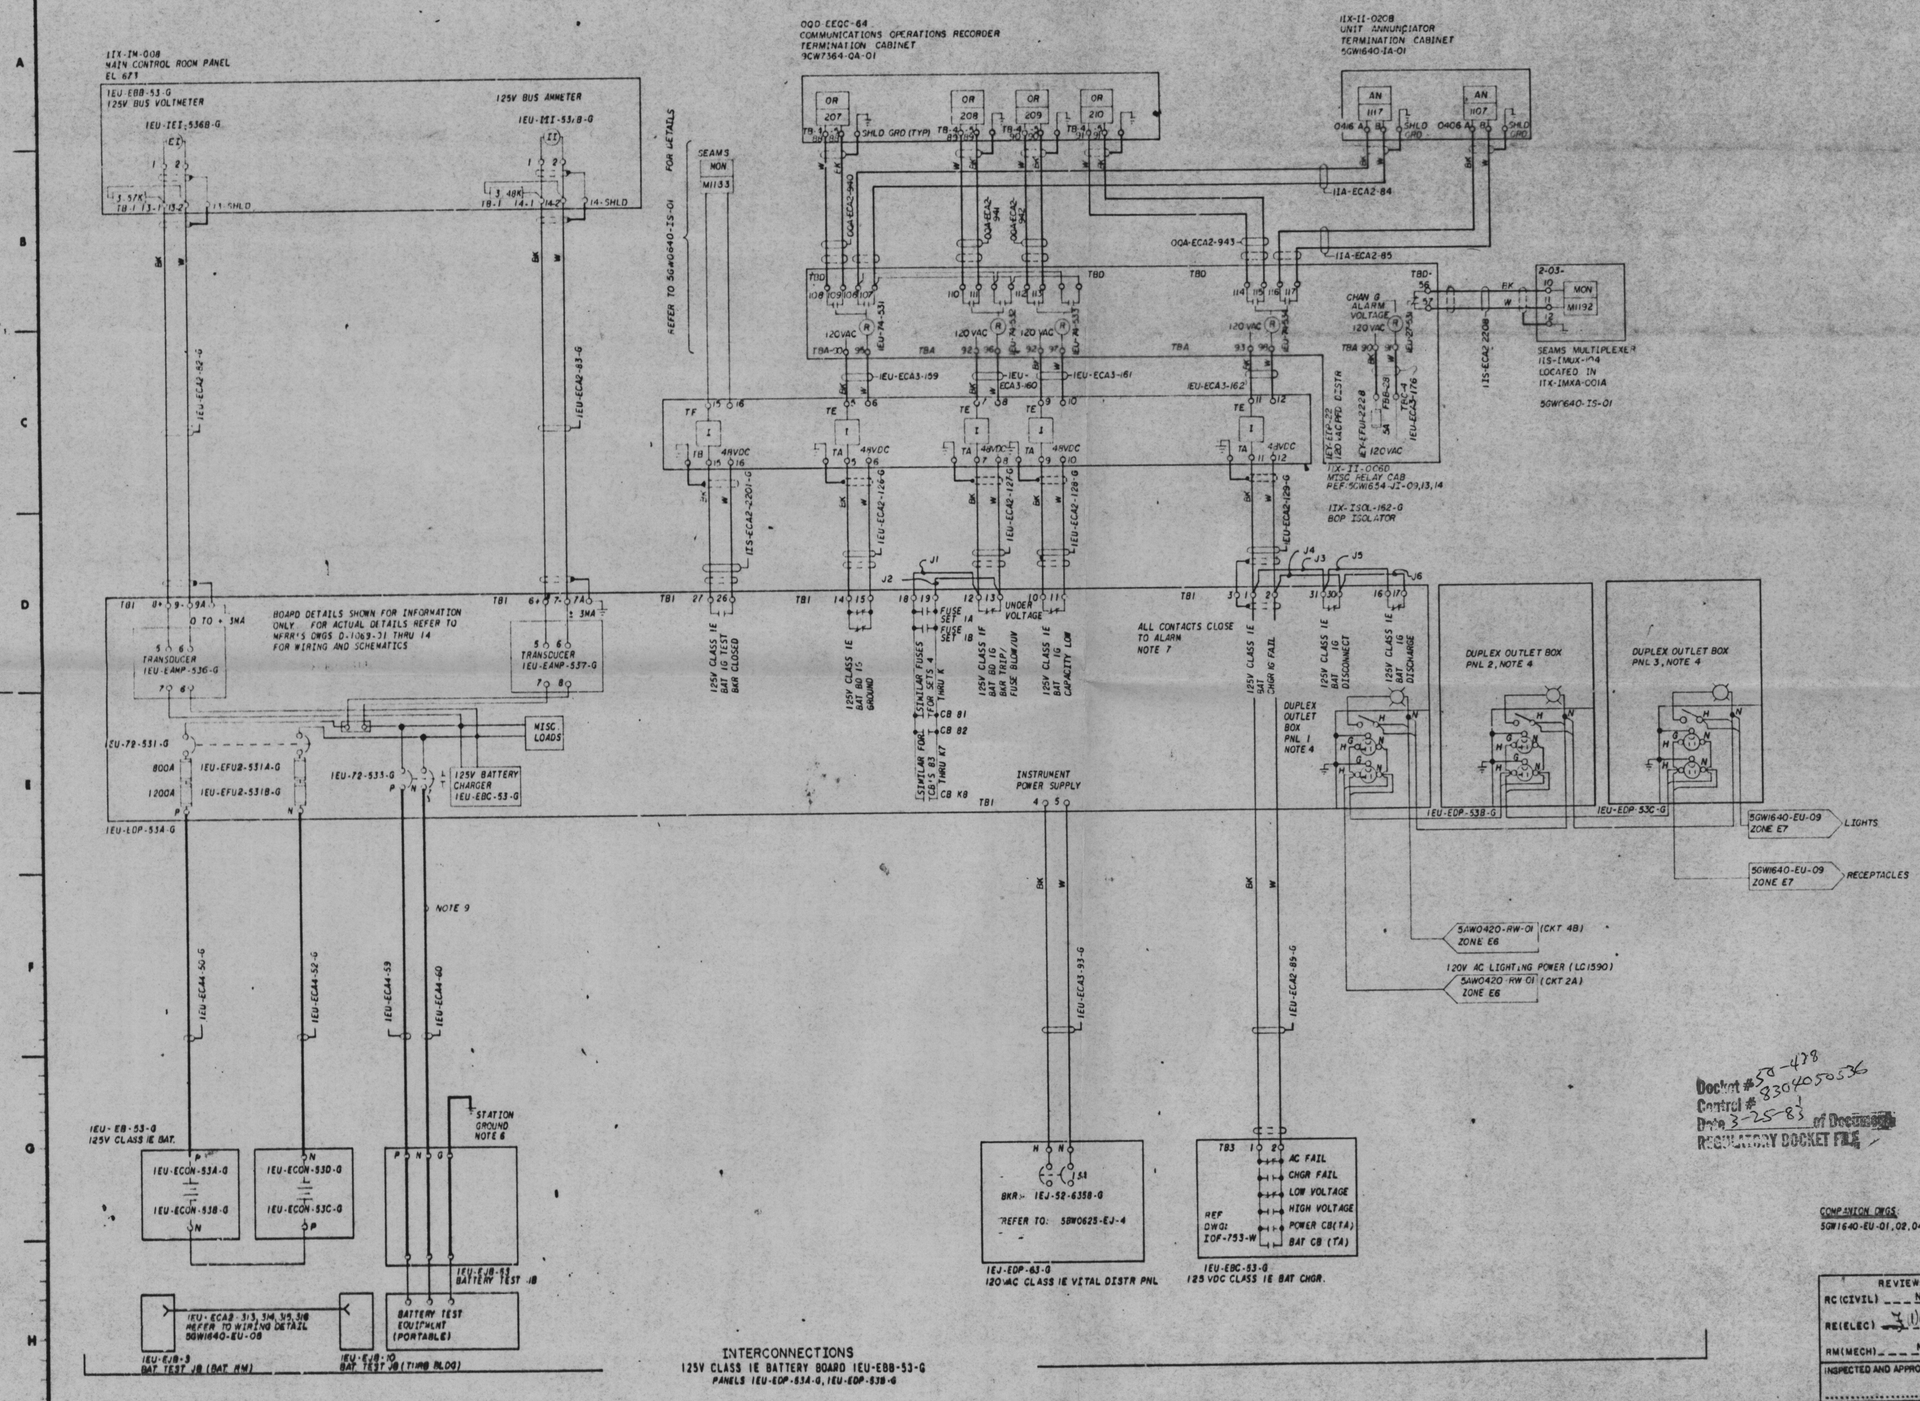

INTERCONNECTIONS
125V CLASS IE BATTERY BOARD 1EU-EBB-53-G
PANELS 1EU-EDP-53A-G, 1EU-EDP-53B-G

PRC APERTURE CARD

Docket # 50-478
Control # 8304050536
Date 3-25-83 of Document
REGULATORY DOCKET FILE

COMPANION DWGS:
5GW1640-EU-01,02,04-06,08,09

REV NO	ECN NO	DATE	DSGN	DRWN	CHKD	SUPV	ENGR	INSP	SUBM	RECM	APPD
3	SI									N/A	N/A
INCORPORATED FCR E-2314.											
2	1139, 1085	2-24-81									
INCORPORATED FCR E1743, BAT. DISCHARGE TEST EQUIP. MISC CHANGES.											
1	SI									N/A	N/A
ADDED ALARM ISOLATION DETAILS. REVISED JUMPER NO'S.											

DSGN
DRWN
CHKD
SUPV
INSP
ENGINEER

SCALE EXCEPT AS NOTED

GENERAL
UNIT 1

SCHEMATIC DIAGRAM
125V CLASS IE DC POWER DISTRIBUTION SYSTEM

BELLEFONTE NUCLEAR PLANT
TENNESSEE VALLEY AUTHORITY
DIVISION OF ENGINEERING DESIGN

Q

REVIEWED
RC(CIVIL) N/A
RE(ELEC)
RM(MECH) N/A
INSPECTED AND APPROVED FOR ISSUE

SUBMITTED | RECOMMENDED | APPROVED

KNOXVILLE 7-2-78 | 88 | E | 5GW1640-EU-07 R3

RECORD DRAWING AS CONSTRUCTED

THIS DRAWING IS UNDER CONFIGURATION CONTROL