
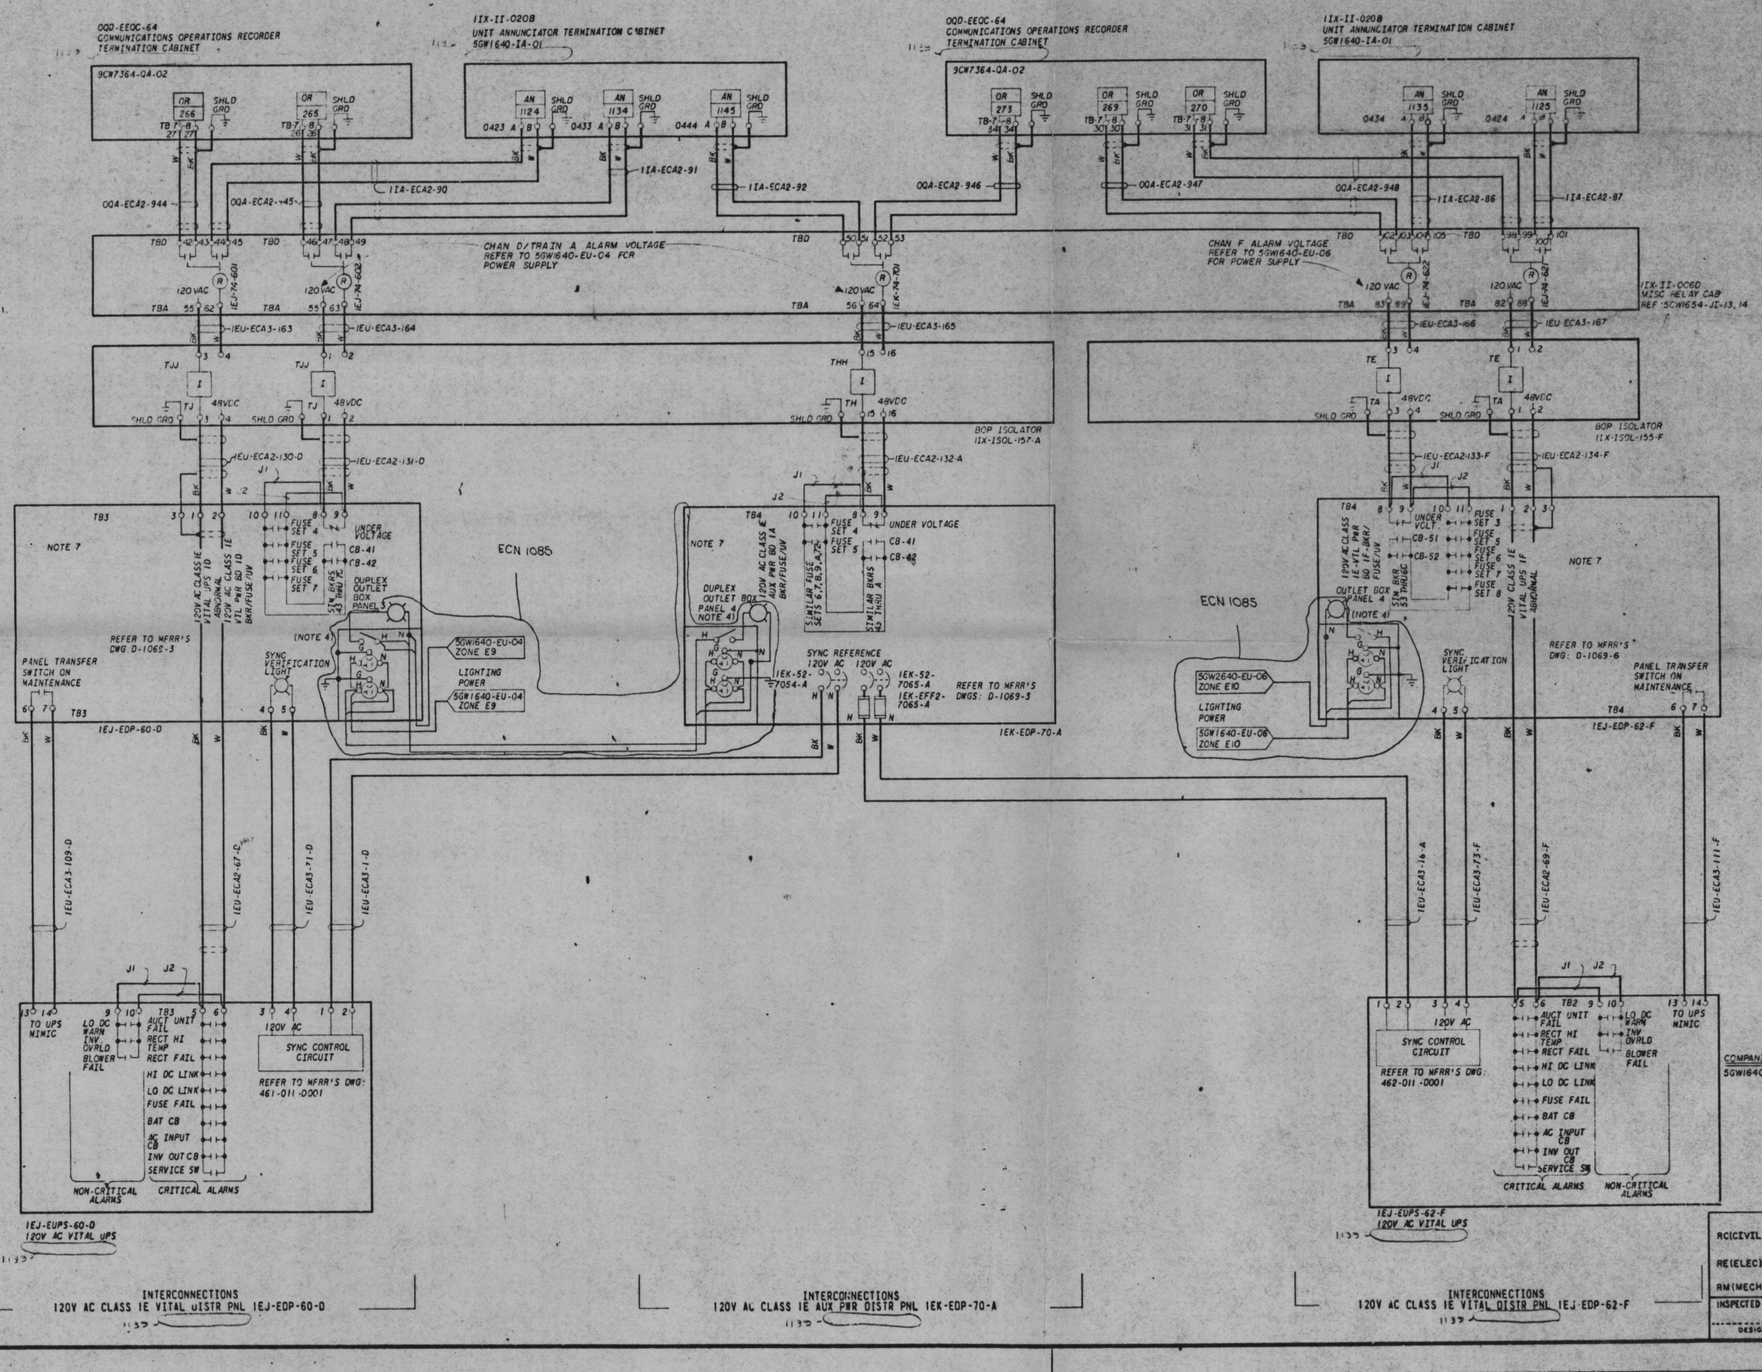

Docket # 50-438
Docket # 50-439
Date 5-25-83
REGULATORY DOCKET FILE

PRC APERTURE CARD

REV NO	ECN NO.	DATE	DSGN	DRWN	CHKD	SUPV	ENGR	INSP	SUBM	RECD	APPD
2	1085,1139	5-24-83	GP	RT	RT						
1	S1	1-11-83	GP	RT	RT						

INCORPORATED FCR E1743, MISC CHANGES.
ADDED ALARM ISOLATION DETAILS REVISED JUMPER NO'S.

DSGN G. Patterson
DRWN R. Wilson
CHKD R. Wilson
SUPV
INSP
ENGINEER M. W. Stevens

COMPANION DWGS:

GENERAL
UNIT 1


BELLEFONTE NUCLEAR PLANT
TENNESSEE VALLEY AUTHORITY
DIVISION OF ENGINEERING DESIGN

Q

SUBMITTED	RECOMMENDED	APPROVED
M. W. Stevens		


RECORD DRAWING AS CONSTRUCTED

REVIEWED
RC(CIVIL) N/A
RE(ELEC)
RM(MECH) N/A
INSPECTED AND APPROVED FOR ISSUE
DESIGN PROJECT MANAGER

PRINTS REQD-R
BR or PROJ
DWG SIZE F H
ME EE GE AD CD ED MD BP SW BL PA