9MW0545-XE-02

NOTES:
1. FOR MANUFACTURERS DRAWINGS OF ASEA RELAY, SEE TVA CONTRACT 75K2-85654.
2. FOR GENERAL NOTES SEE 9MW0545-XE-01

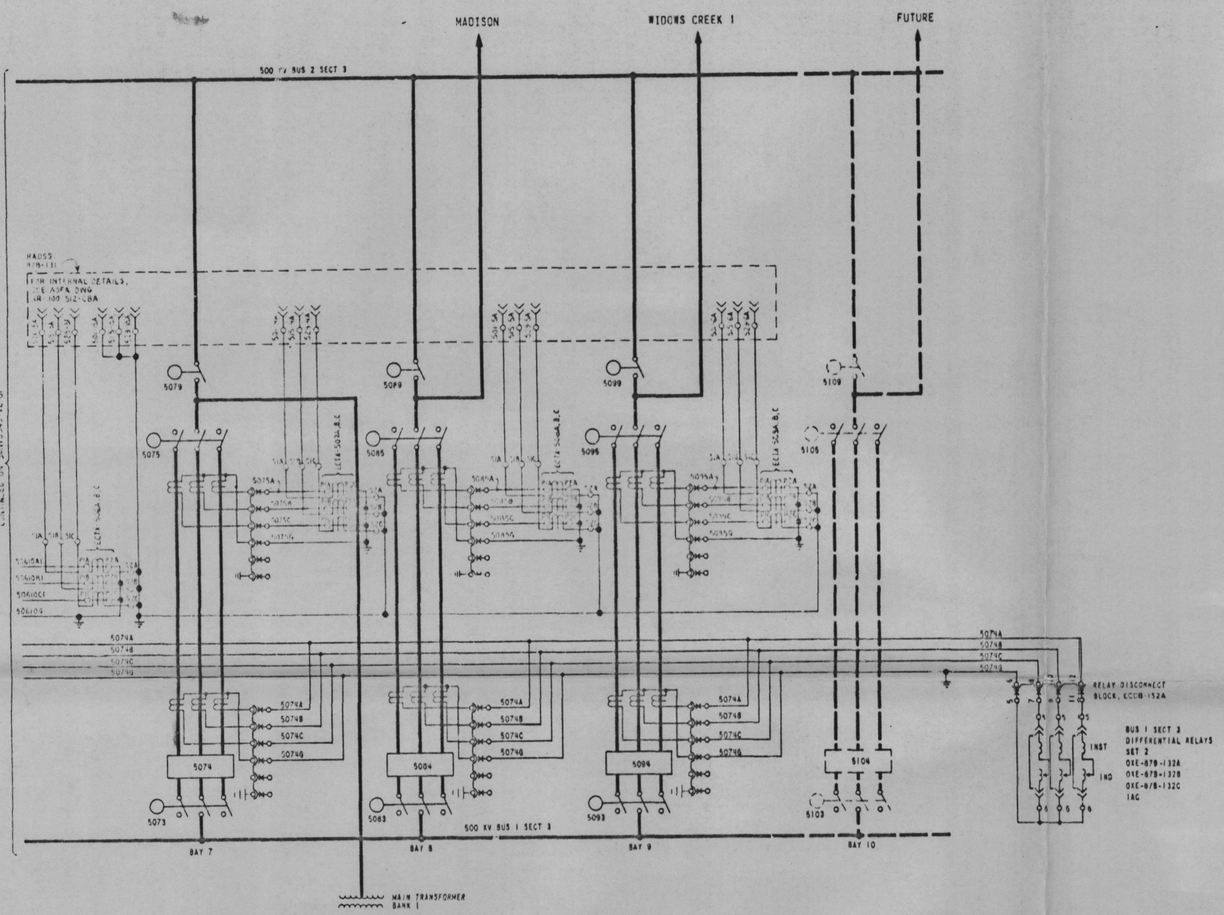

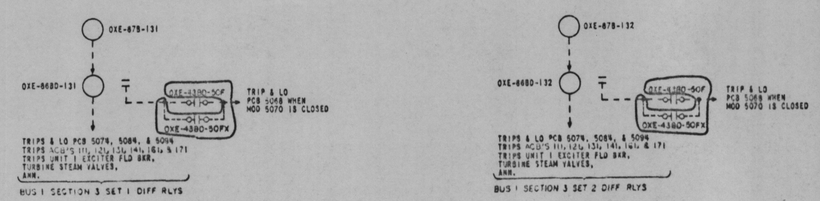

PRC APERTURE CARD

1	1196	4-25-83										
ECN-1196 MODIFY PCB 5068 FOR BUS TIE OPER, PER BLDCR-112												
REV NO.	ECN NO.	DATE	DSGN	DRWN	CHKD	SUPV	ENGR	NSP	SUBM	RECM	APPR	

DSGN D.R. TABLER / W.L. DENNIS
DRWN M.S. SHARPE
CHKD [illegible]
SUPV [illegible]
INSP
ENGINEER [illegible]

CONTROL BUILDING

WIRING DIAGRAMS
500 KV BUS DIFFERENTIAL
AC SCHEMATIC- SHEET 2

BELLEFONTE NUCLEAR PLANT
TENNESSEE VALLEY AUTHORITY
DIVISION OF ENGINEERING DESIGN

N

SUBMITTED	RECOMMENDED	APPROVED
[illegible]	R.H. Herndon	[illegible]

KNOXVILLE 7-27-76 88 1 9MW0545-XE-02 R1

RECORD DRAWING AS CONSTRUCTED

INSPECTED AND APPROVED FOR ISSUE R.M. Hodges

Docket # 50-438
Control # 8304050536
Date 3-25-83 of Document
REGULATORY DOCKET FILE