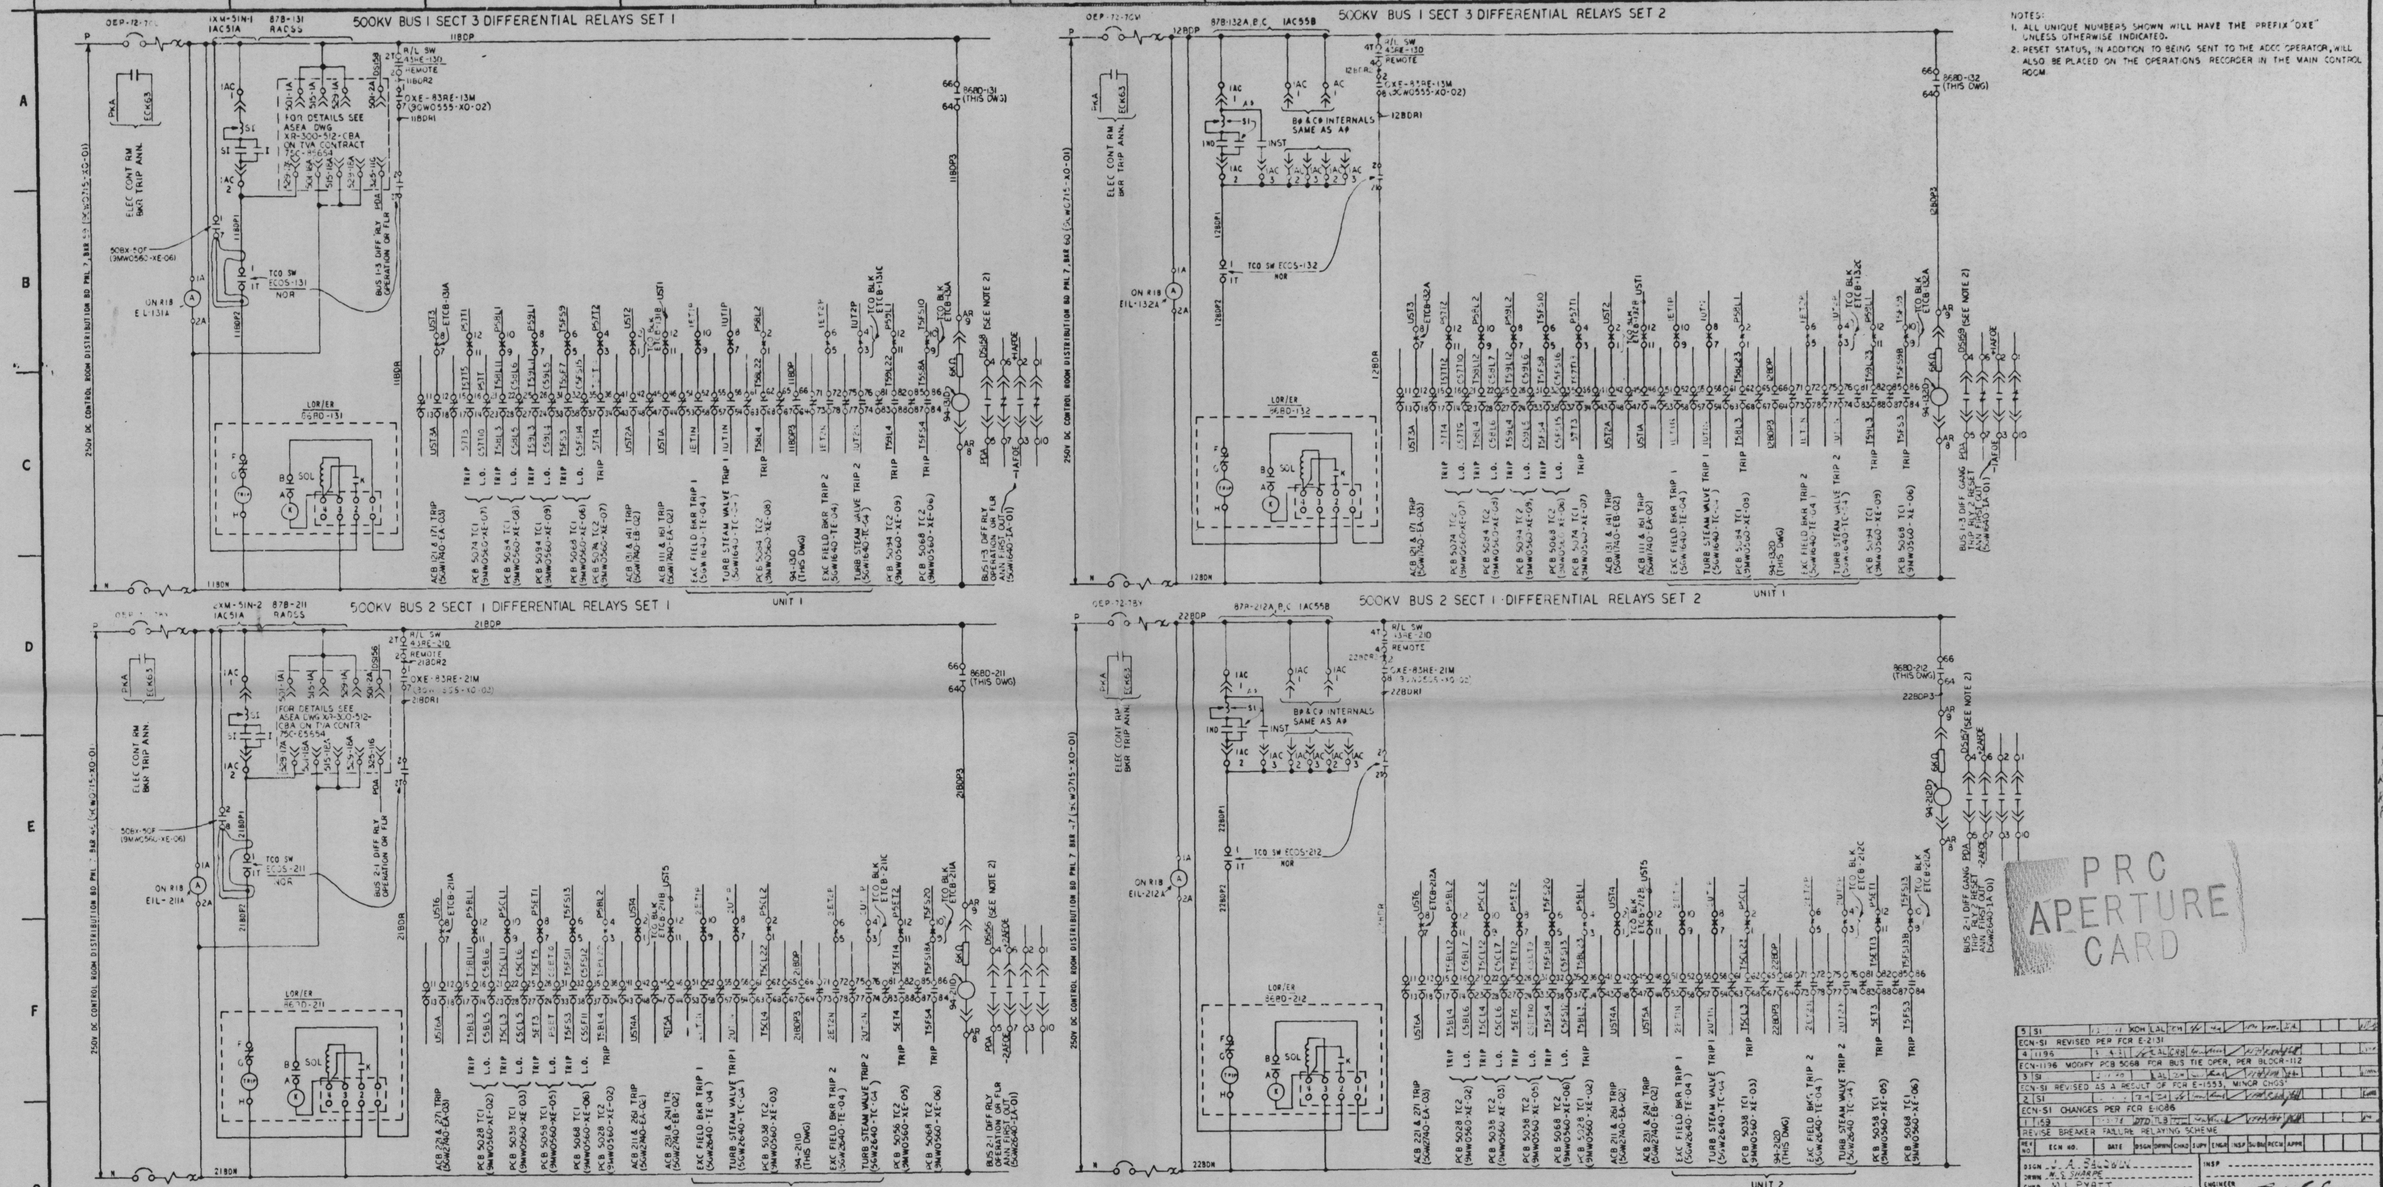


NOTES:
1. ALL UNIQUE NUMBERS SHOWN WILL HAVE THE PREFIX "DXE" UNLESS OTHERWISE INDICATED.
2. RESET STATUS, IN ADDITION TO BEING SENT TO THE ADCC OPERATOR, WILL ALSO BE PLACED ON THE OPERATIONS RECORDER IN THE MAIN CONTROL ROOM.

PRC APERTURE CARD

| REV NO | ECN NO. | DATE | DSGN | DRWN | CHKD | SUPV | ENGR | NSP | SUBR | RECD | APPR |
|---|---|---|---|---|---|---|---|---|---|---|---|
| 5 | S1 | | | | | | | | | | |
| 4 | 11196 | | | | | | | | | | |
| 3 | 19 | | | | | | | | | | |
| 2 | S1 | | | | | | | | | | |
| 1 | 158 | | | | | | | | | | |

ECN-S1 REVISED PER FCR E-2131
ECN-11196 MODIFY PCB 5068 FOR BUS TIE OPER. PER BLOCK-112
ECN-S1 REVISED AS A RESULT OF FCR E-1553, MINOR CHGS
ECN-S1 CHANGES PER FCR E-1086
REVISE BREAKER FAILURE RELAYING SCHEME

DSGN J. A. SALADA
DRWN K. L. JONES
CHKD J. L. PYATT
SUPV
INSP
ENGINEER

CONTROL BUILDING

WIRING DIAGRAM
250 VDC MAIN CONTROL SCHEMATIC
500 KV BUS DIFFERENTIAL RELAYS

BELLEFONTE NUCLEAR PLANT
TENNESSEE VALLEY AUTHORITY
DIVISION OF ENGINEERING DESIGN

N

| SUBMITTED | RECOMMENDED | APPROVED |
|---|---|---|
| Robert F. Hewitt | R. H. Herndon | John E. Wallace |

KNOXVILLE 11-8-76 | 88 | E | 9MW0556-XE-01 R8

RECORD DRAWING AS CONSTRUCTED

THIS DRAWING IS UNDER CONFIGURATION CONTROL

INSPECTED AND APPROVED FOR ISSUE

Docket # 50-438
Control # 8304050536
Date 3-25-83 of Document
REGULATORY DOCKET FILE

PRINTS REQD → 5
BR of PROJ

| | FMS | SIZE |
|---|---|---|
| ME | | |
| EE | 3 | |
| CE | | |
| AD | | |
| CO | | |
| ED | 1 | |
| MO | | |
| BY | | |
| SW | | |
| BL | | |
| PA | | |