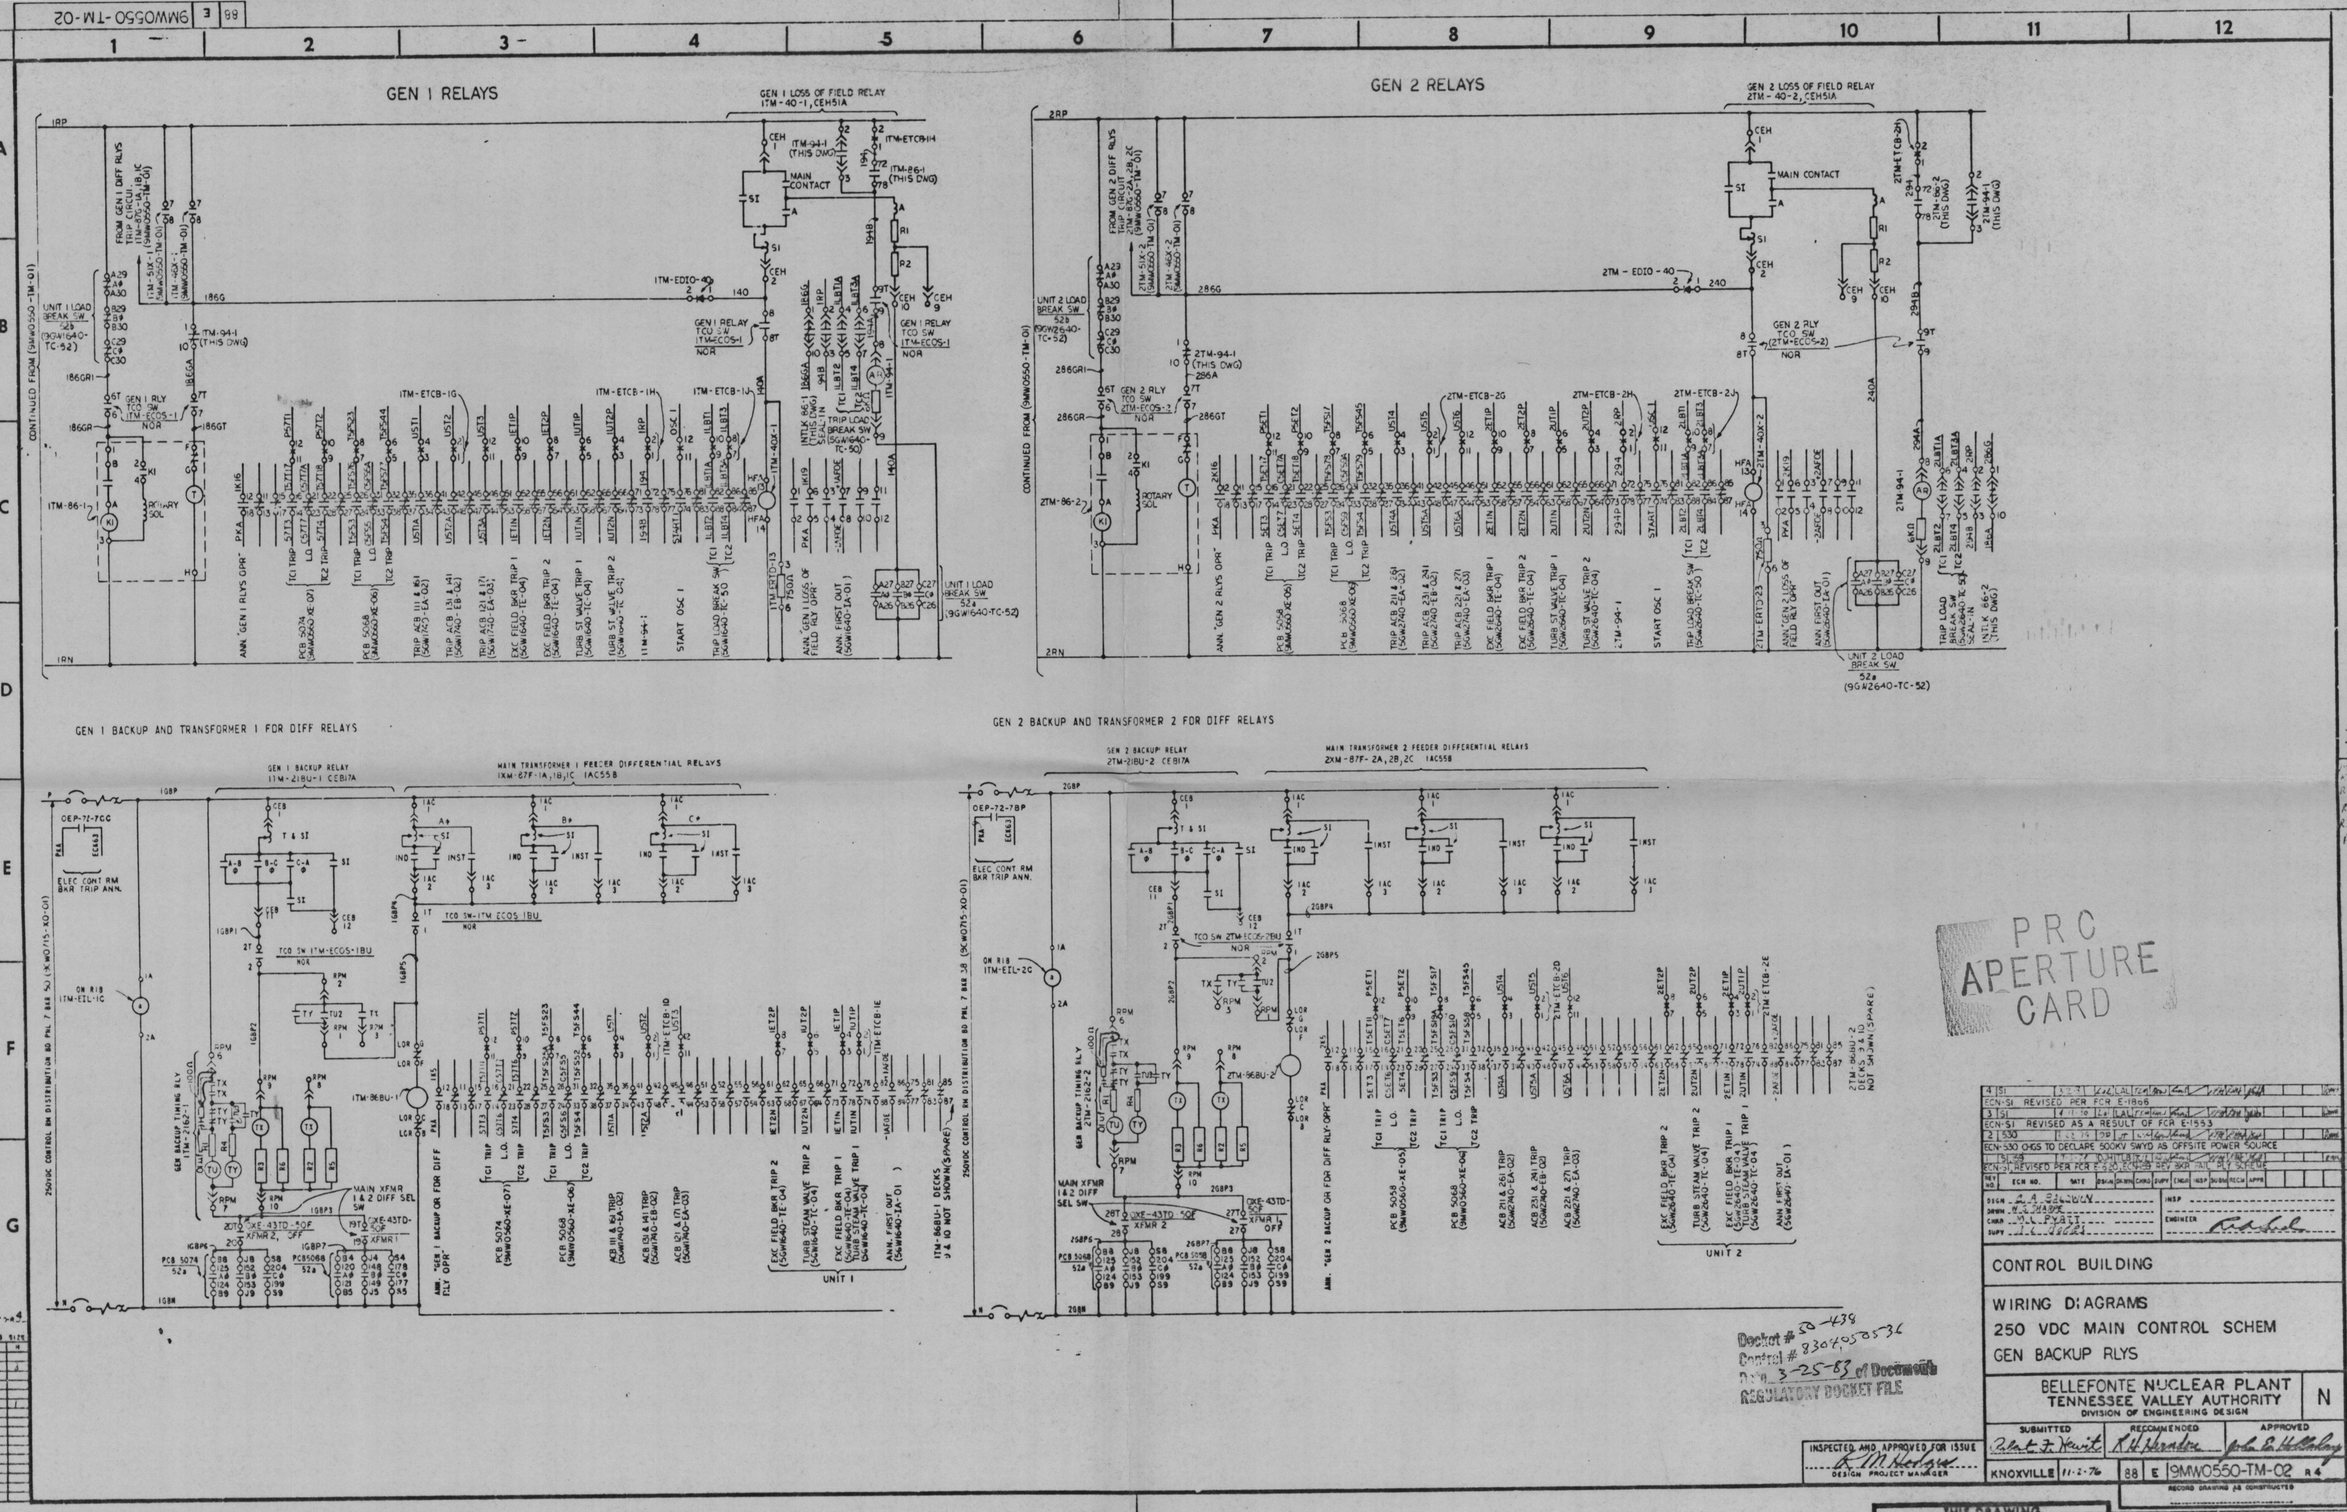

GEN 1 RELAYS
GEN 2 RELAYS
GEN 1 BACKUP AND TRANSFORMER 1 FOR DIFF RELAYS
GEN 2 BACKUP AND TRANSFORMER 2 FOR DIFF RELAYS
GEN 1 LOSS OF FIELD RELAY
GEN 2 LOSS OF FIELD RELAY
MAIN CONTACT
UNIT 1
UNIT 2
PRC APERTURE CARD
Docket # 50-438
Control # 8304050536
Date 3-25-83 of Document
REGULATORY DOCKET FILE
CONTROL BUILDING
WIRING DIAGRAMS
250 VDC MAIN CONTROL SCHEM
GEN BACKUP RLYS
BELLEFONTE NUCLEAR PLANT
TENNESSEE VALLEY AUTHORITY
DIVISION OF ENGINEERING DESIGN
N
SUBMITTED
RECOMMENDED
APPROVED
KNOXVILLE 11-2-76
88 E 9MW0550-TM-02 R4
RECORD DRAWING AS CONSTRUCTED
INSPECTED AND APPROVED FOR ISSUE
DESIGN PROJECT MANAGER
THIS DRAWING IS UNDER CONFIGURATION CONTROL