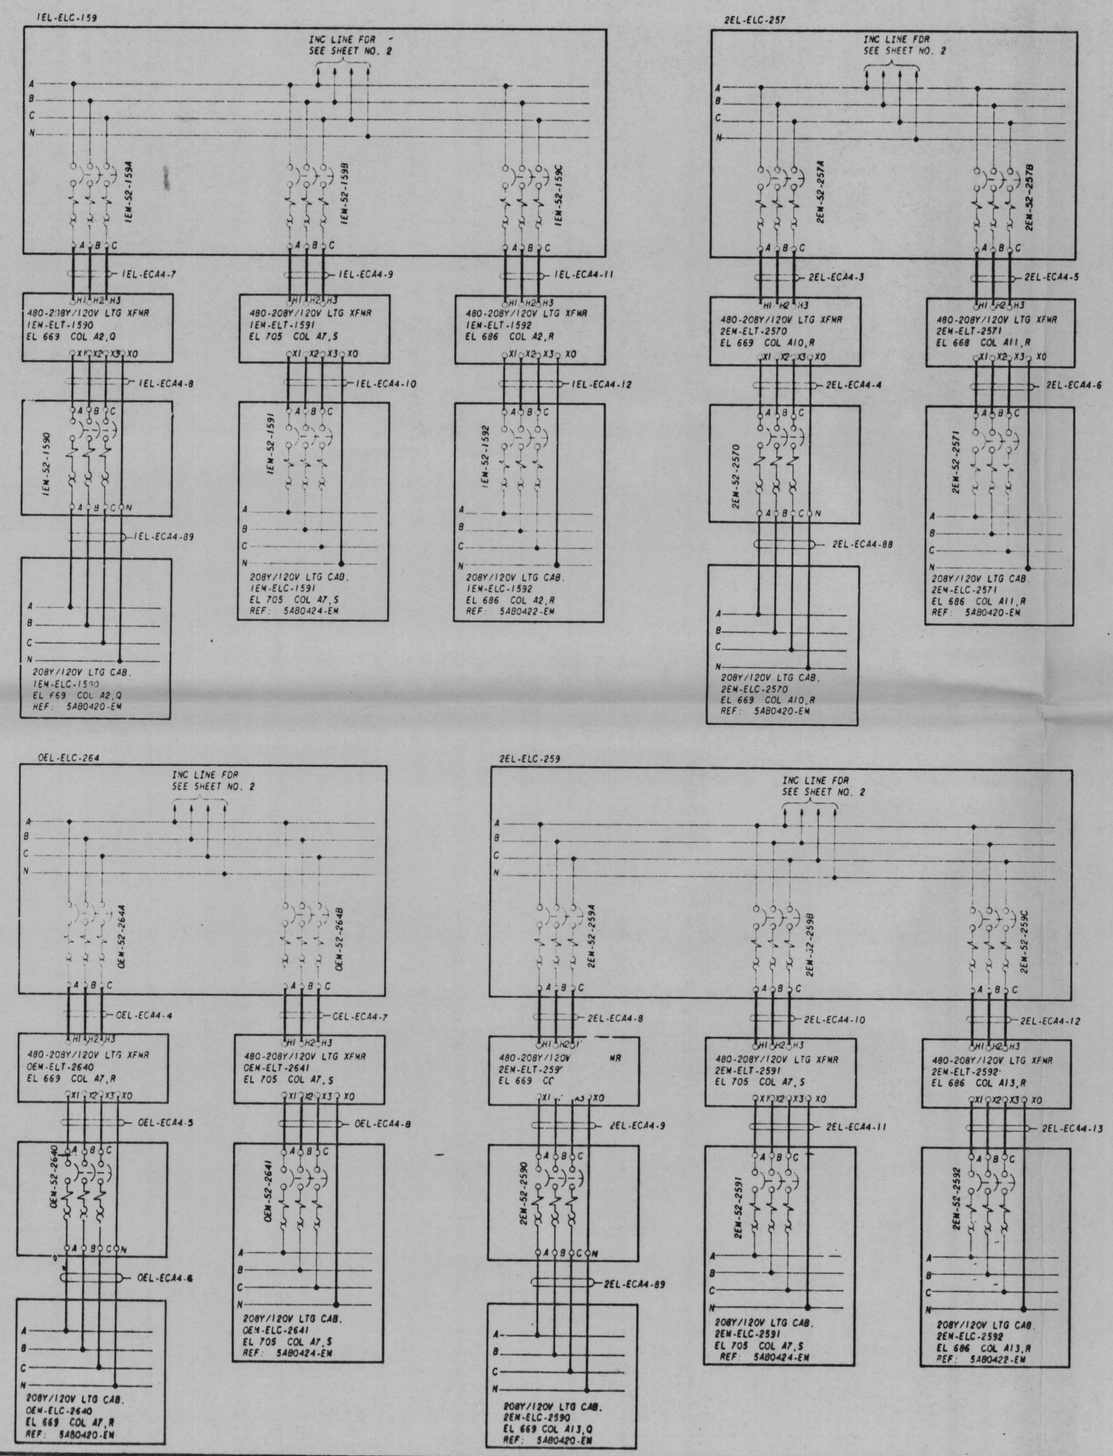

NOTES:
1. FOR GENERAL NOTES AND SYMBOLS SEE DWG 5GW0747-EL-01.

480V LIGHTING CABINET
BRANCH FEEDERS FOR
208Y/120V LIGHTING SYSTEM

PRC APERTURE CARD

Docket # 50-438
Control # 8304050536
Date 3-25-83 of Documents
REGULATORY DOCKET FILE

REV NO	ECN NO	DATE	DSGN	DRWN	CHKD	SUPV	ENGR	NSP	SUBM	RECM	APPD

DSGN
DRWN
CHKD
SUPV
NSP
ENGINEER

SCALE EXCEPT AS NOTED

GENERAL
UNITS 1 & 2

WIRING DIAGRAM NORMAL AC LIGHTING FEEDERS

BELLEFONTE NUCLEAR PLANT
TENNESSEE VALLEY AUTHORITY
DIVISION OF ENGINEERING DESIGN

N

SUBMITTED | RECOMMENDED | APPROVED

INSPECTED AND APPROVED FOR ISSUE

KNOXVILLE 2-9-78 | 88 | E | 5GW0747-EL-03 | R0

RECORD DRAWING AS CONSTRUCTED